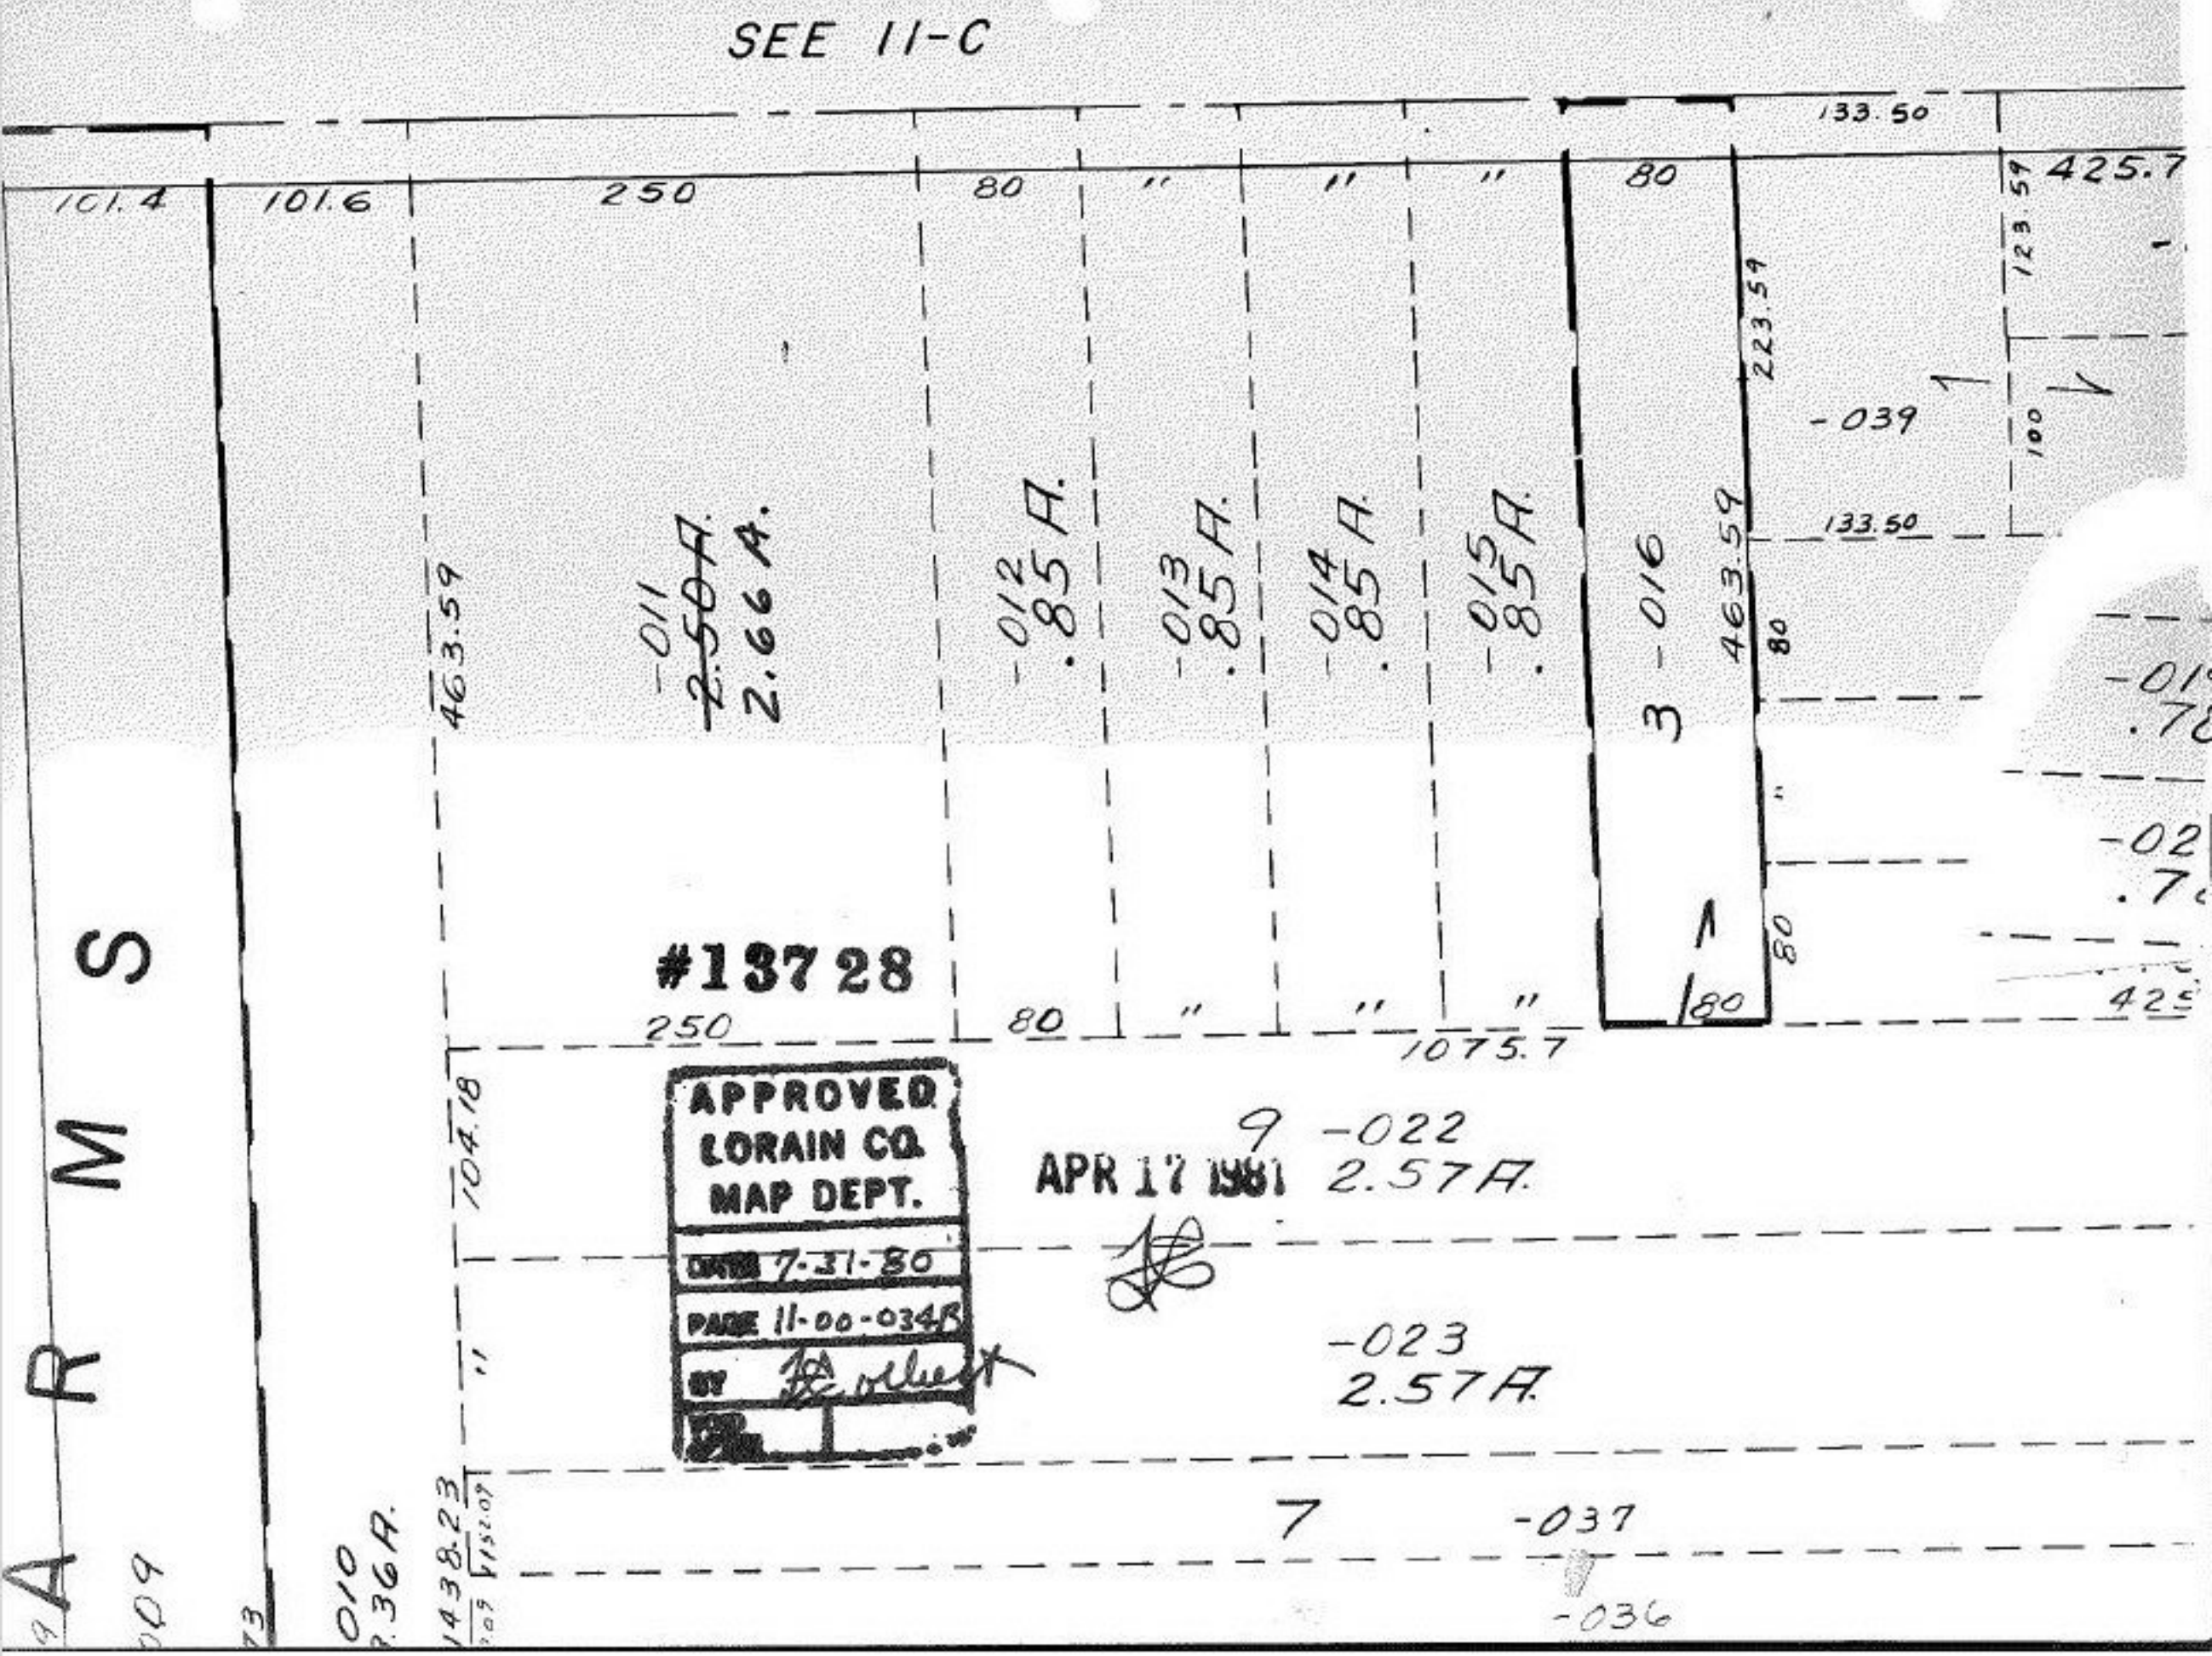
SEE 11-C
133.50
101.4
101.6
250
80
"
"
"
80
425.7
123.59
223.59
-039
100
133.50
463.59
-011
~~2.50 A.~~
2.66 A.
-012
.85 A.
-013
.85 A.
-014
.85 A.
-015
.85 A.
3 -016
463.59
80
80
80
#13728
250
80
"
"
"
80
1075.7
104.18
9 -022
2.57 A.
APPROVED
LORAIN CO.
MAP DEPT.
DATE 7-31-80
PAGE 11-00-034B
BY
APR 17 1981
-023
2.57 A.
7
-037
-036
A R M S
1438.23
1152.09
010
.36 A.