9.78 A.

VOID NEVER TRANSFERED OR RECORDED 5-27-88

SEE #17969-A

TAKEN FROM MAP. DEPT. BY Rich Buzas

#13730
#13729

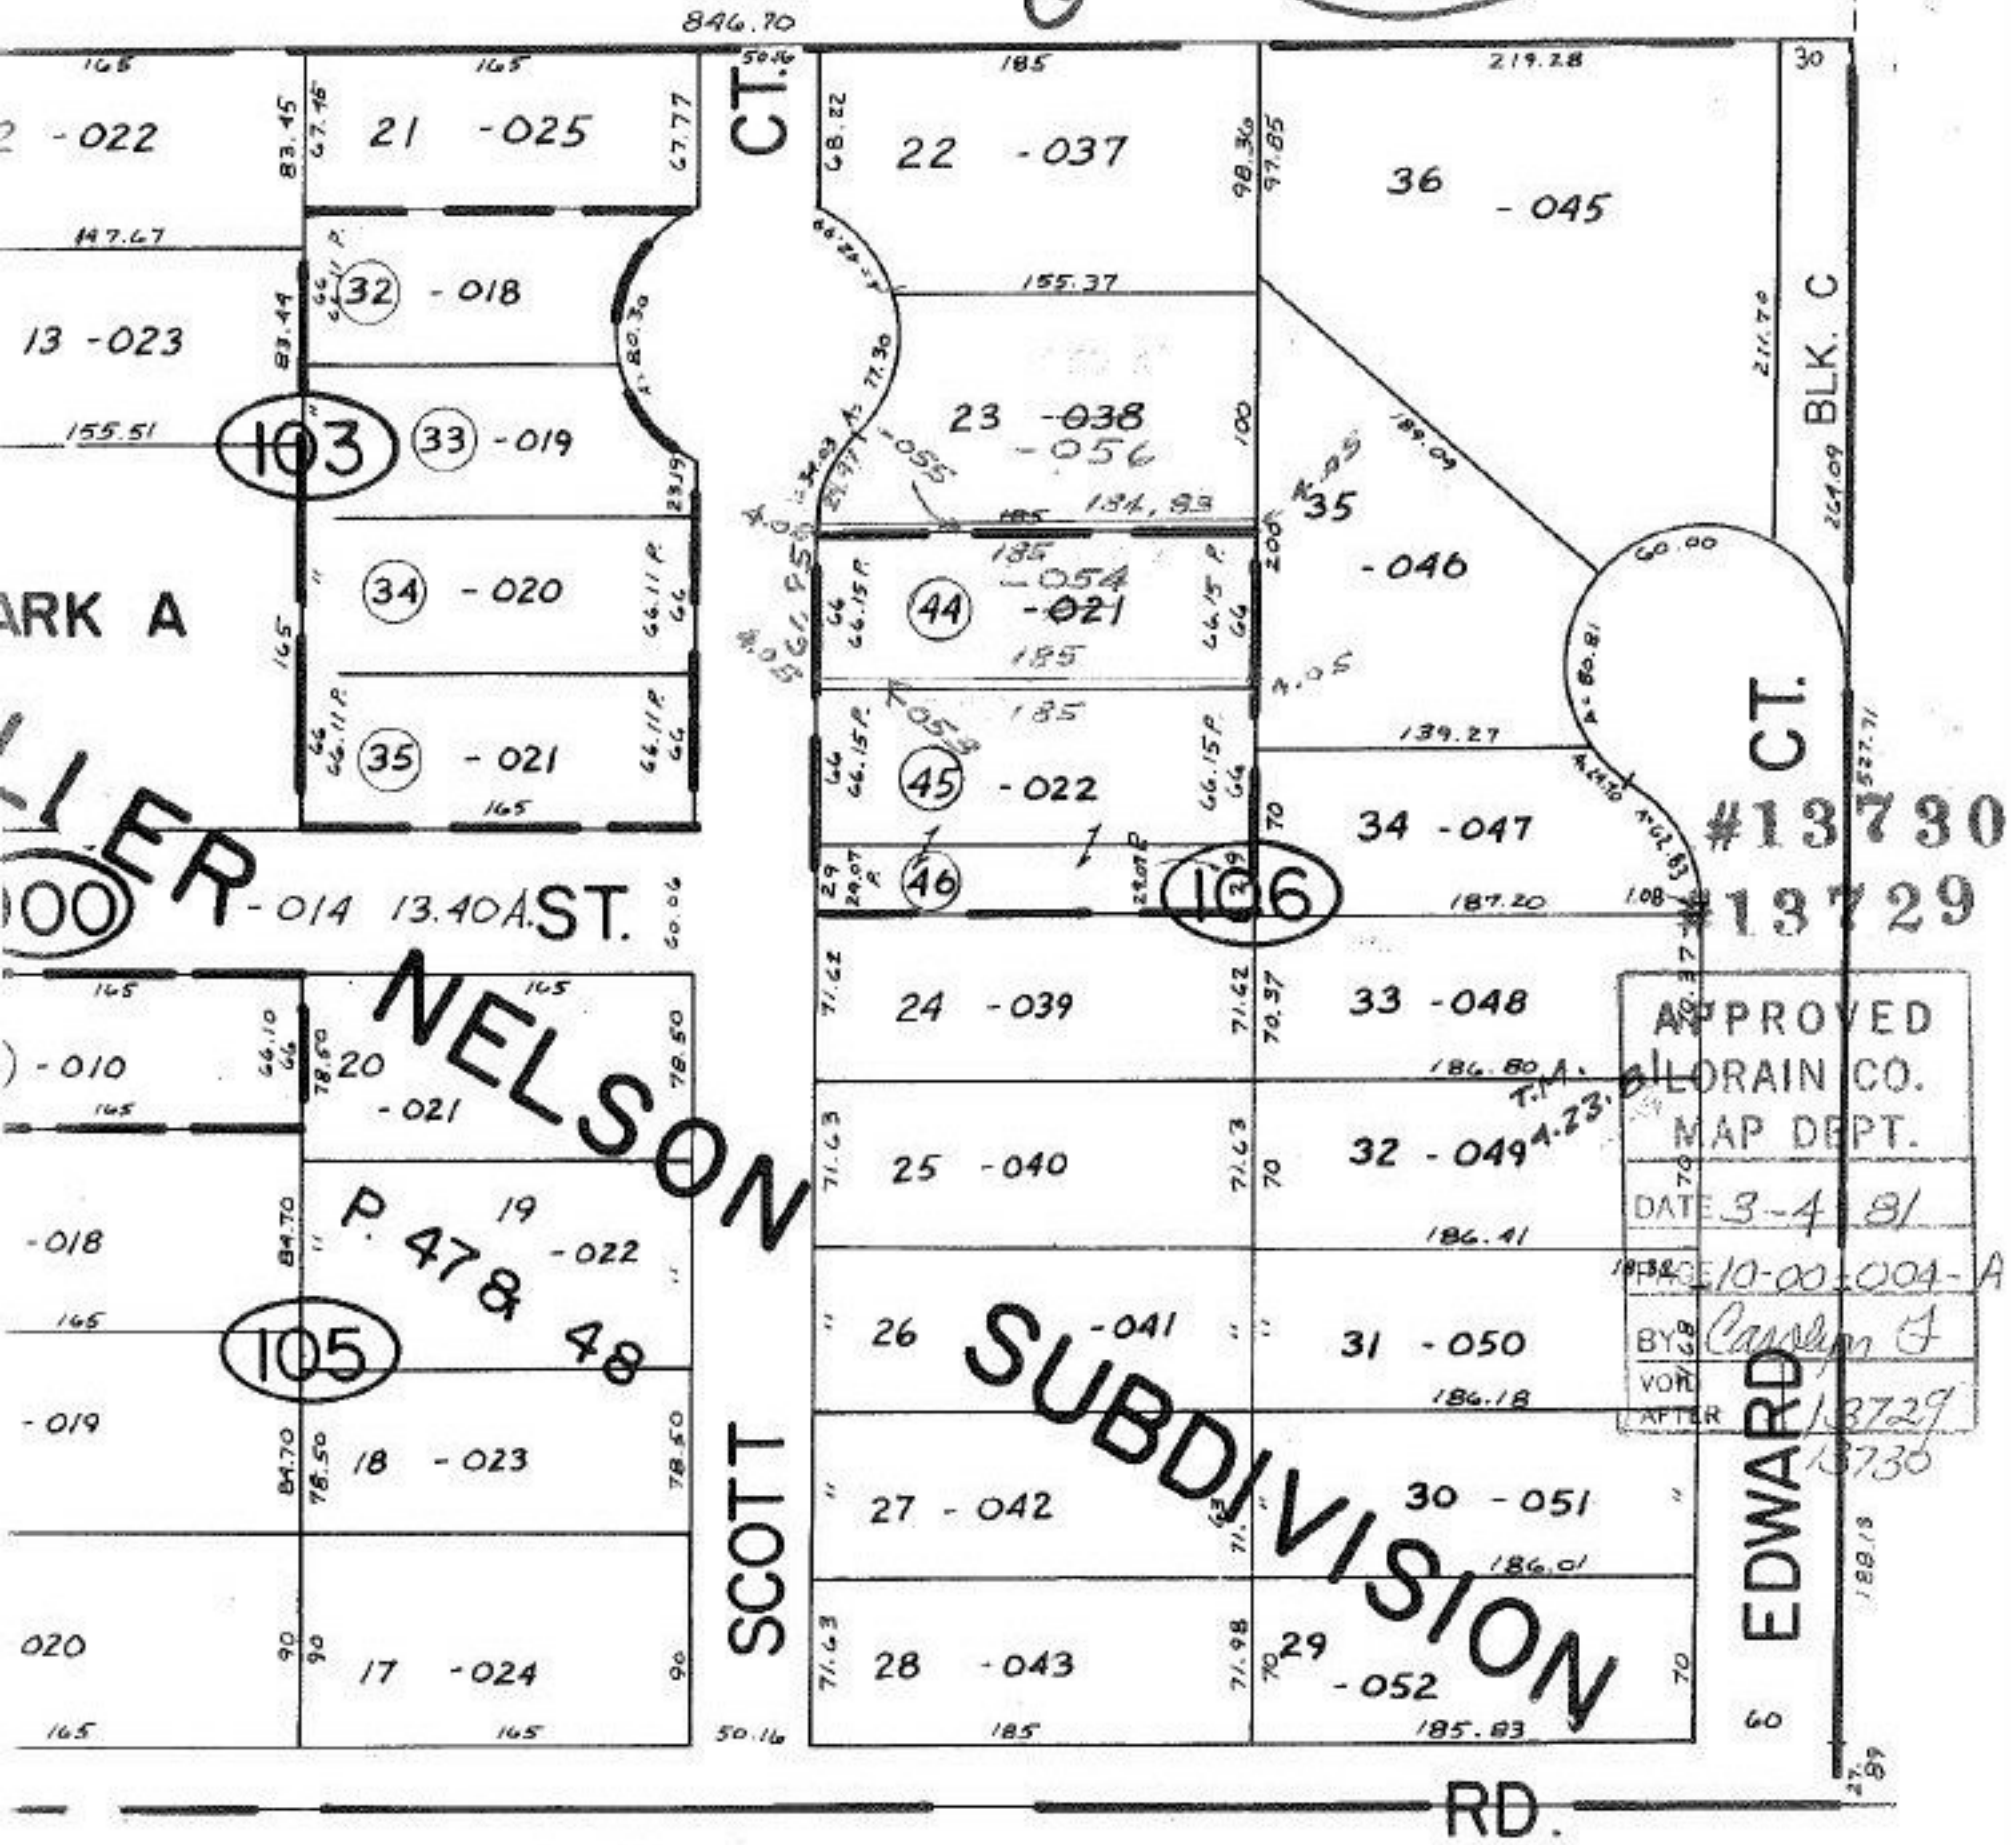

APPROVED
LORAIN CO.
MAP DEPT.
DATE 3-4-81
PAGE 10-00-004-A
BY Carolyn G
VOID AFTER 13729
13730

SEE 10-00-004-E