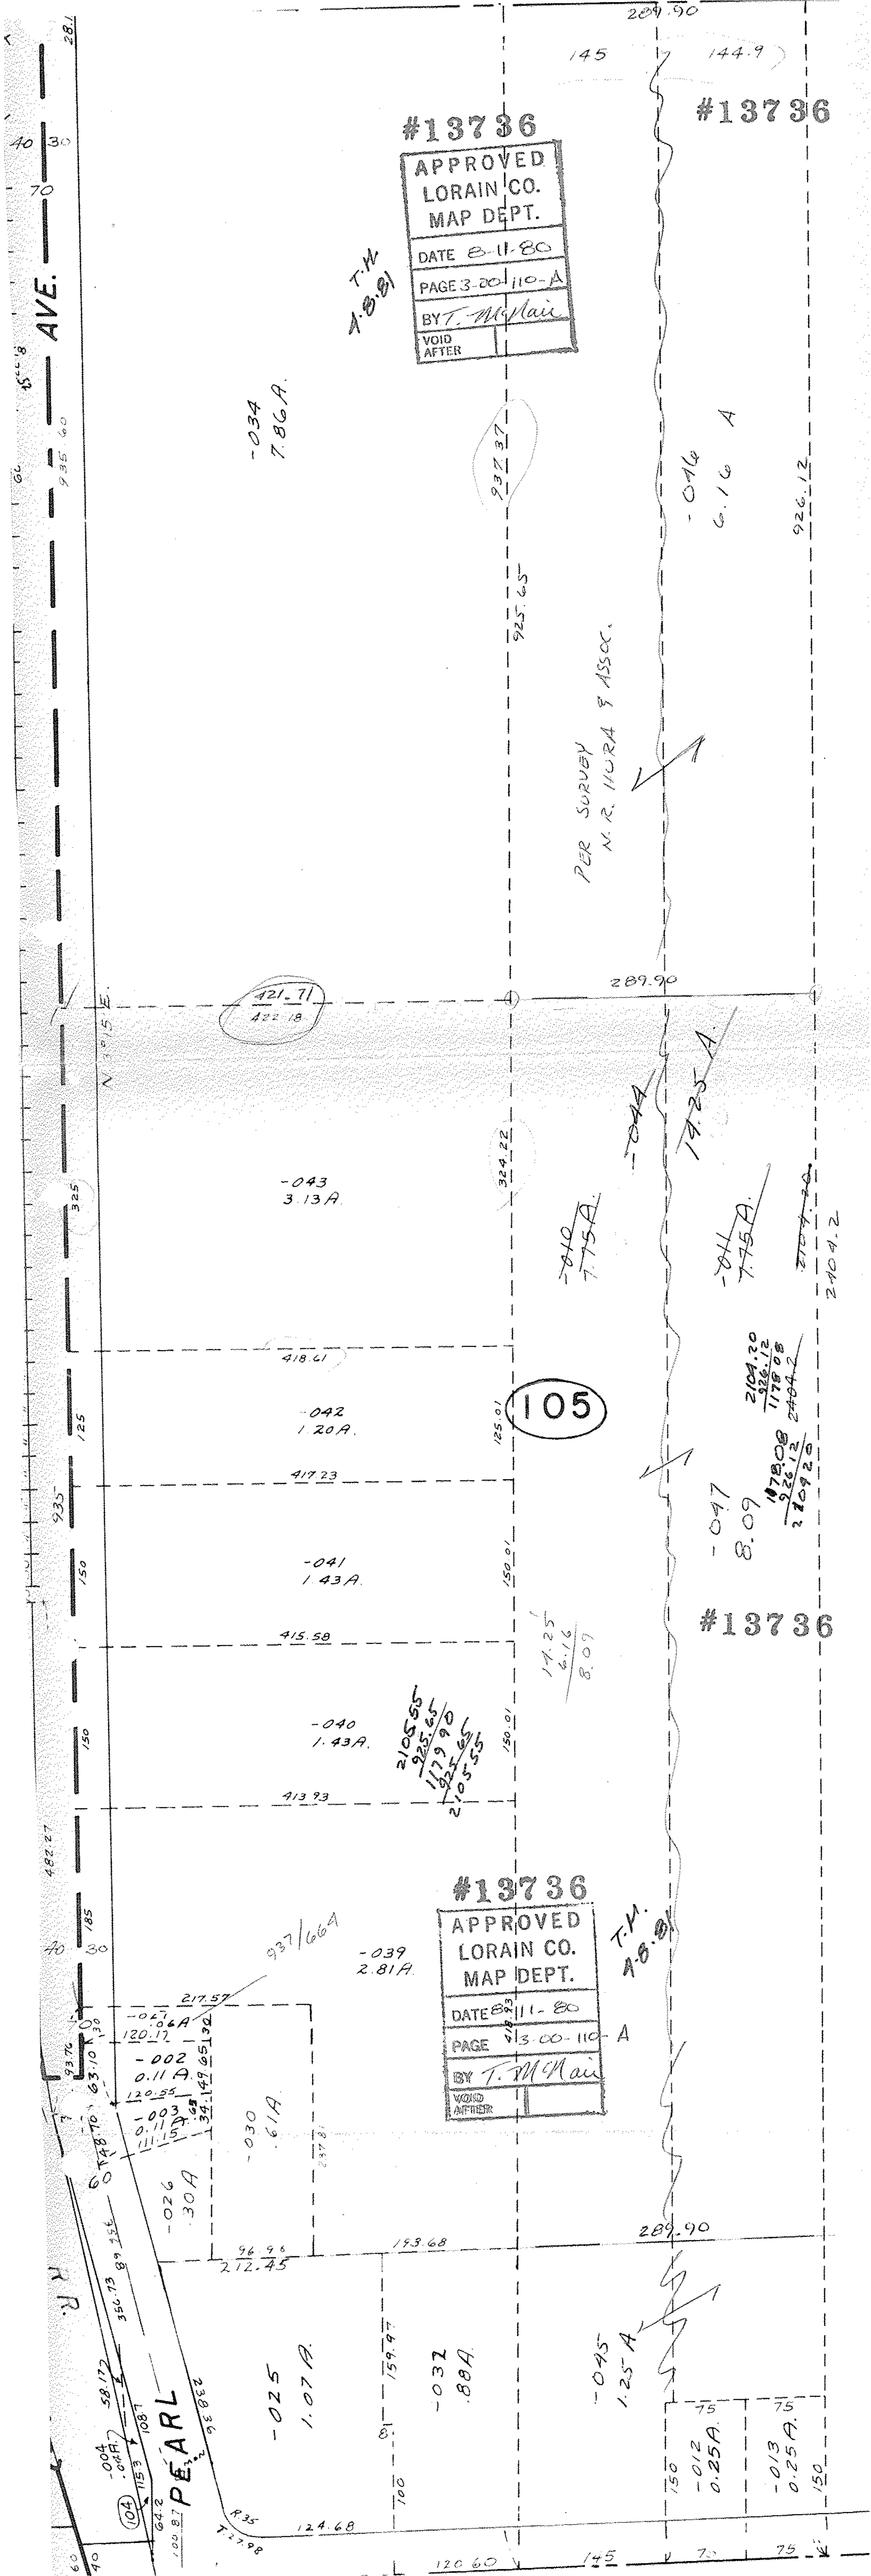
#13736
APPROVED
LORAIN CO.
MAP DEPT.
DATE 8-11-80
PAGE 3-001 110-A
BY T. McNair
VOID AFTER
#13736
#13736
APPROVED
LORAIN CO.
MAP DEPT.
DATE 8-11-80
PAGE 3-001 110-A
BY T. McNair
VOID AFTER
#13736
AVE.
PEARL
R.R.
105
104
-034 7.86A.
-043 3.13A.
-042 1.20A.
-041 1.43A.
-040 1.43A.
-039 2.81A.
-026 .30A.
-027 .06A.
-002 0.11 A.
-003 0.11 A.
-030 .61A.
-025 1.07A.
-032 .88A.
-045 1.25 A.
-004 .04A.
-012 0.25A.
-013 0.25A.
-046 6.16 A.
-044 7.75A.
-047 8.09
PER SURVEY N.R. HURA & ASSOC.
289.90
925.65
926.12
324.22
418.61
417.23
415.58
413.93
217.57
212.45
193.68
289.90
124.68
120.60
145
144.9