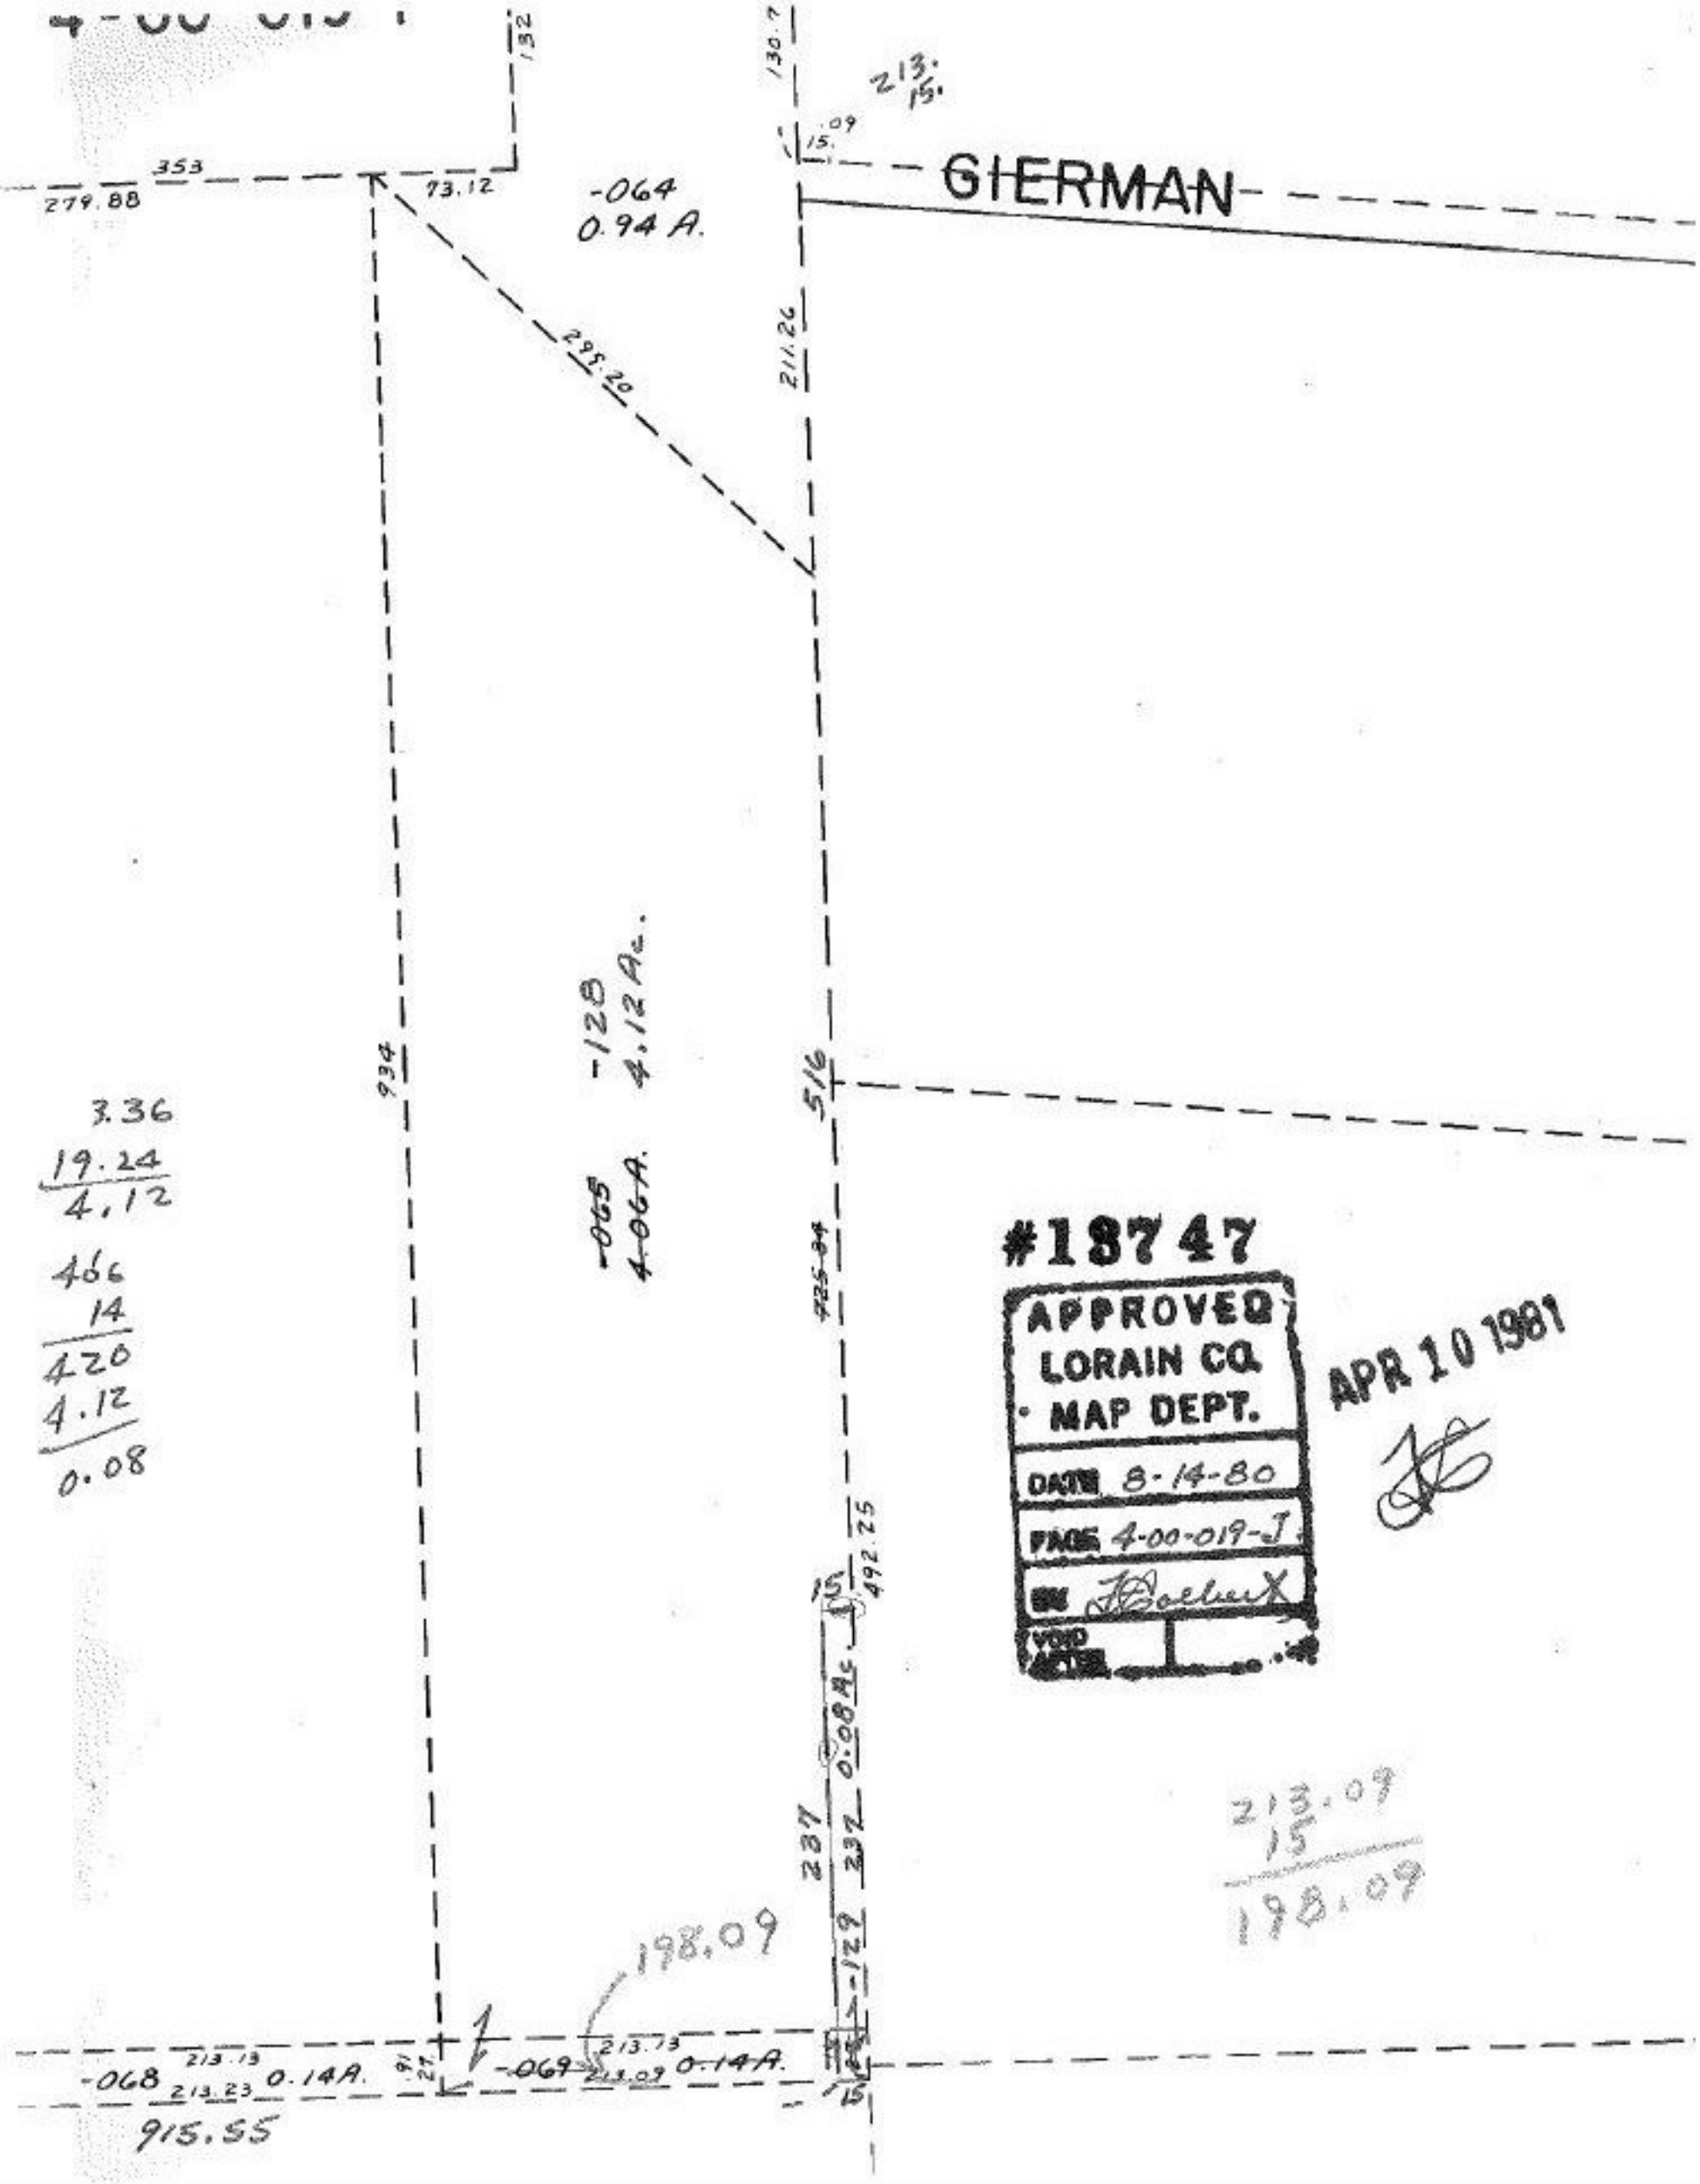

#18747
APPROVED
LORAIN CO.
MAP DEPT.
DATE 8-14-80
PAGE 4-00-019-J
BY
VOID AFTER
APR 10 1981