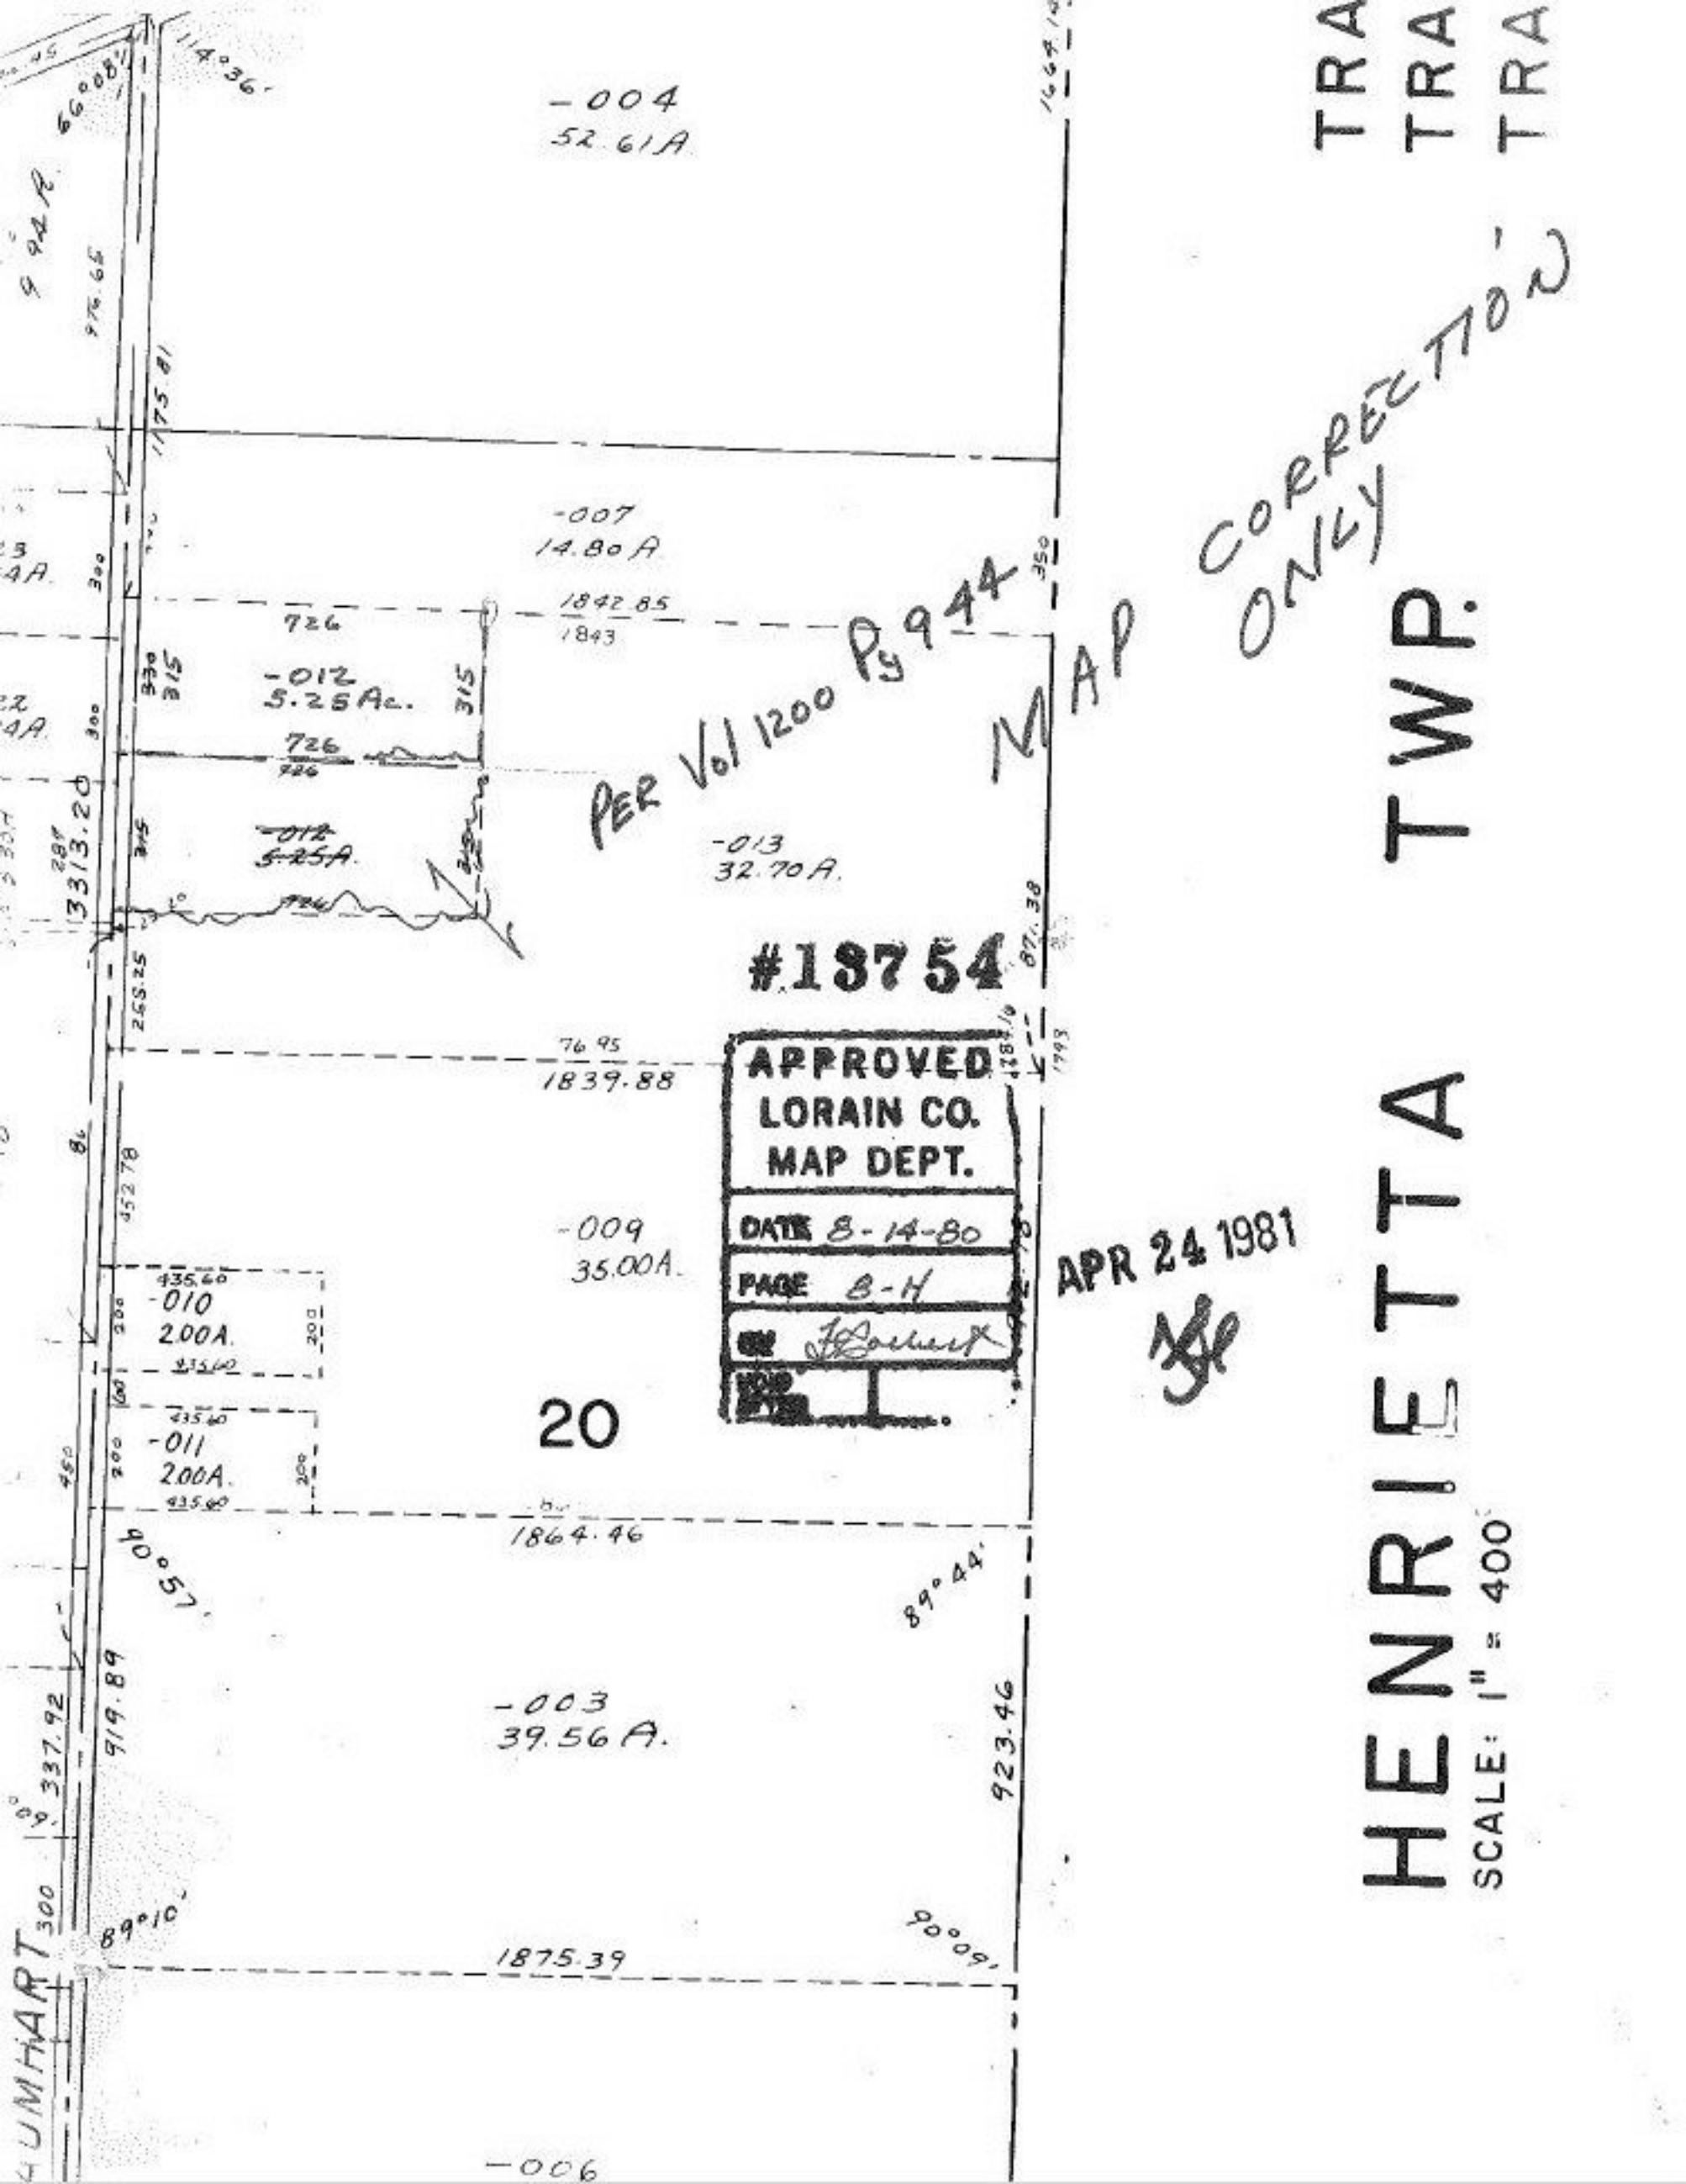

TRA
TRA
TRA
TWP.
HENRIETTA
SCALE: 1" = 400'
MAP CORRECTION ONLY
PER Vol 1200 Pg 944
#13754
APPROVED
LORAIN CO.
MAP DEPT.
DATE 8-14-80
PAGE 8-H
APR 24 1981
-004
52.61A
-007
14.80A
-012
5.25Ac.
-013
32.70A.
-009
35.00A.
-010
2.00A.
-011
2.00A.
20
-003
39.56A.
-006
1842.85
1843
1839.88
1864.46
1875.39
923.46
919.89
3313.20
337.92
90°57'
89°44'
89°10'
90°09'
114°36'
66°08'