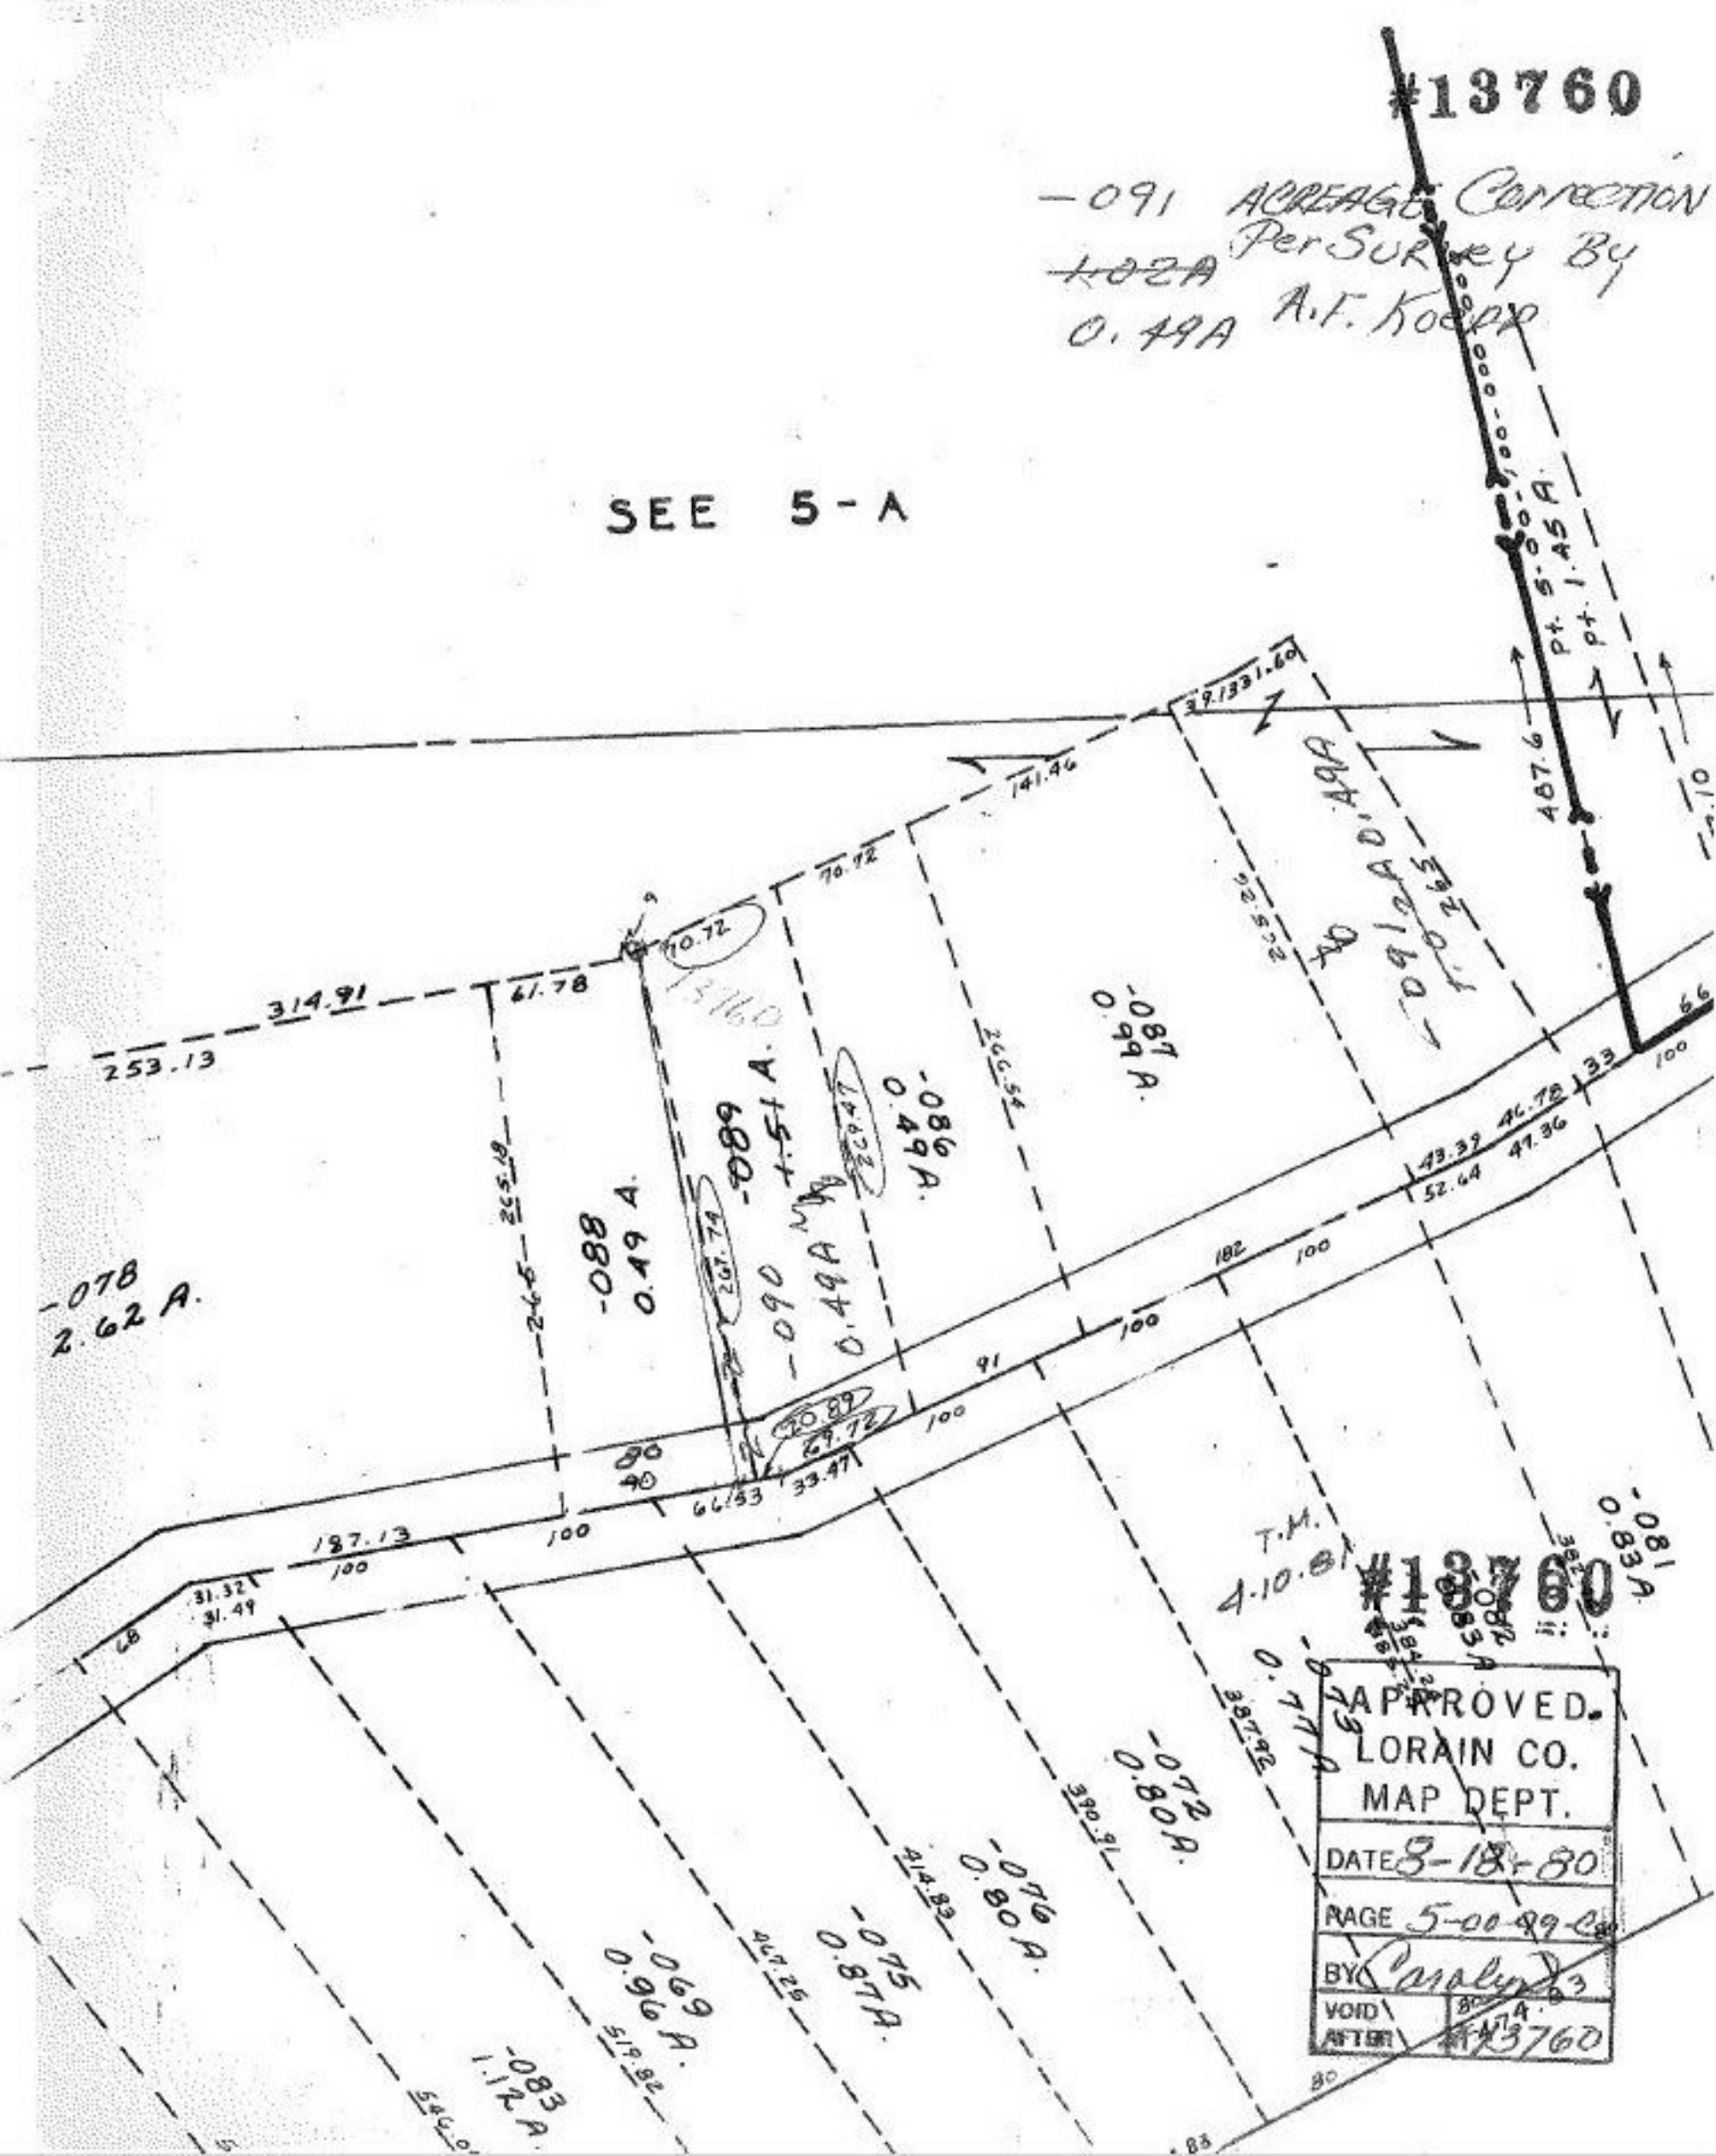
#13760
-091 ACREAGE CORRECTION
~~1.02A~~ Per Survey By
0.49A A.F. Koepp
SEE 5-A
-078
2.62 A.
-088
0.49 A.
-089
1.51 A.
-090
0.49A
-086
0.49A.
-087
0.99 A.
-091
0.49A
-081
0.83A.
-072
0.80A.
-076
0.80A.
-075
0.87A.
-069
0.96 A.
-083
1.12 A.
T.M.
4.10.81
#13760
APPROVED.
LORAIN CO.
MAP DEPT.
DATE 8-18-80
PAGE 5-00-99-C
BY Carolyn
VOID AFTER #13760