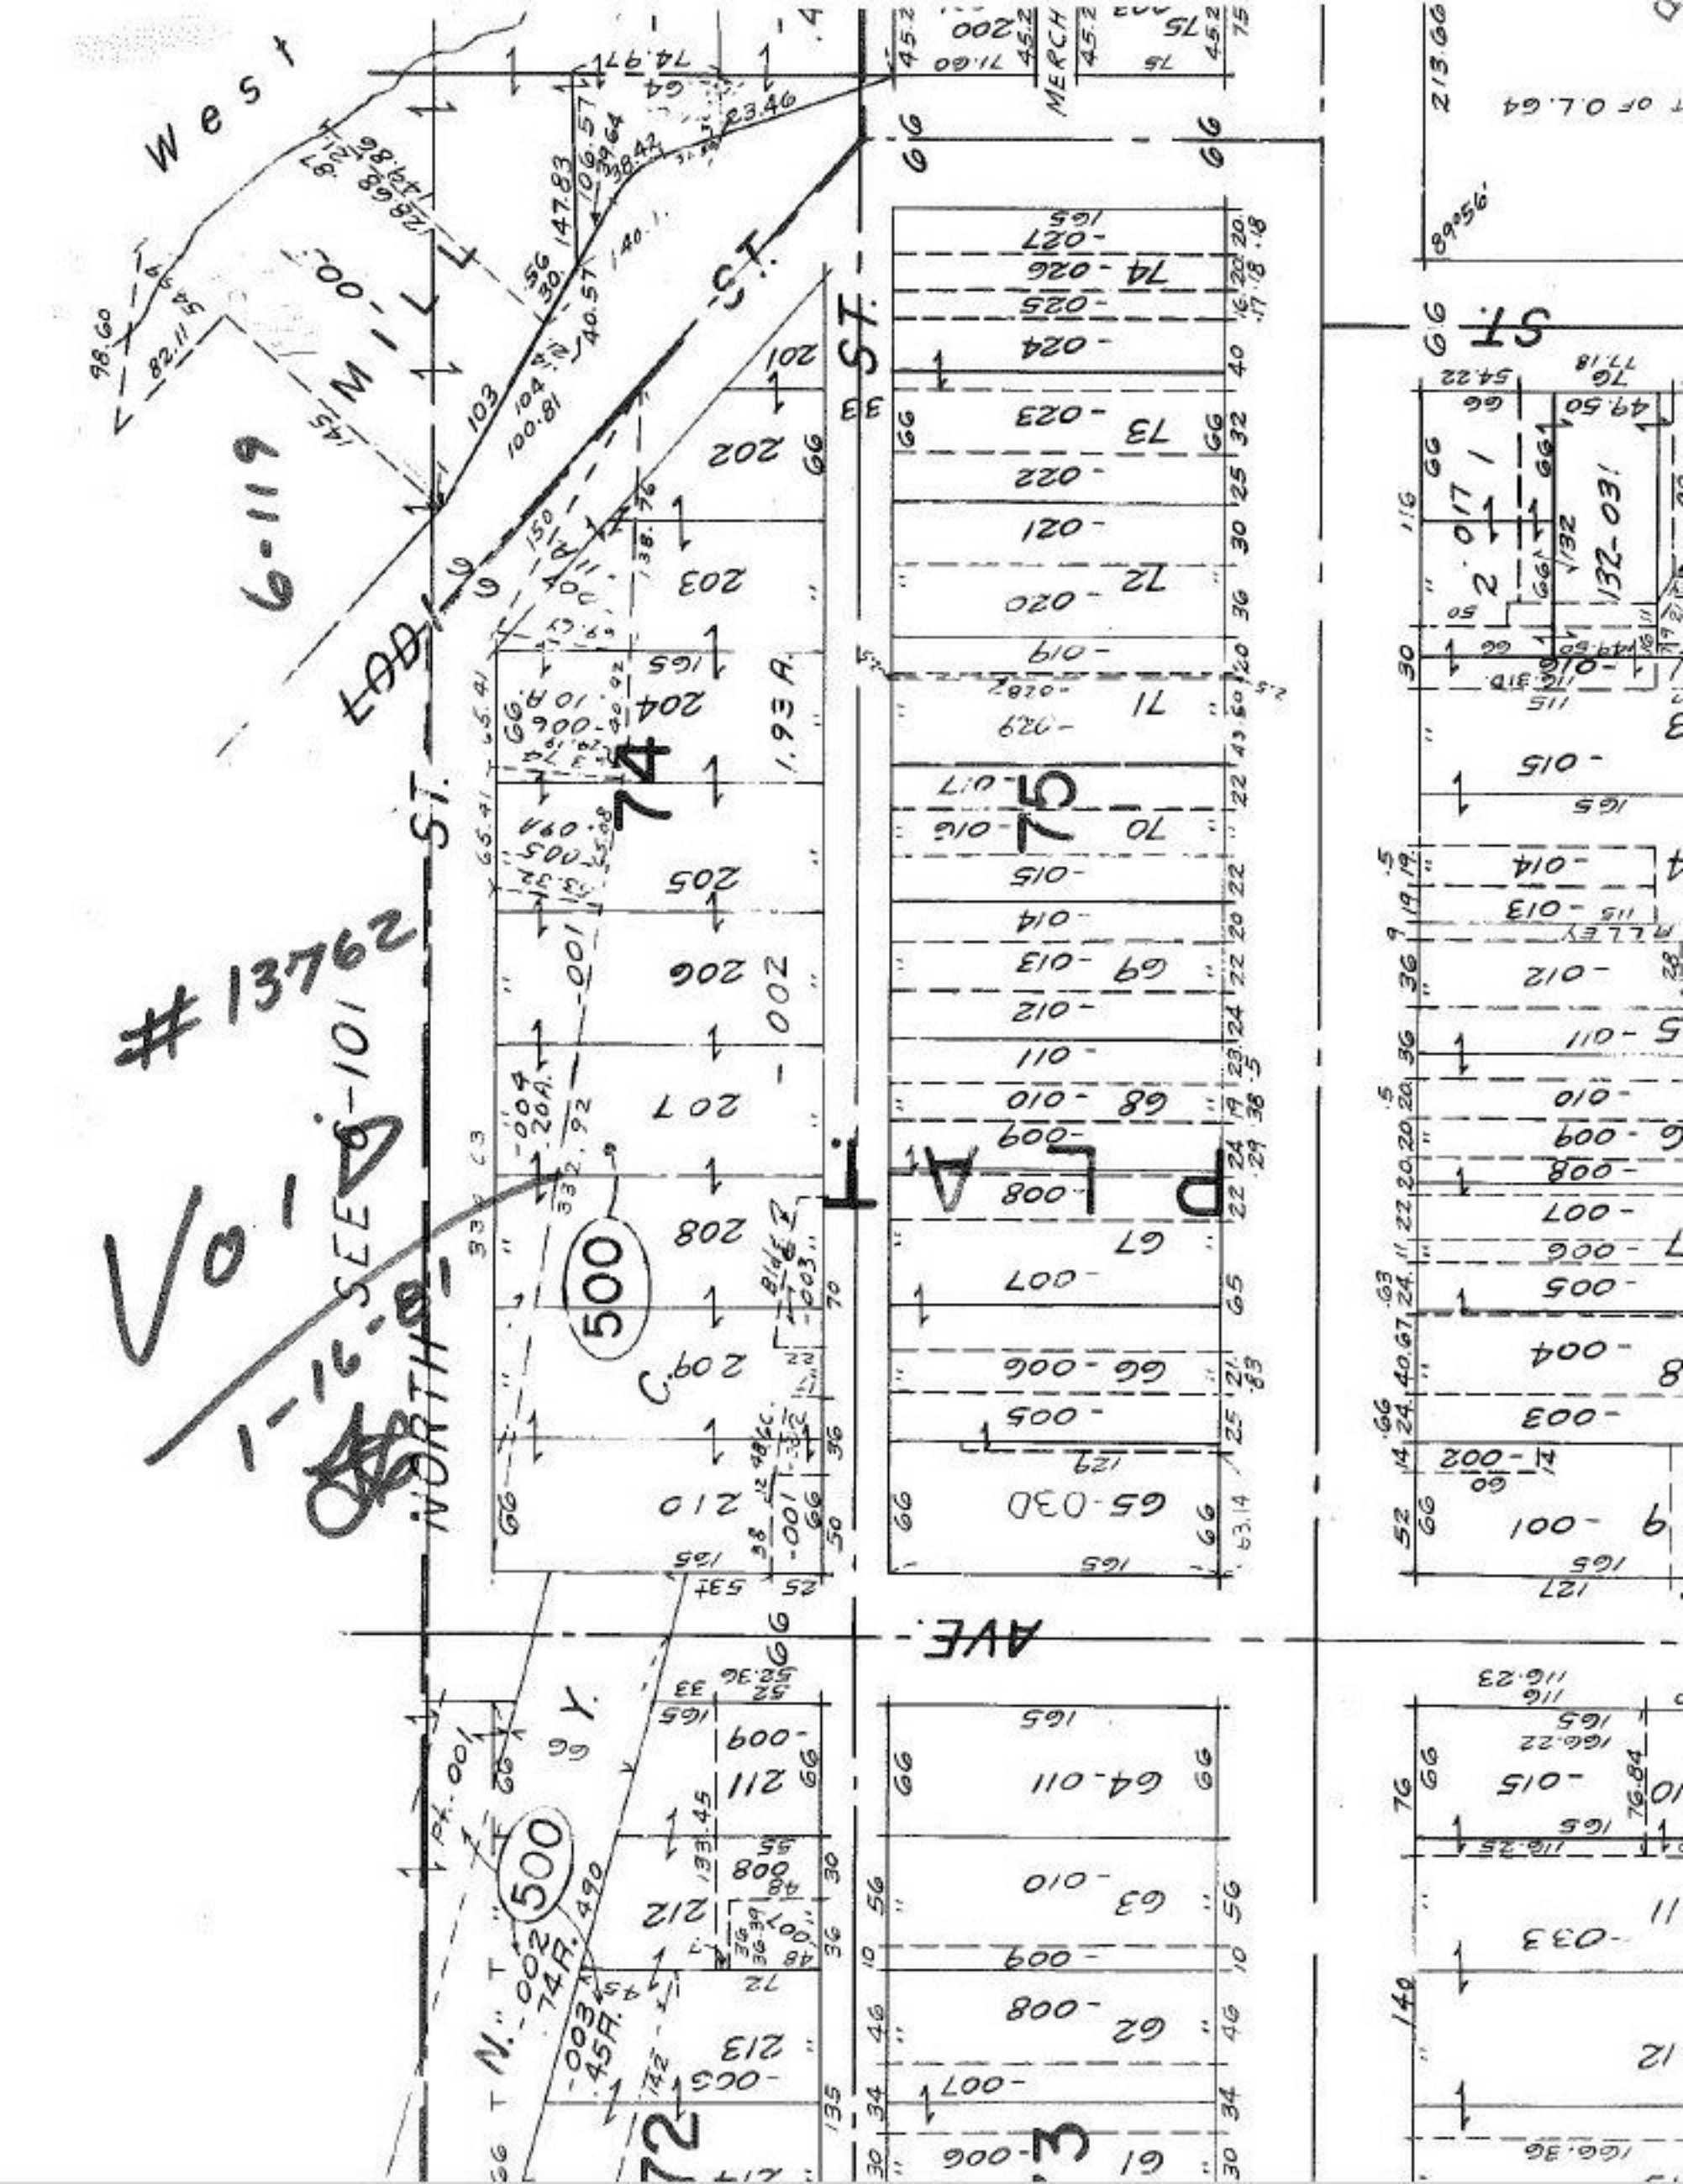
West
MILL
ST.
6-119
#13762
1-16-81
SEE 6-101
NORTH
ST.
PLAT
AVE.
MERCH
500
74
75
72
73
74
75
1.93 A.
132-031