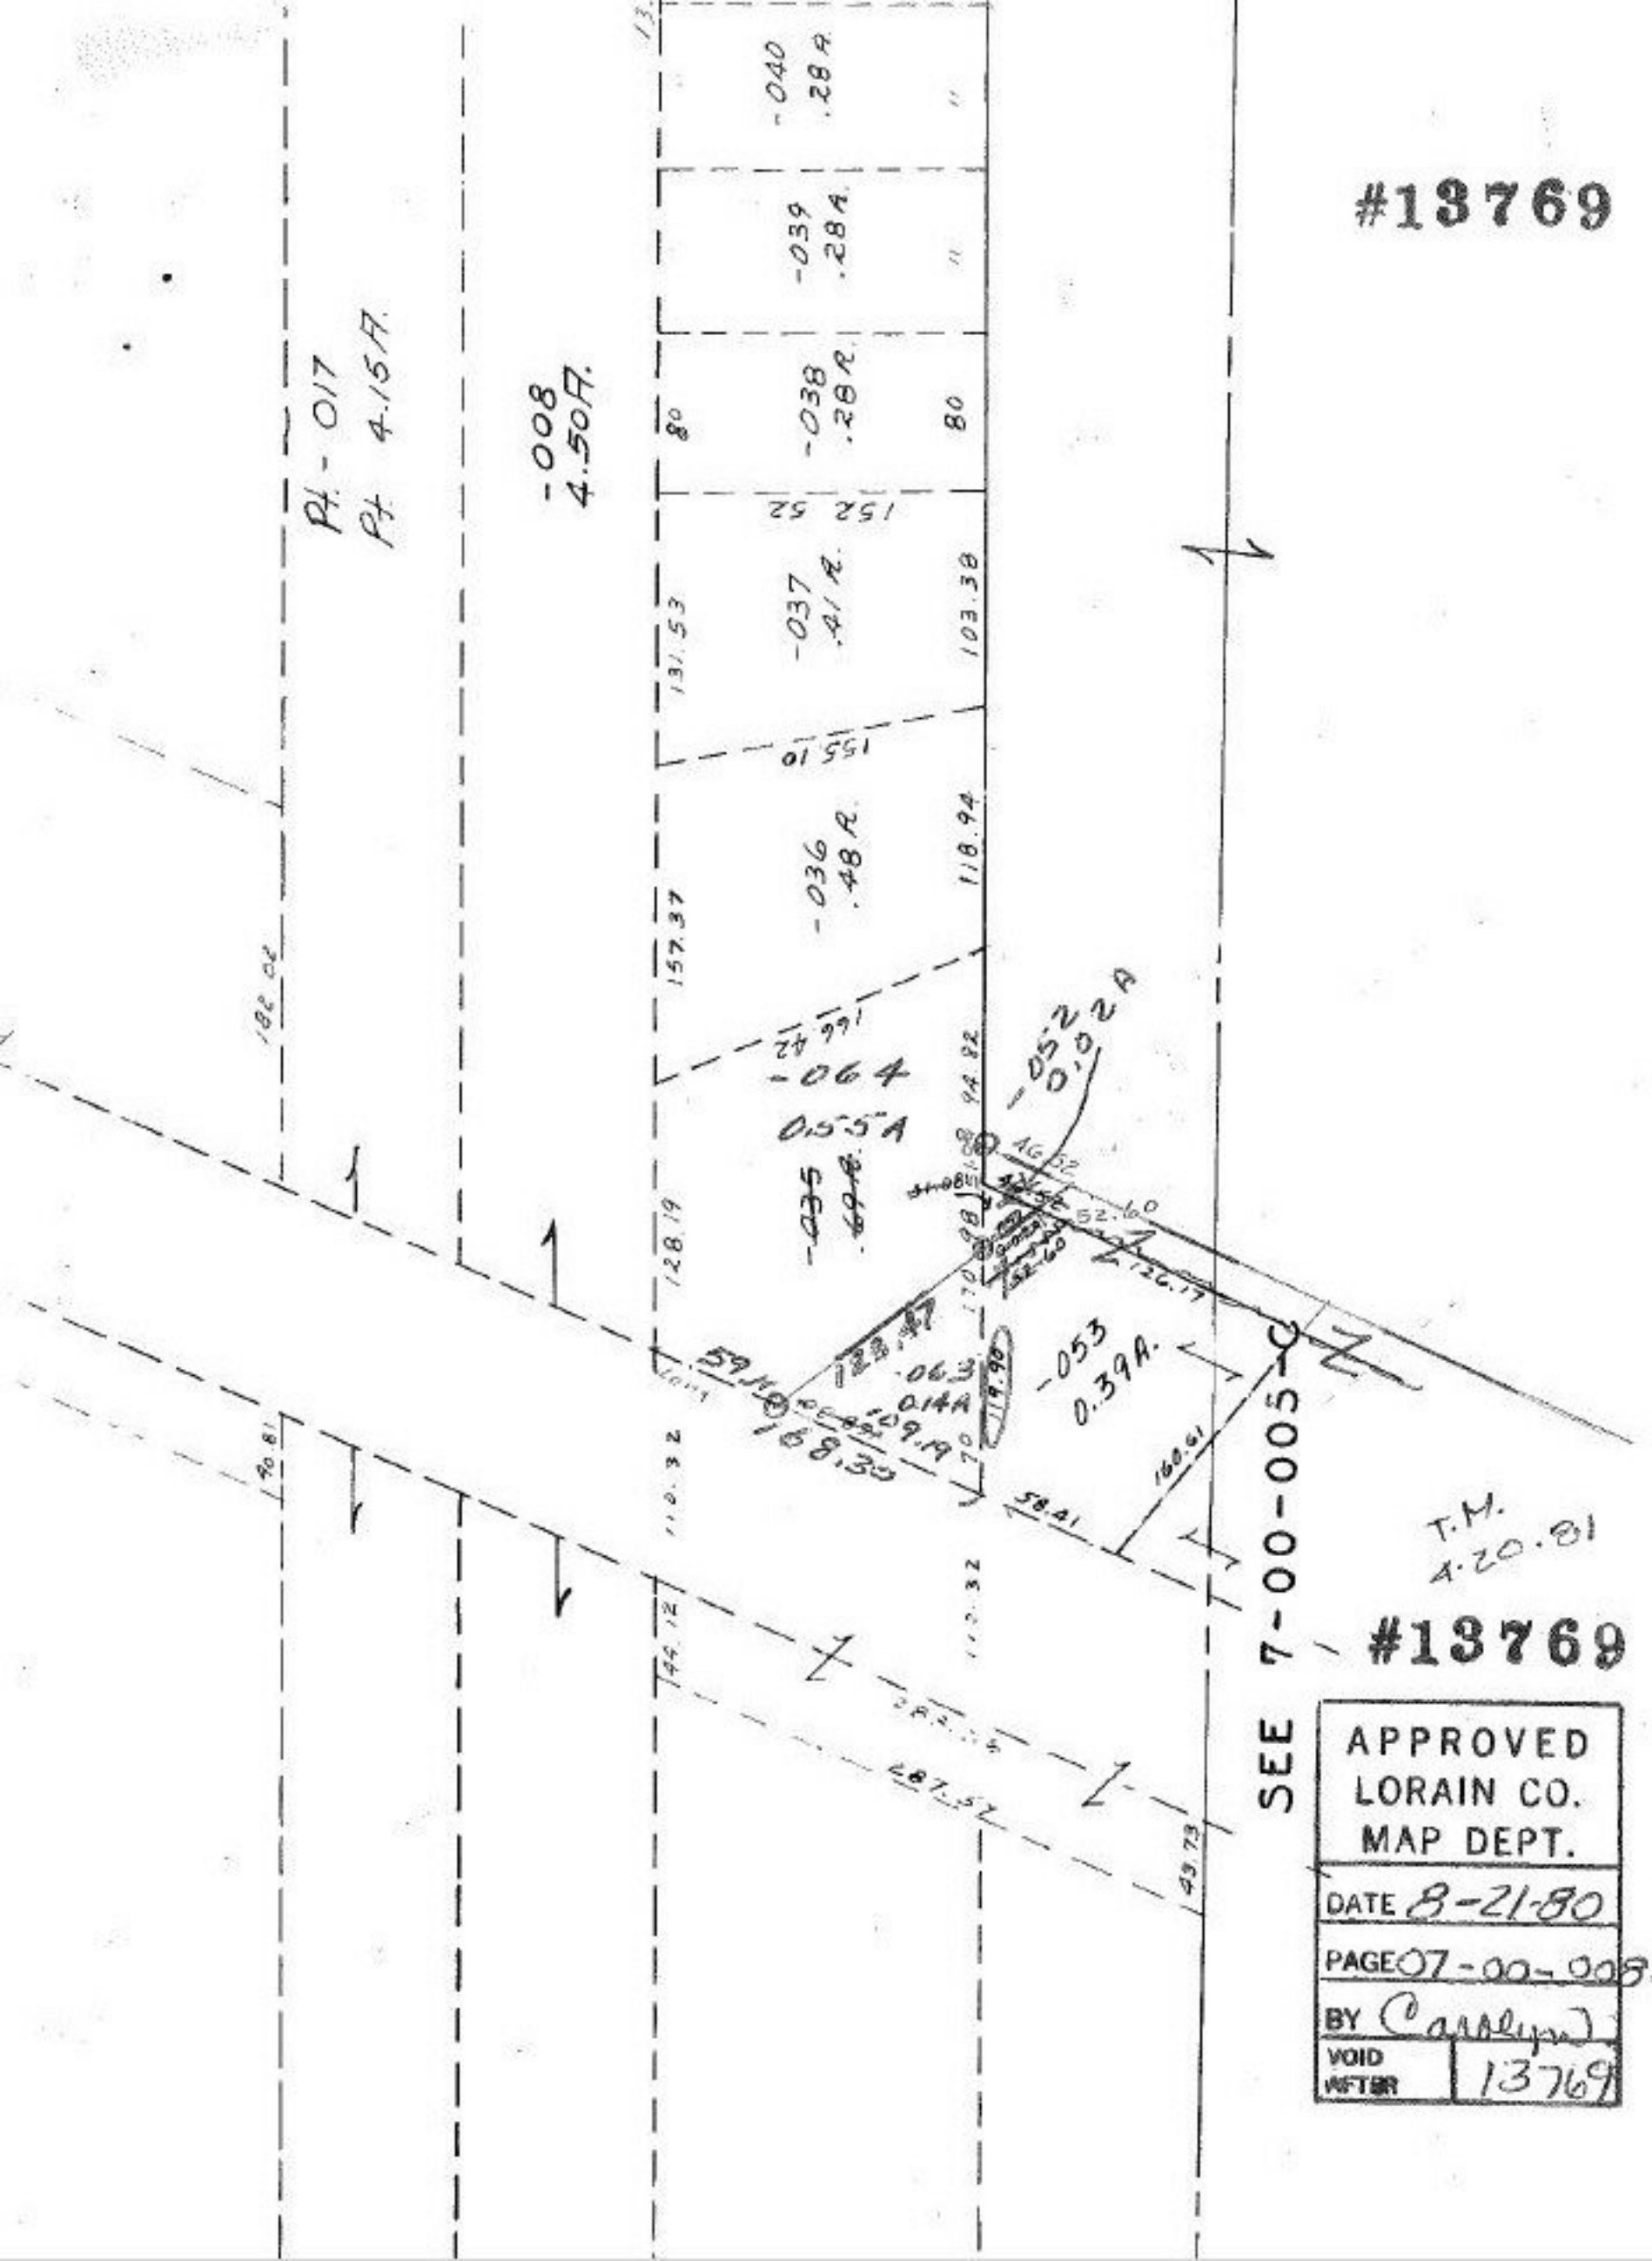

#13769
Pt. - 017
Pt. 4.15A.
-008
4.50A.
-040
.28A
-039
.28A
-038
.28A
-037
.41A
-036
.48A
-064
0.55A
-052
0.02A
-053
0.39A.
-063
0.14A
T.M.
4.20.81
SEE 7-00-005-C
#13769
APPROVED
LORAIN CO.
MAP DEPT.
DATE 8-21-80
PAGE 07-00-008-D
BY Carolyn
VOID AFTER 13769