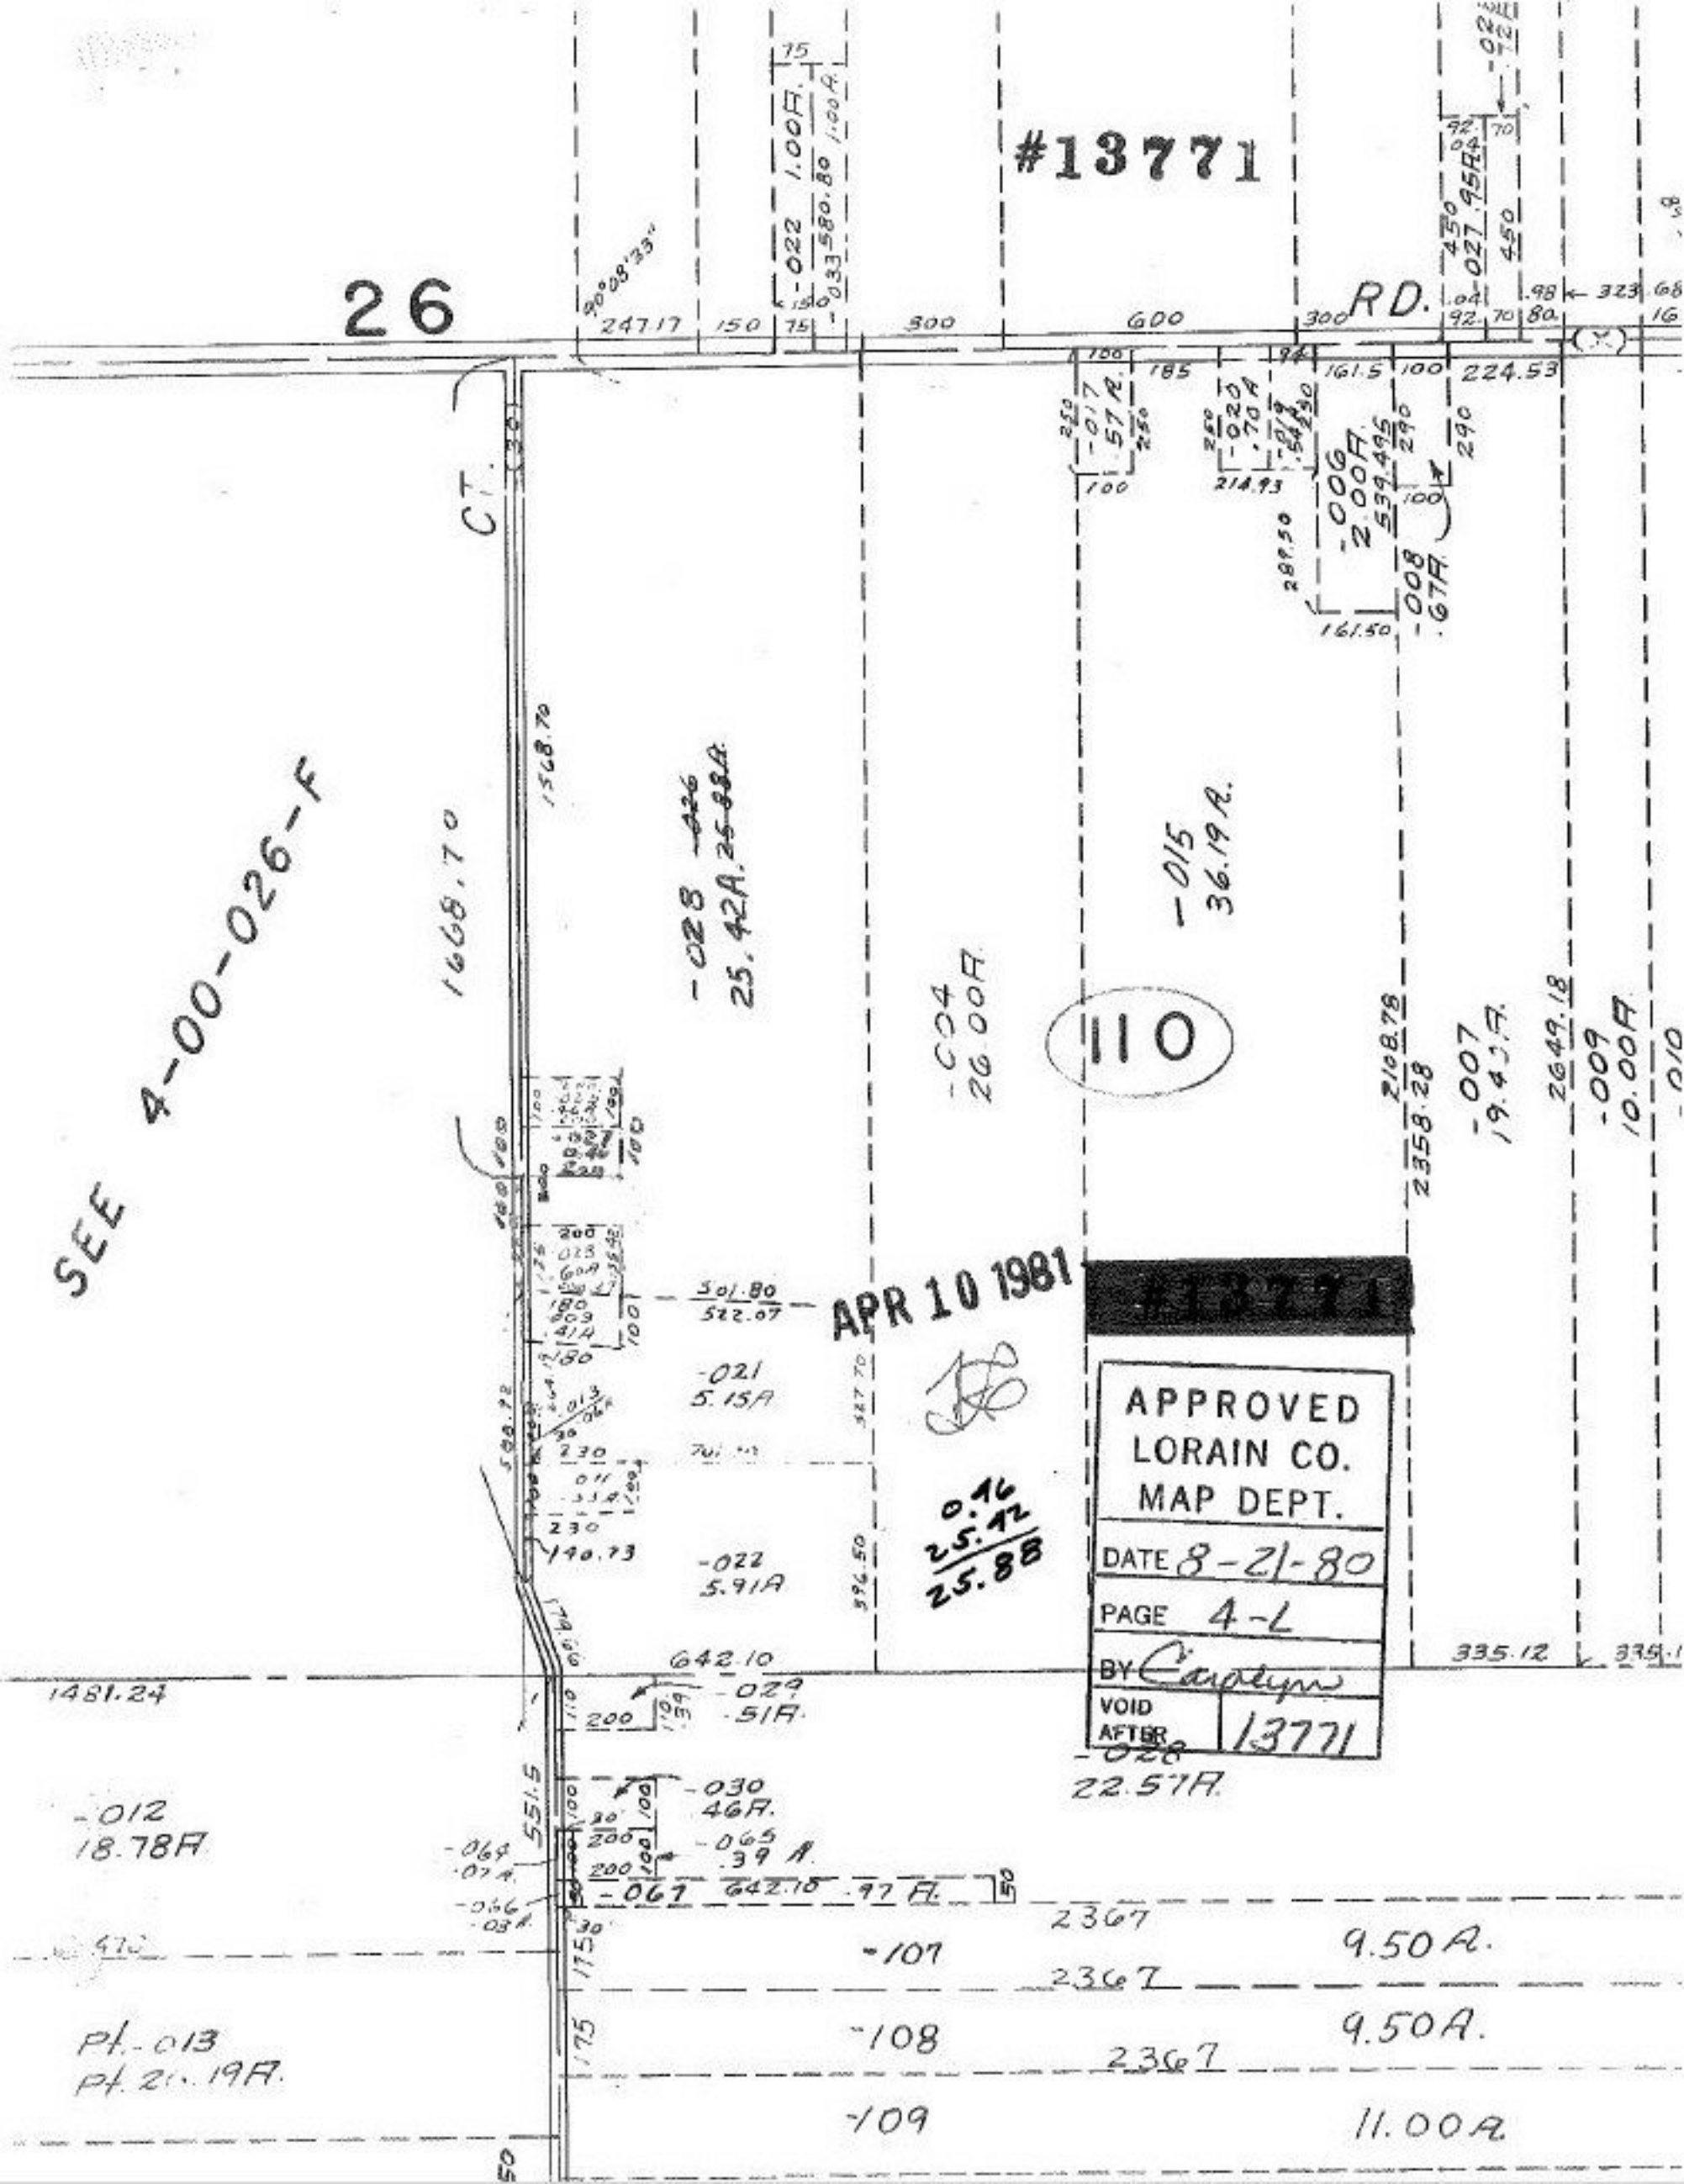

#13771
26
RD.
CT.
SEE 4-00-026-F
1668.70
-028 25.42A.
-015 36.19A.
-004 26.00A
110
-007 19.43A.
-009 10.00A.
-021 5.15A
-022 5.91A
0.46
25.42
25.88
-029 .51A.
-030 46A.
-065 .39 A.
-067 642.10 .97 A.
-012 18.78A
-028 22.57A.
-107 9.50A.
-108 9.50A.
-109 11.00A.
Pt.-013
Pt. 2[illegible].19A.
APR 10 1981
APPROVED
LORAIN CO.
MAP DEPT.
DATE 8-21-80
PAGE 4-L
BY Carolyn
VOID AFTER 13771