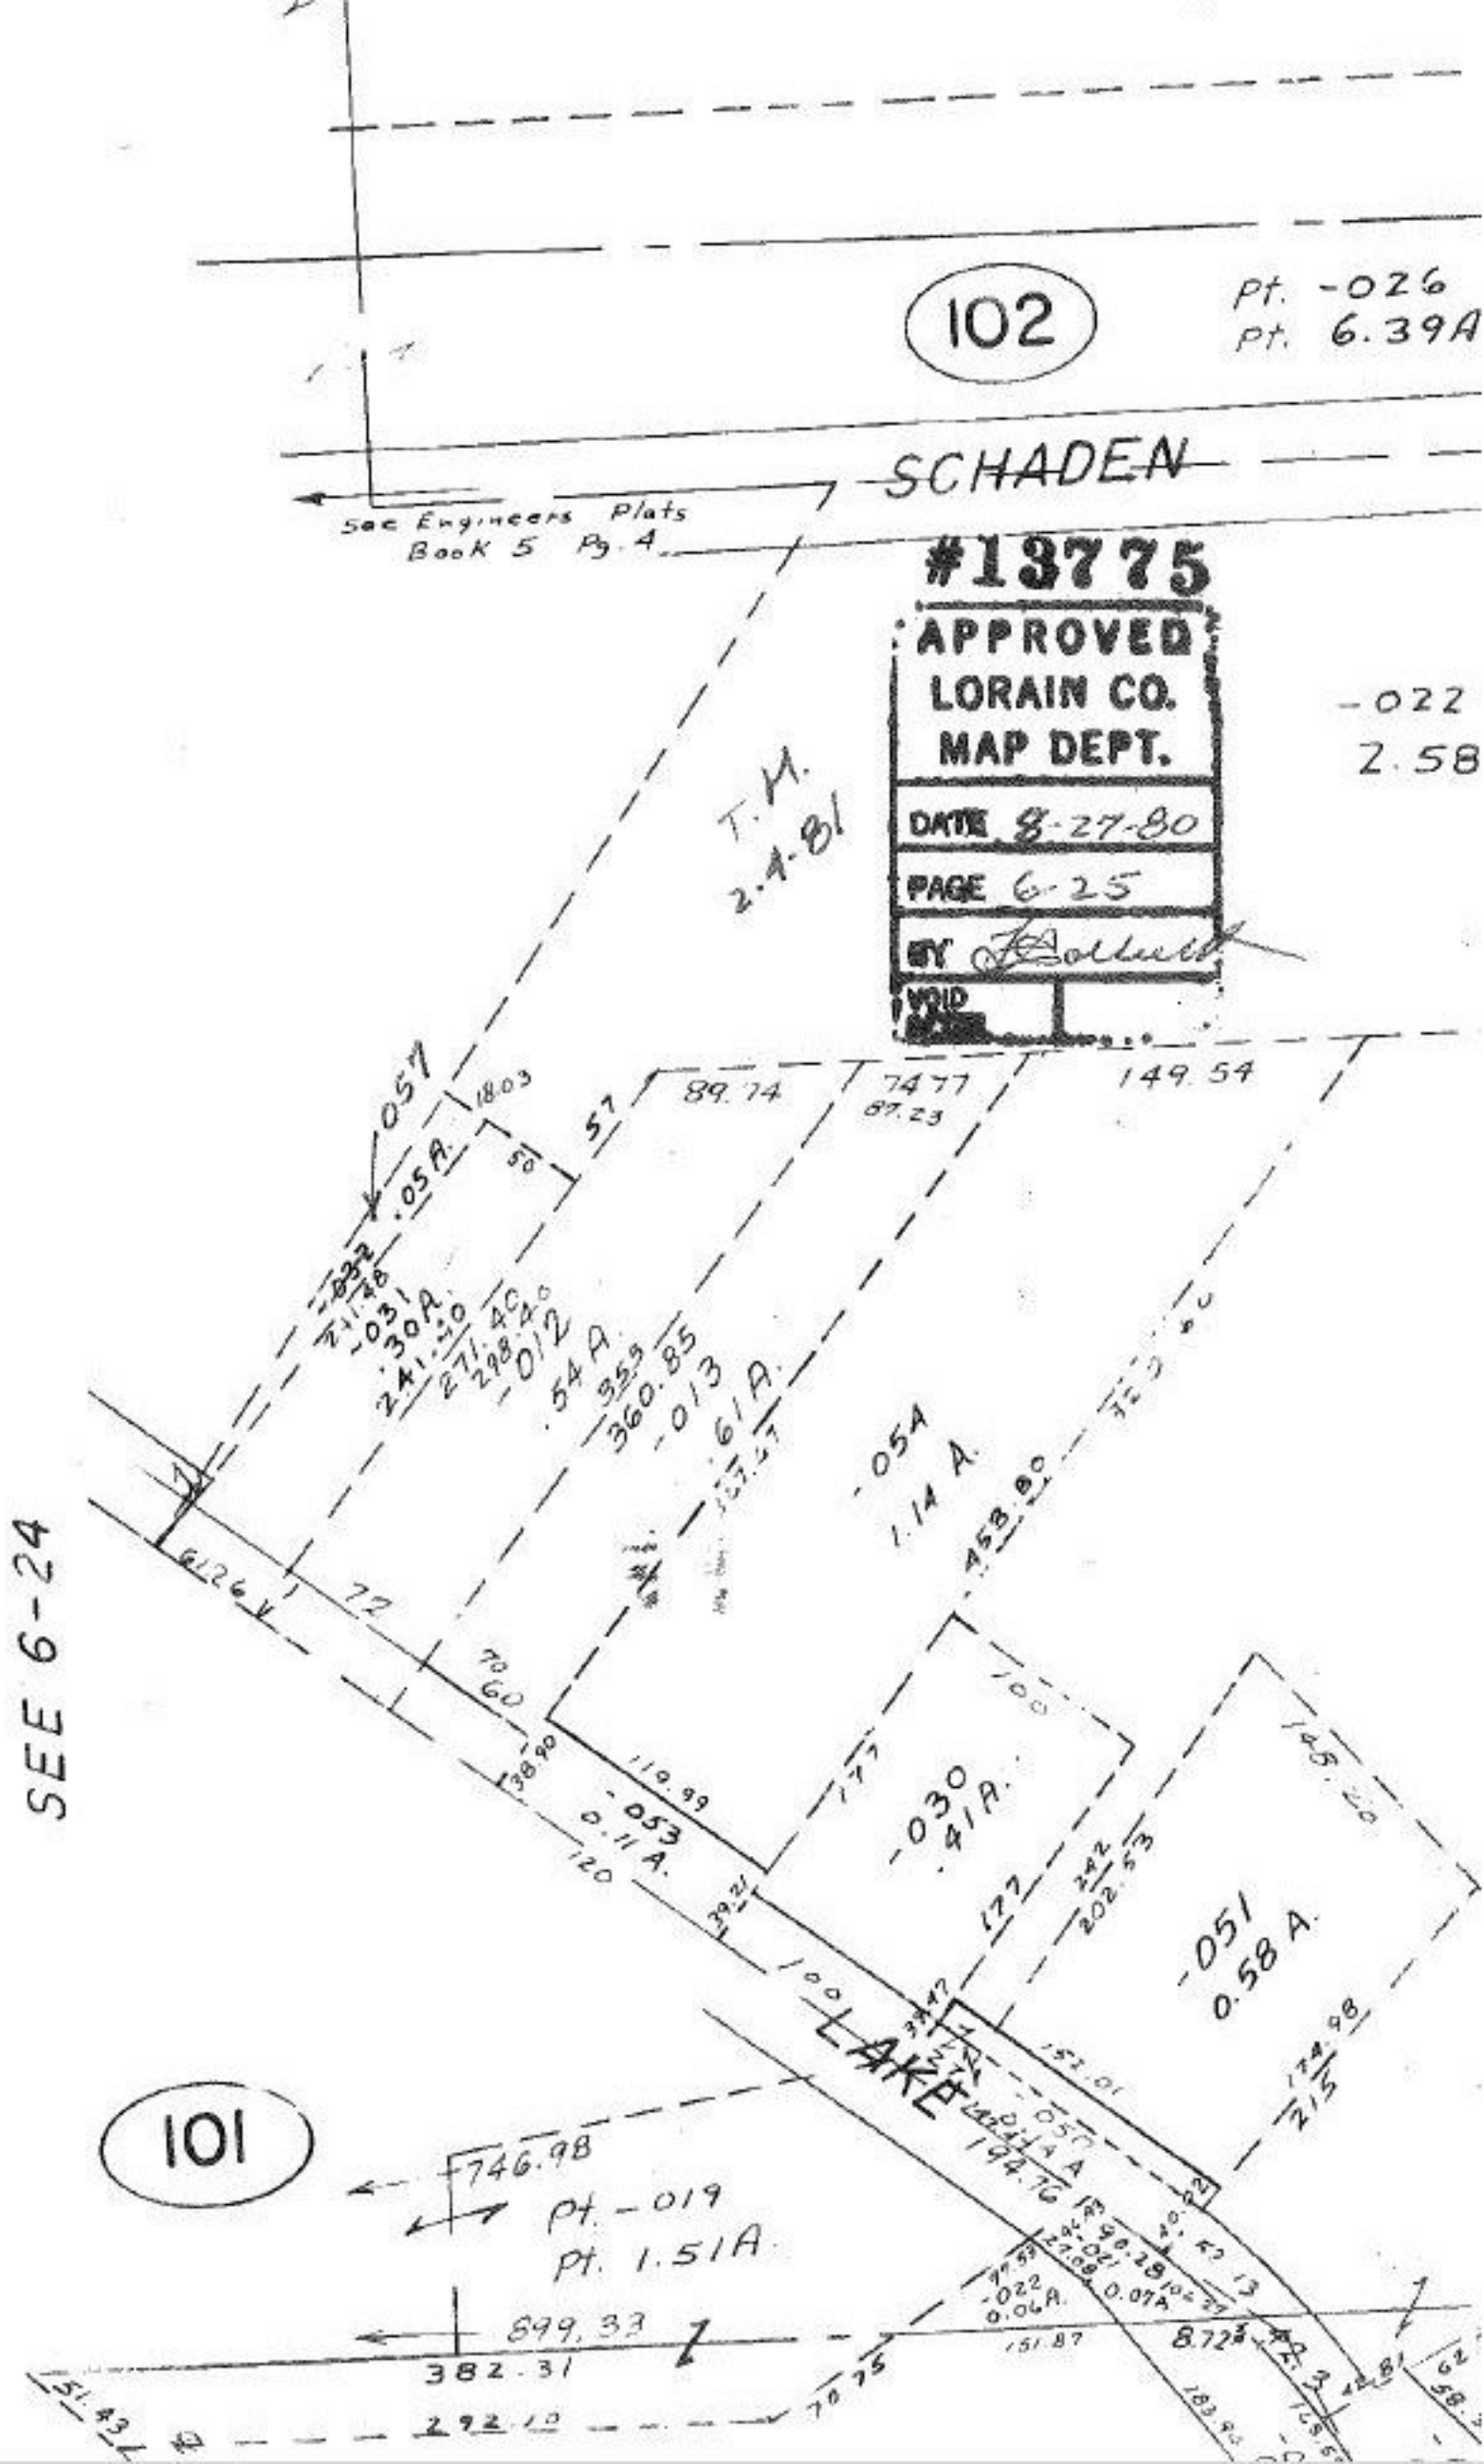

102
Pt. -026
Pt. 6.39A
SCHADEN
See Engineers Plats
Book 5 Pg. 4
#13775
APPROVED
LORAIN CO.
MAP DEPT.
DATE 8-27-80
PAGE 6-25
BY
VOID
T.M.
2-4-81
-022
2.58
-057
.05A.
-031
.30A.
-012
.54A.
-013
.61A.
-054
1.14 A.
-053
0.11 A.
-030
.41A.
-051
0.58 A.
LAKE
101
746.98
Pt. -019
Pt. 1.51A.
899.33
382.31
292.10
SEE 6-24