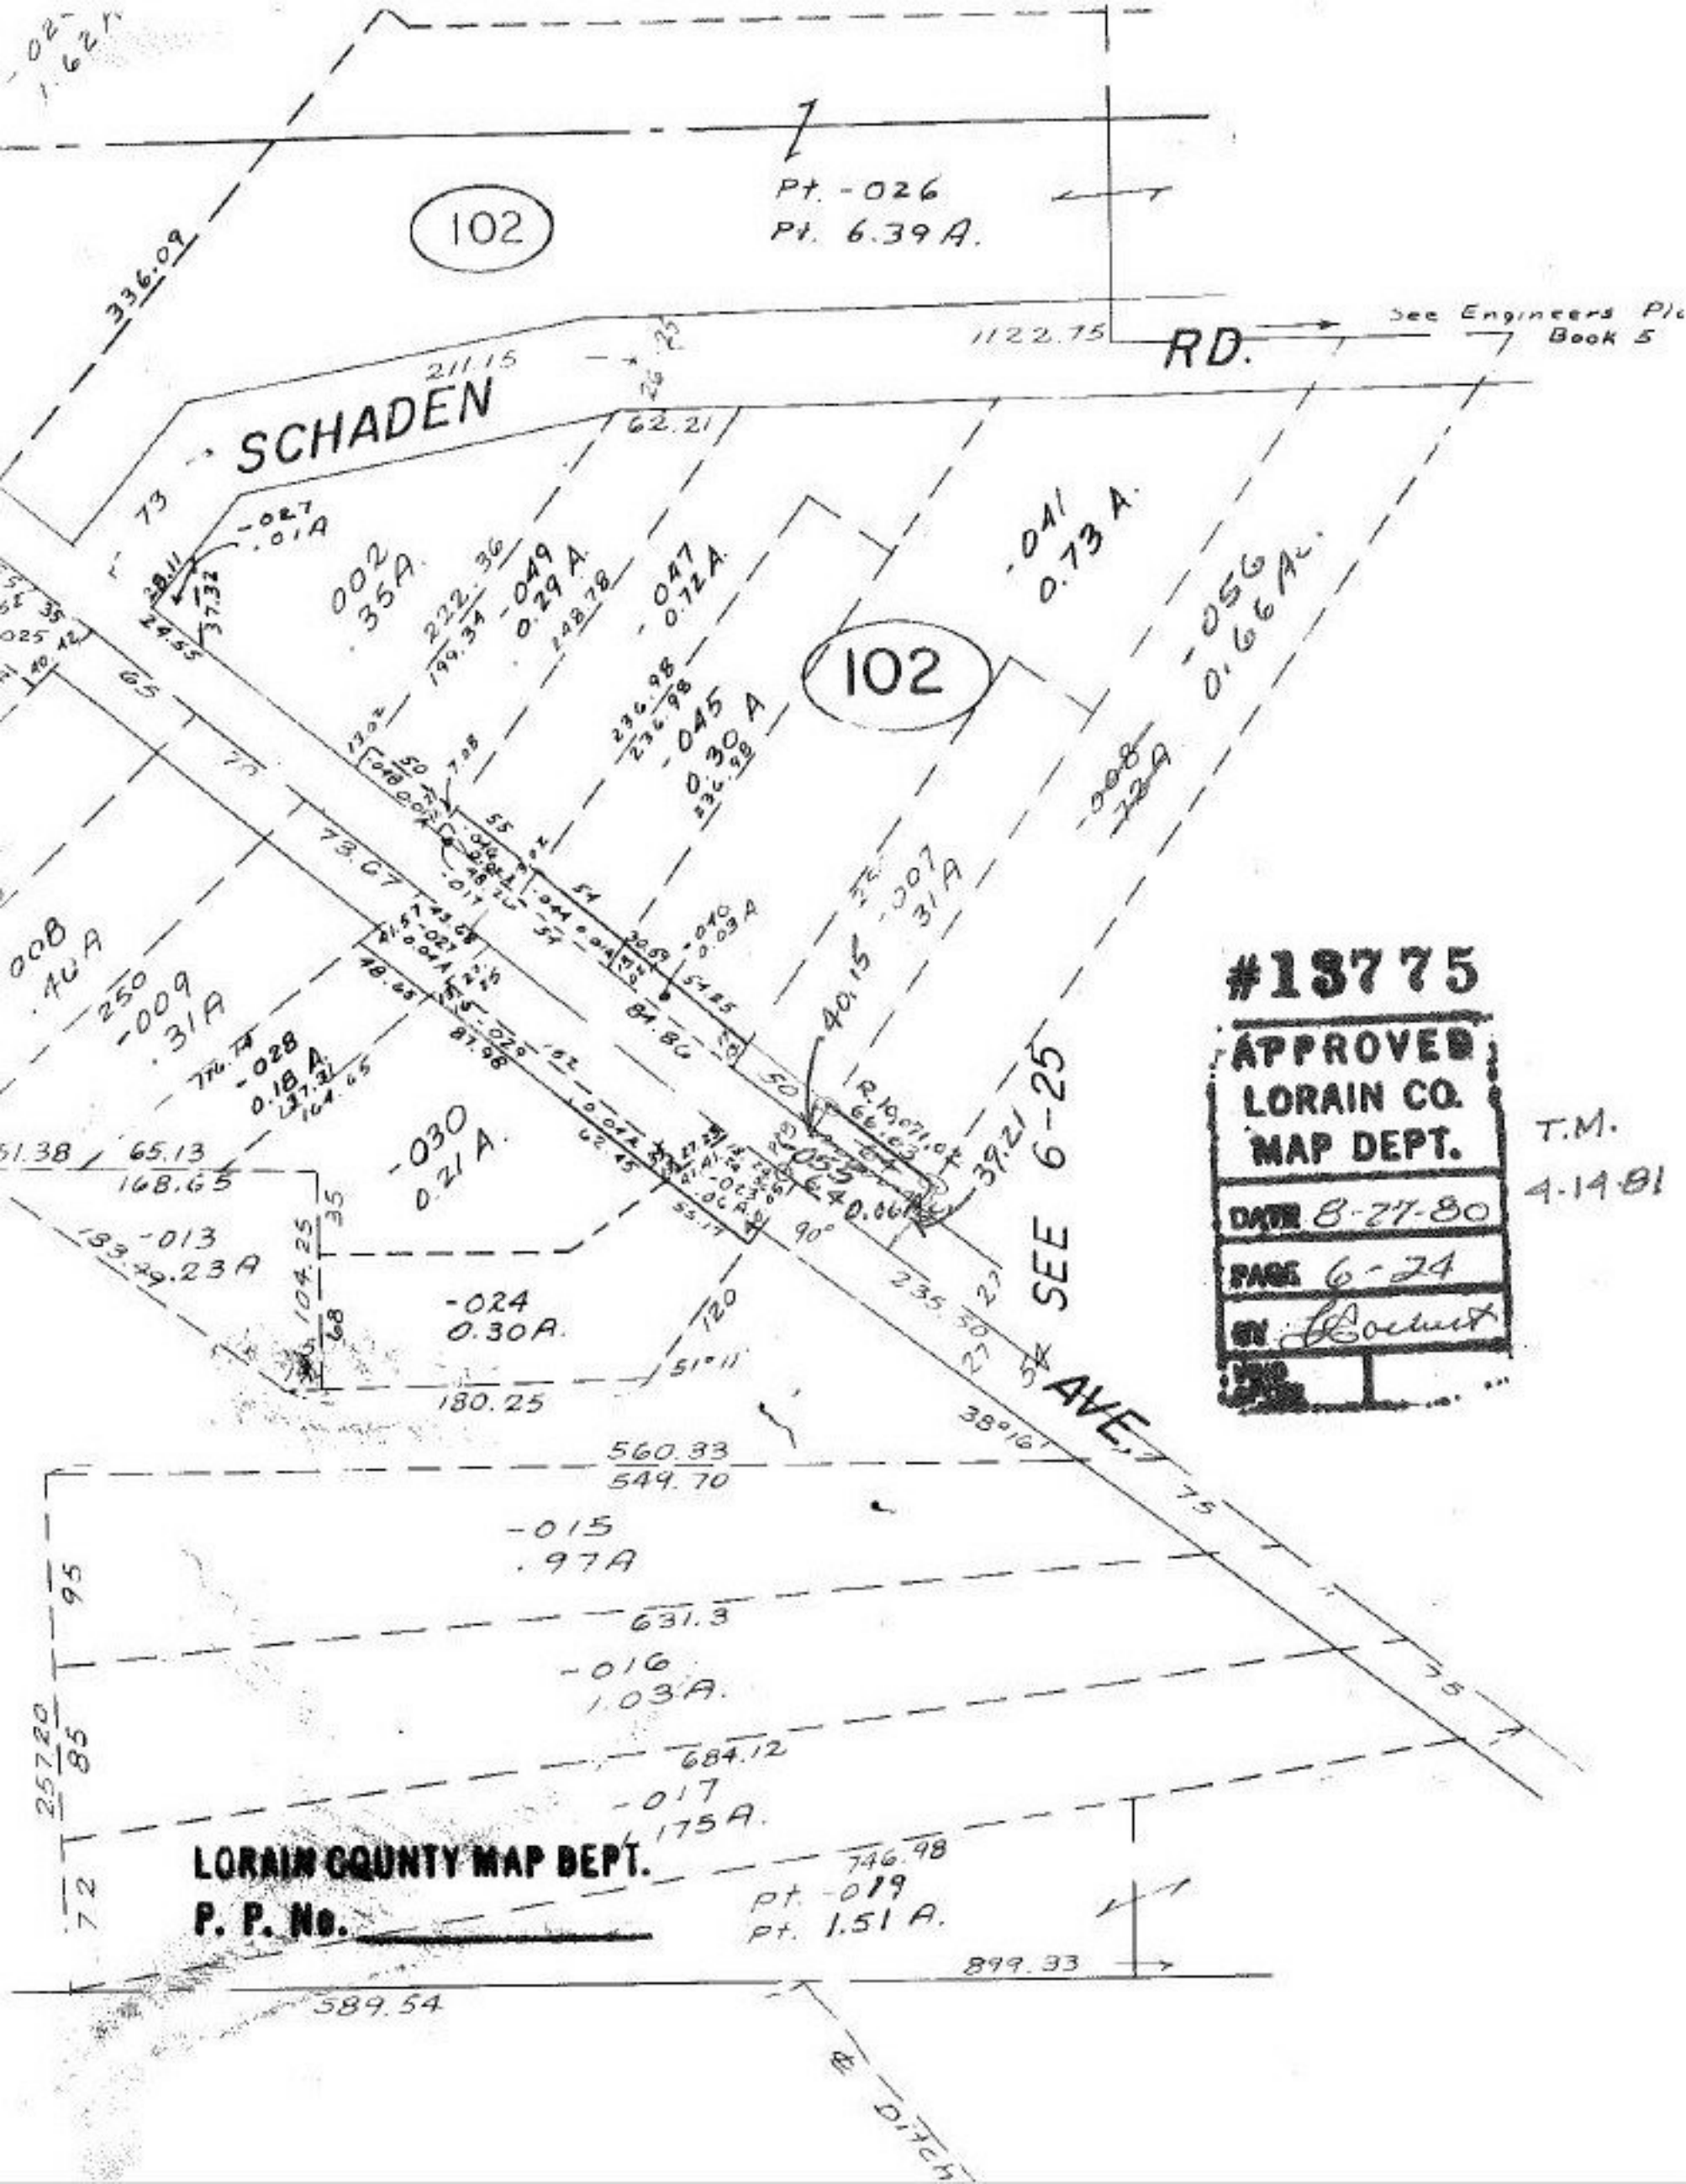

#13775

APPROVED
LORAIN CO.
MAP DEPT.

DATE 8-27-80

PAGE 6-24

BY [signature]

T.M.
4-14-81

LORAIN COUNTY MAP DEPT.

P. P. No. _____