#13782

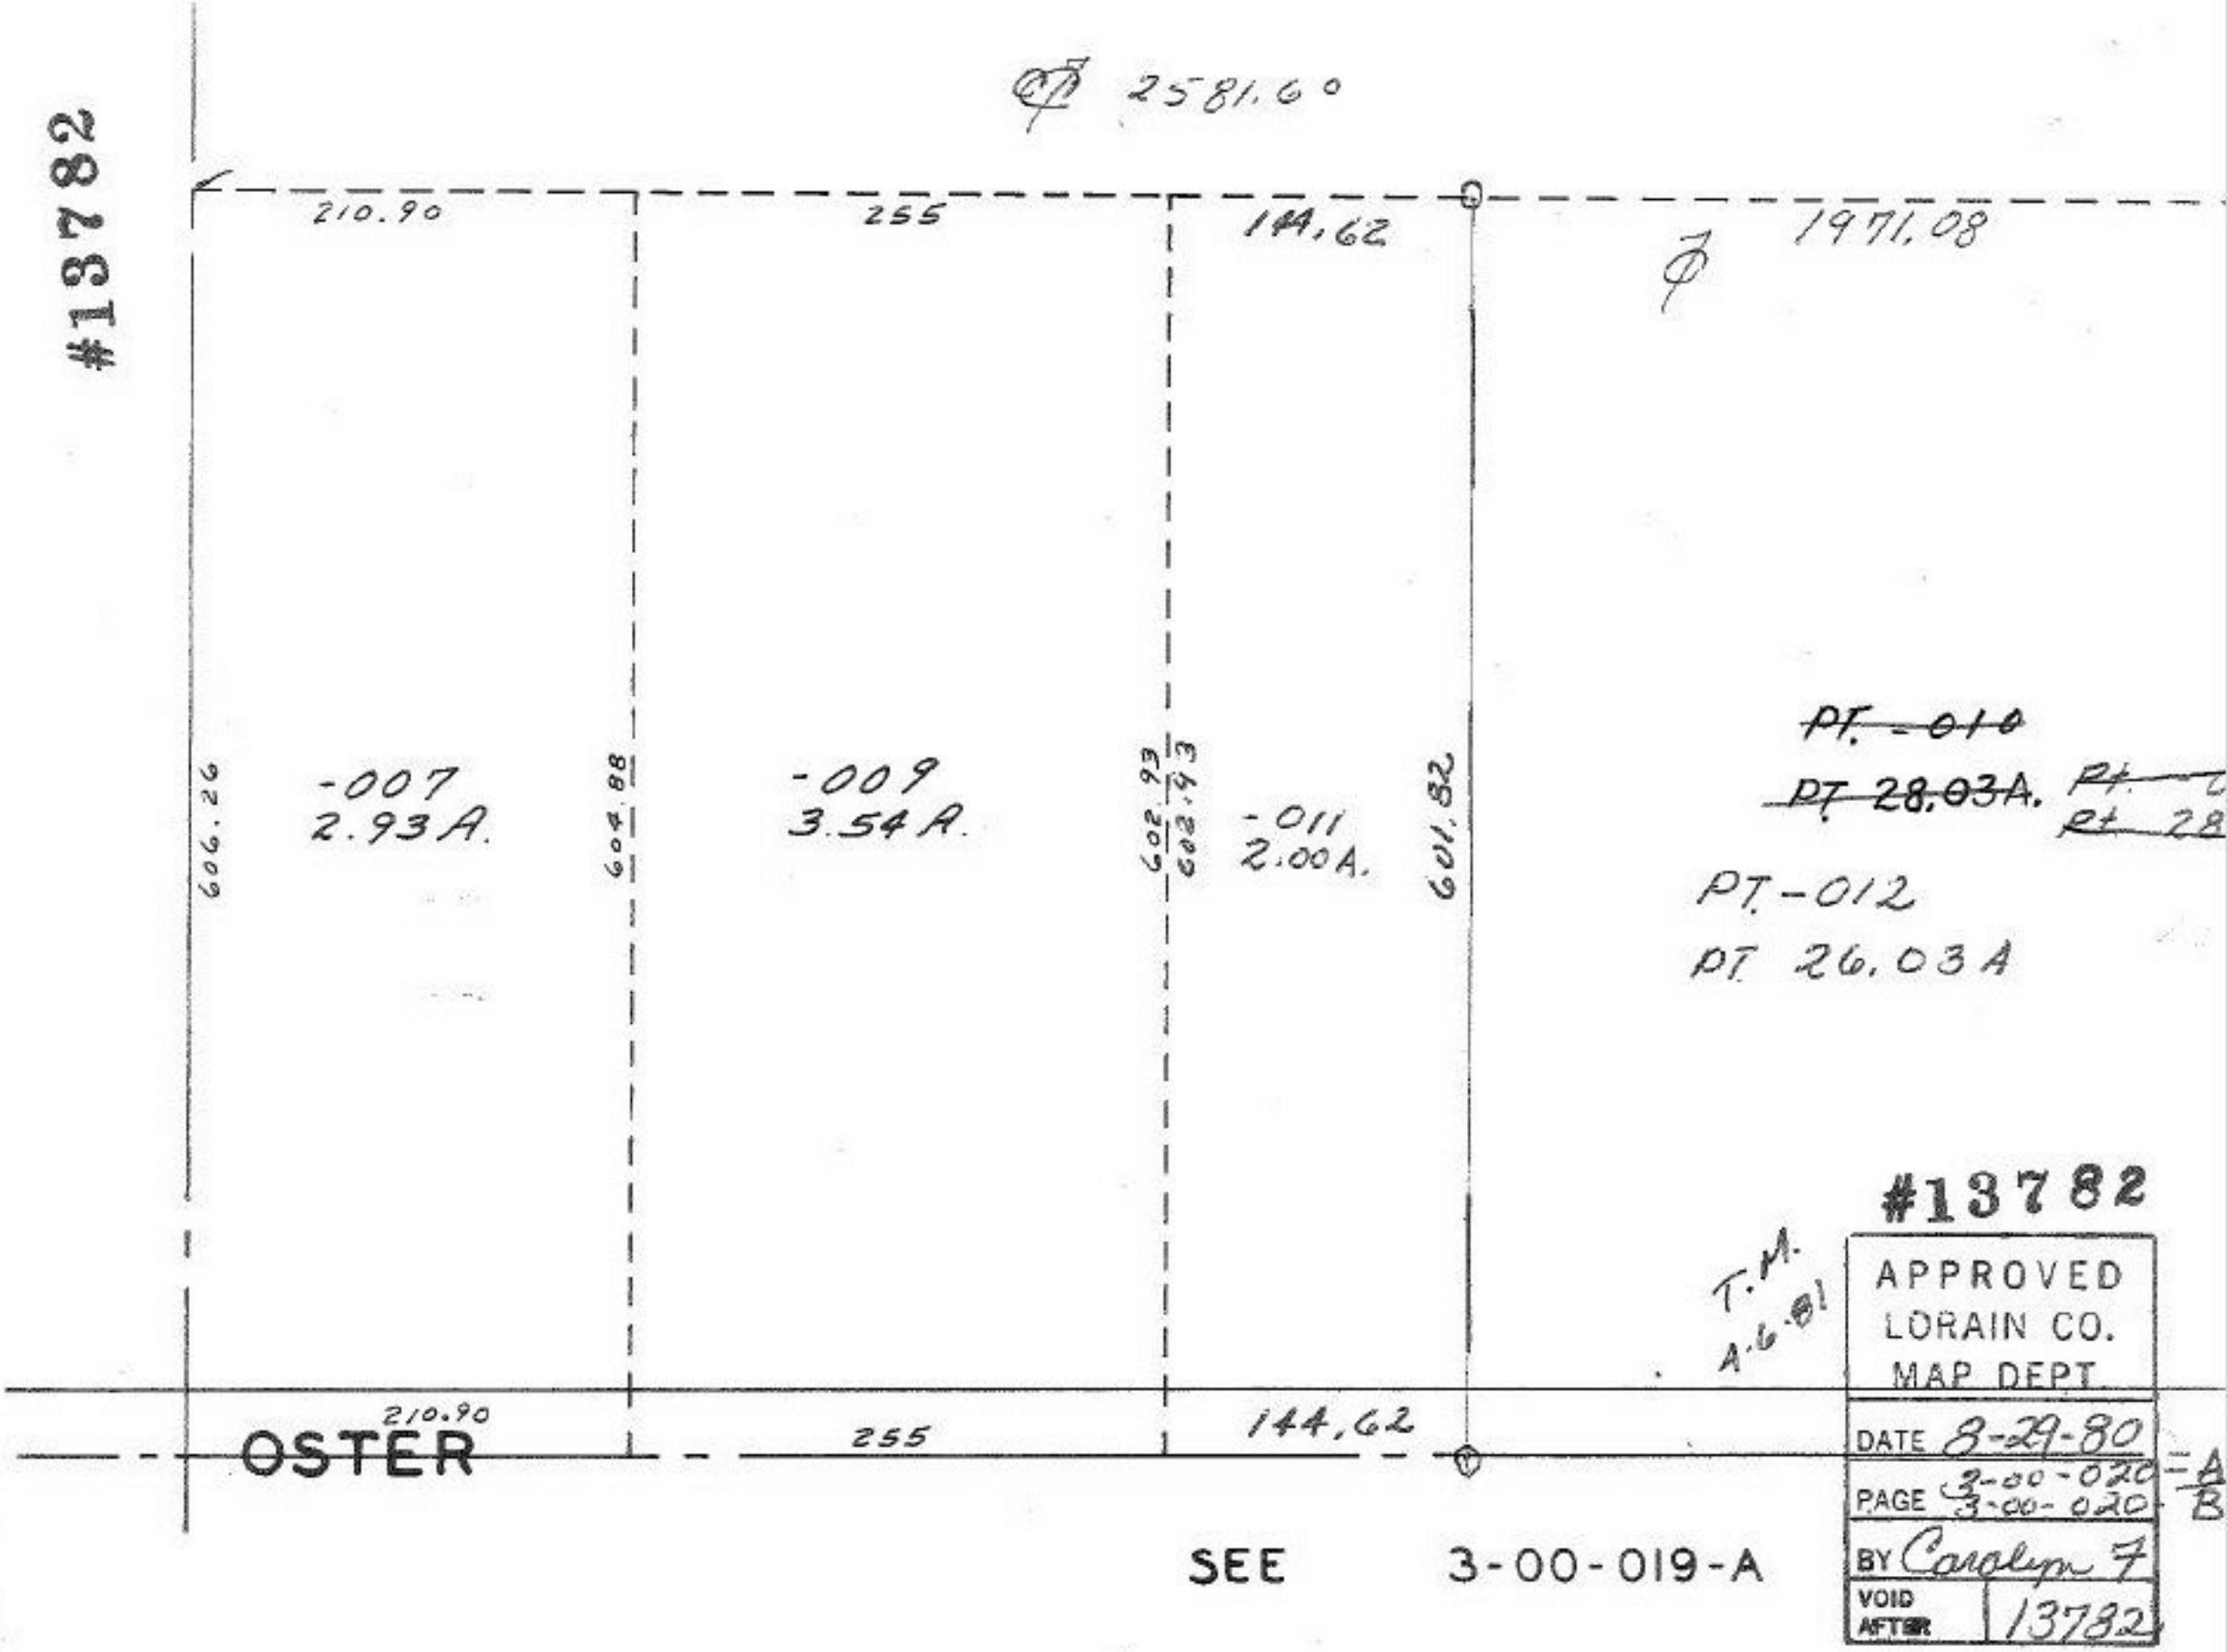

#13782

T.M.
4-6-81

APPROVED
LORAIN CO.
MAP DEPT.

DATE 8-29-80
PAGE 3-00-020-A
3-00-020-B
BY Carolyn F
VOID AFTER 13782