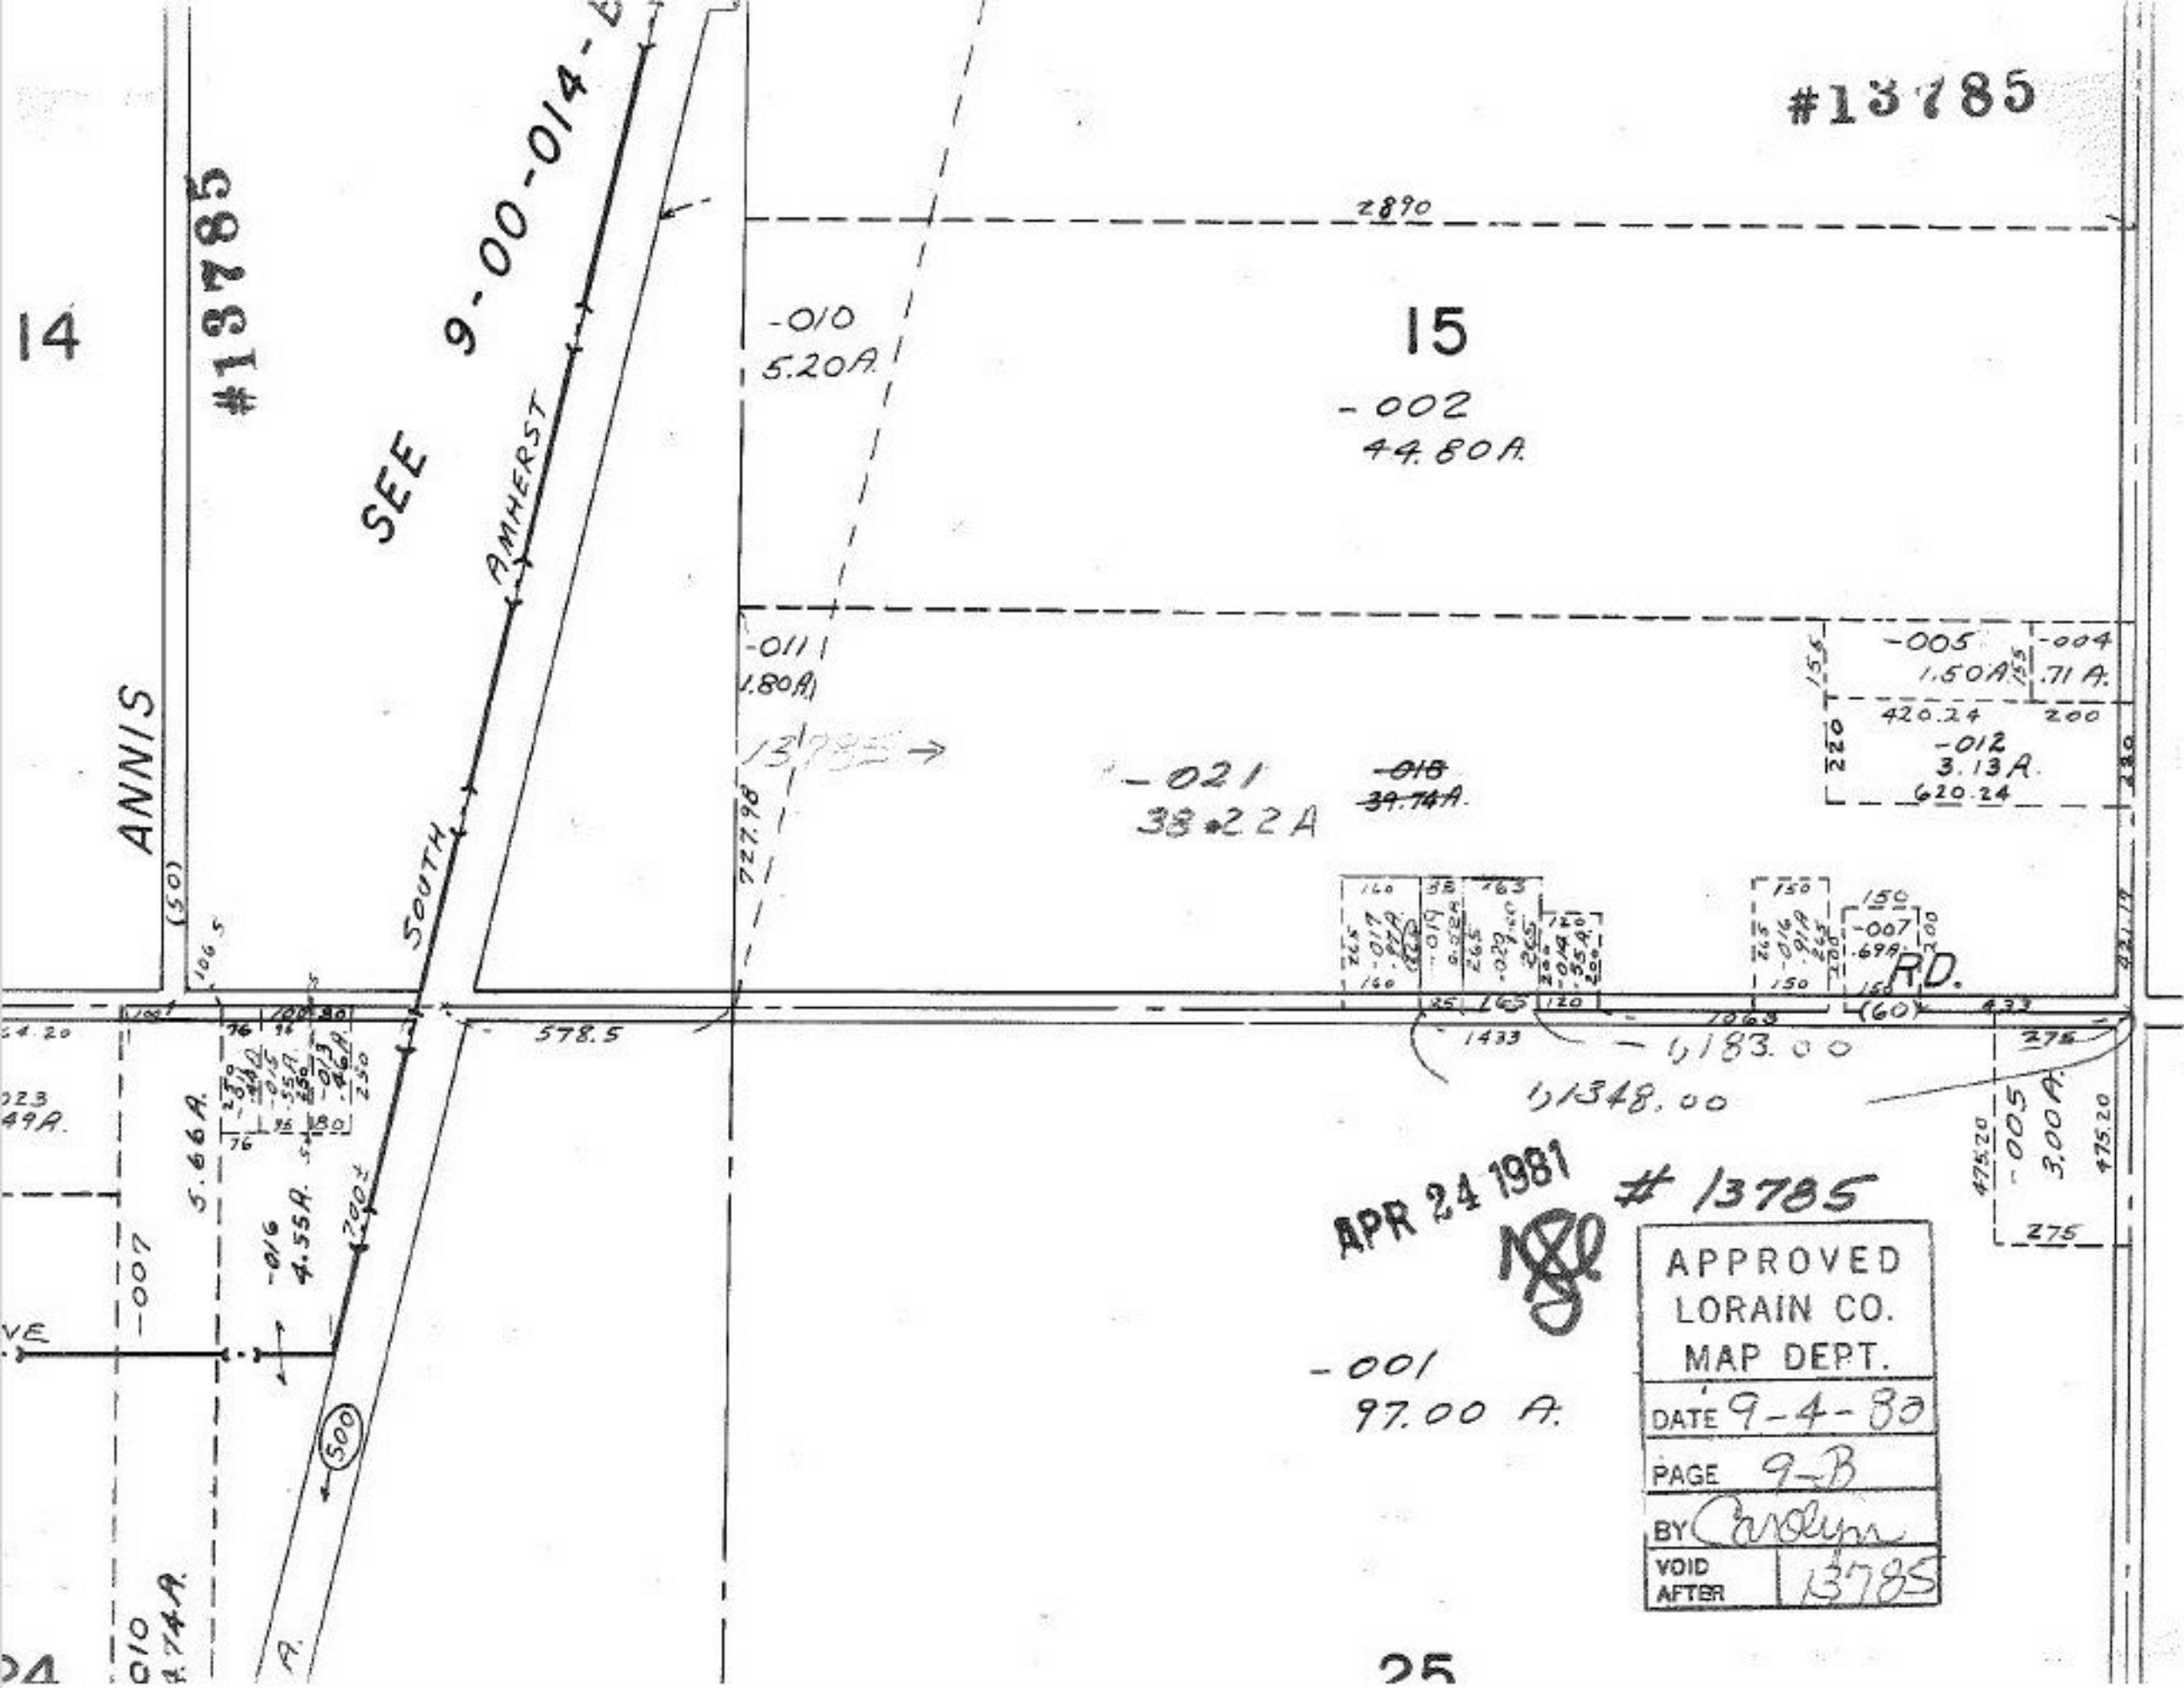

#13785
14
#13785
SEE 9-00-014-B
AMHERST
SOUTH
ANNIS
2890
-010
5.20A.
15
-002
44.80A.
-011
1.80A.
13785
-021
38.22A
~~-018~~
~~39.74A.~~
-005
1.50A.
-004
.71A.
420.24
200
-012
3.13A.
620.24
-007
.69A.
RD.
578.5
1,183.00
1,1348.00
-005
3.00A.
475.20
275
-001
97.00 A.
APR 24 1981
13785
APPROVED
LORAIN CO.
MAP DEPT.
DATE 9-4-80
PAGE 9-B
BY Carolyn
VOID AFTER 13785
-007
5.66A.
-016
4.55A.
500
24
25