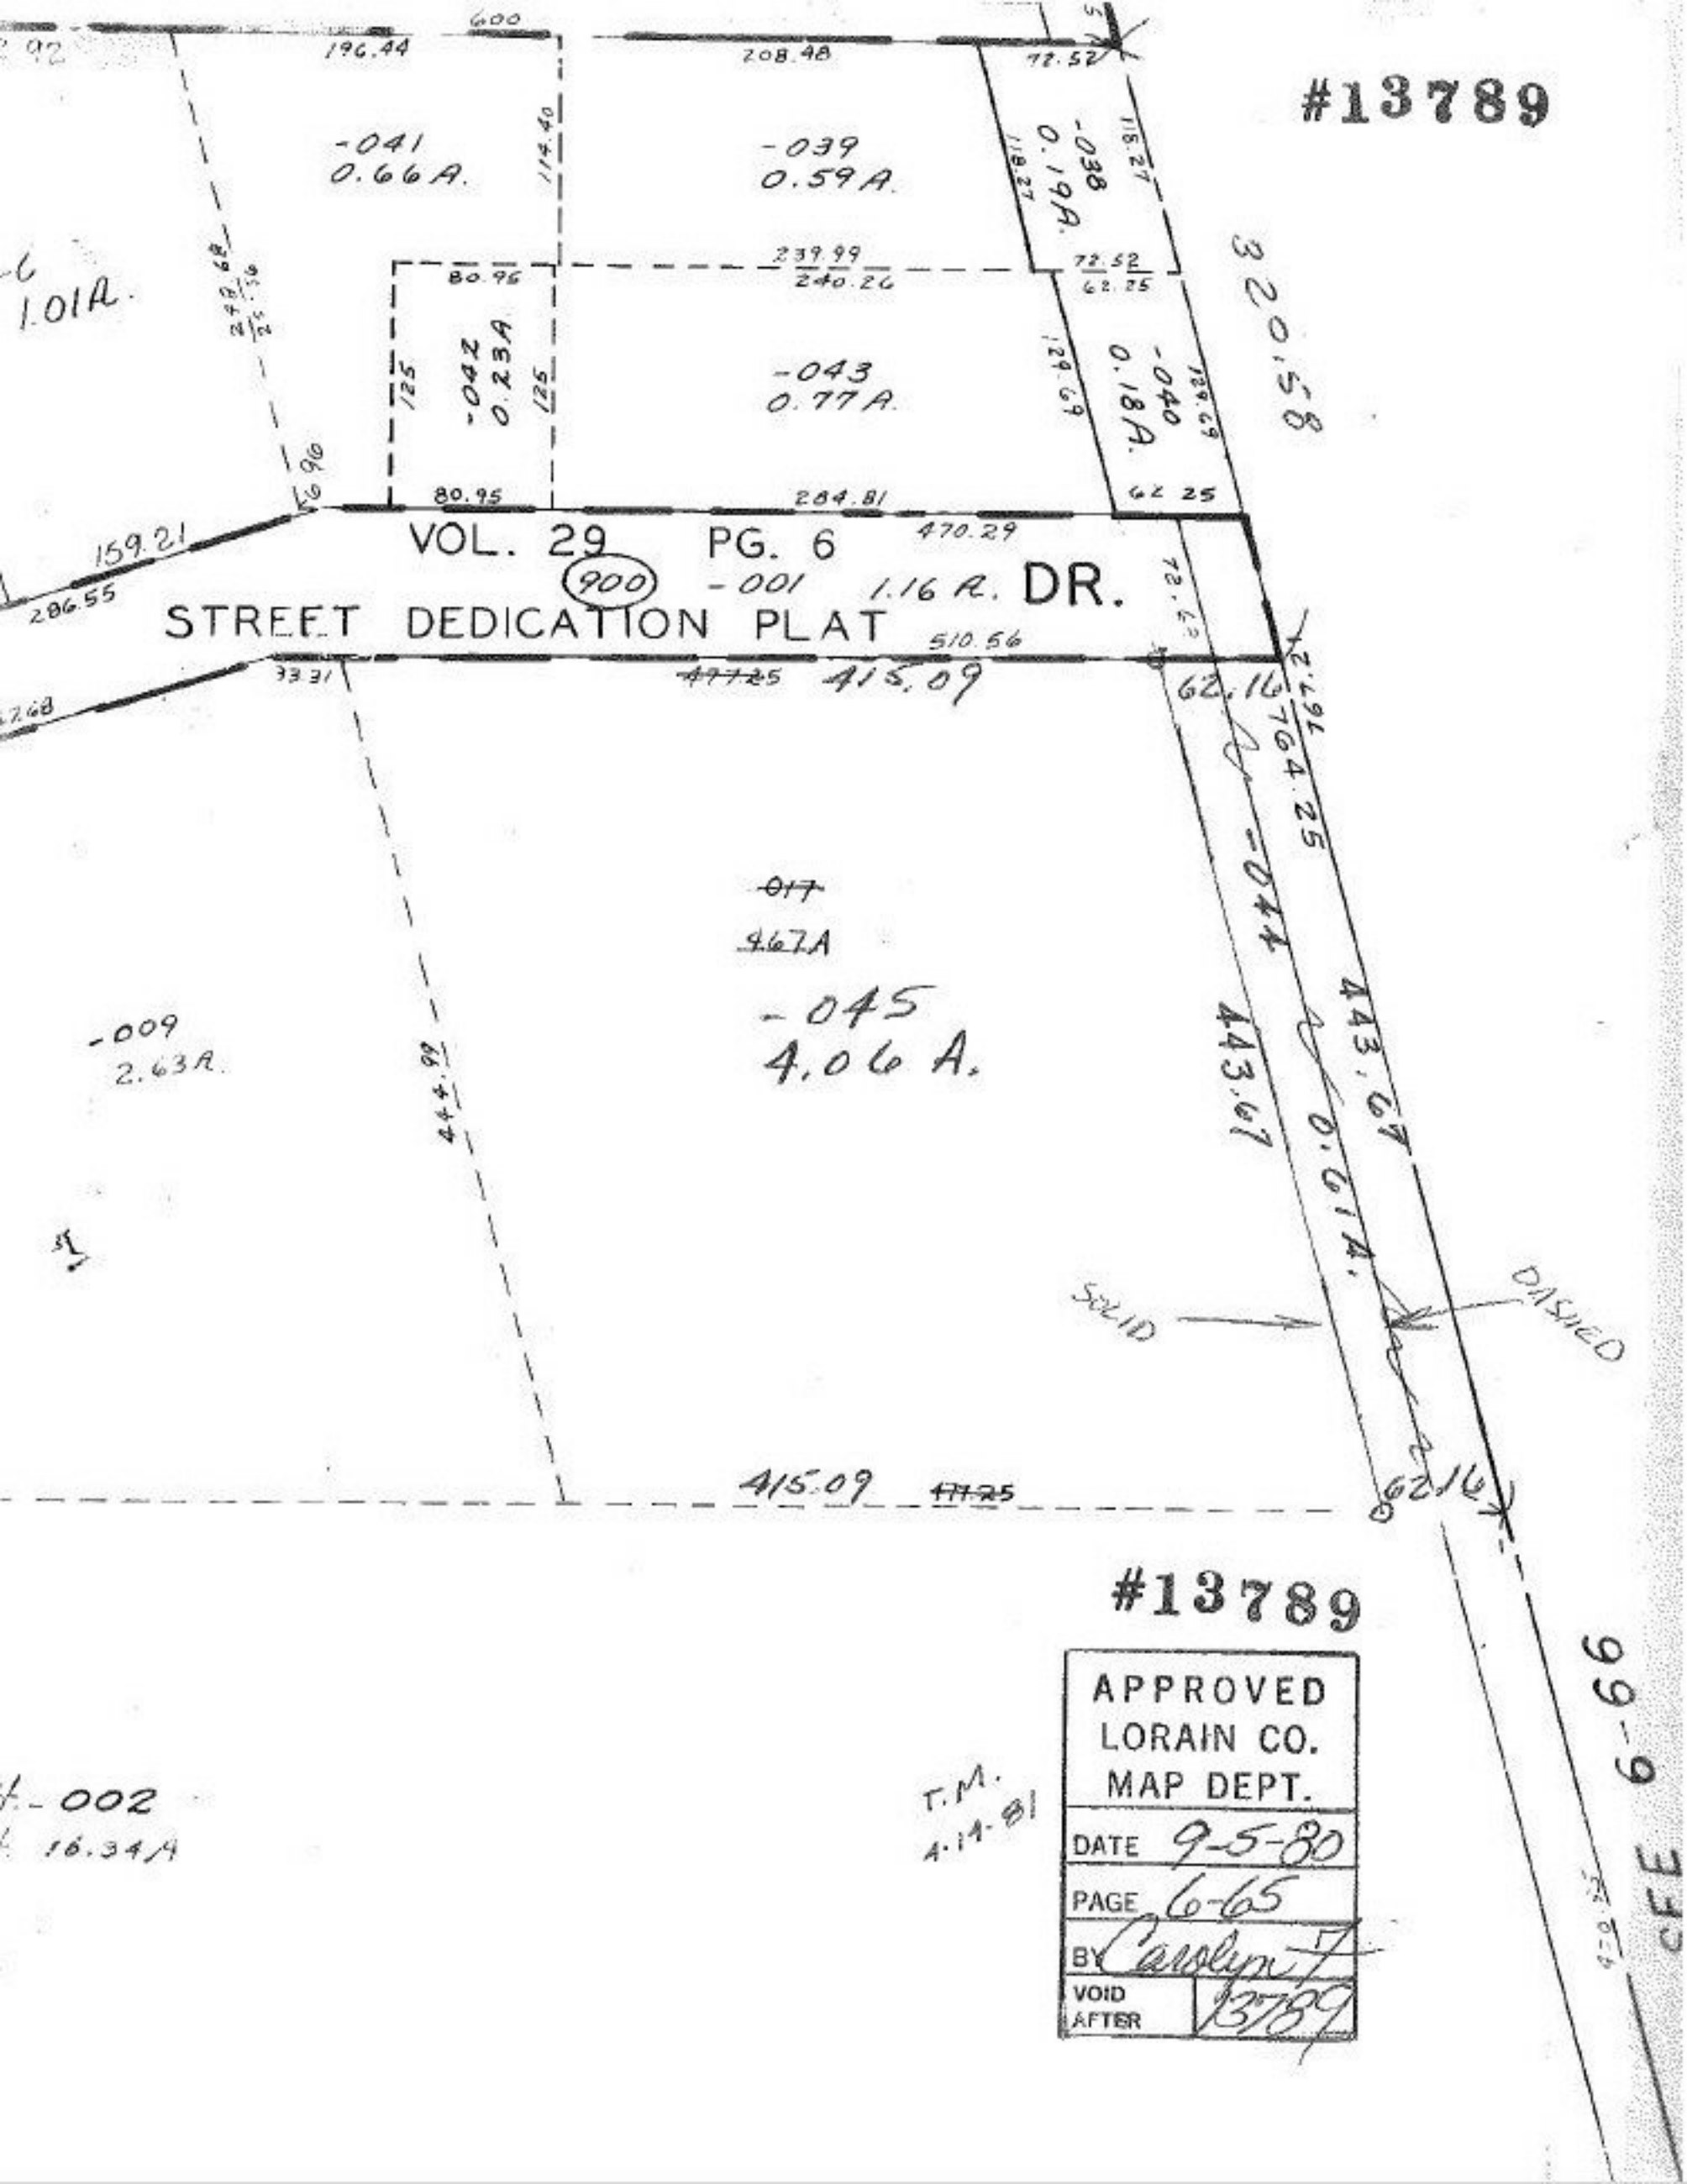
#13789
600
196.44
208.48
72.52
-041
0.66 A.
-039
0.59 A.
-038
0.19 A.
118.27
114.40
239.99
240.26
80.95
72.52
62.25
1.01 A.
-042
0.23 A
125
-043
0.77 A.
129.69
-040
0.18 A.
320.58
80.95
284.81
62.25
159.21
VOL. 29 PG. 6
470.29
286.55
900
-001
1.16 A.
DR.
STREET DEDICATION PLAT
510.56
33.31
415.09
62.16
764.25
-044
443.67
443.67
0.61 A.
-009
2.63 A.
-045
4.06 A.
444.99
SOLID
DASHED
415.09
62.16
#13789
APPROVED
LORAIN CO.
MAP DEPT.
DATE 9-5-80
PAGE 6-65
BY Carolyn F
VOID AFTER 13789
T.M.
4-14-81
-002
16.34 A
99-9
CFE