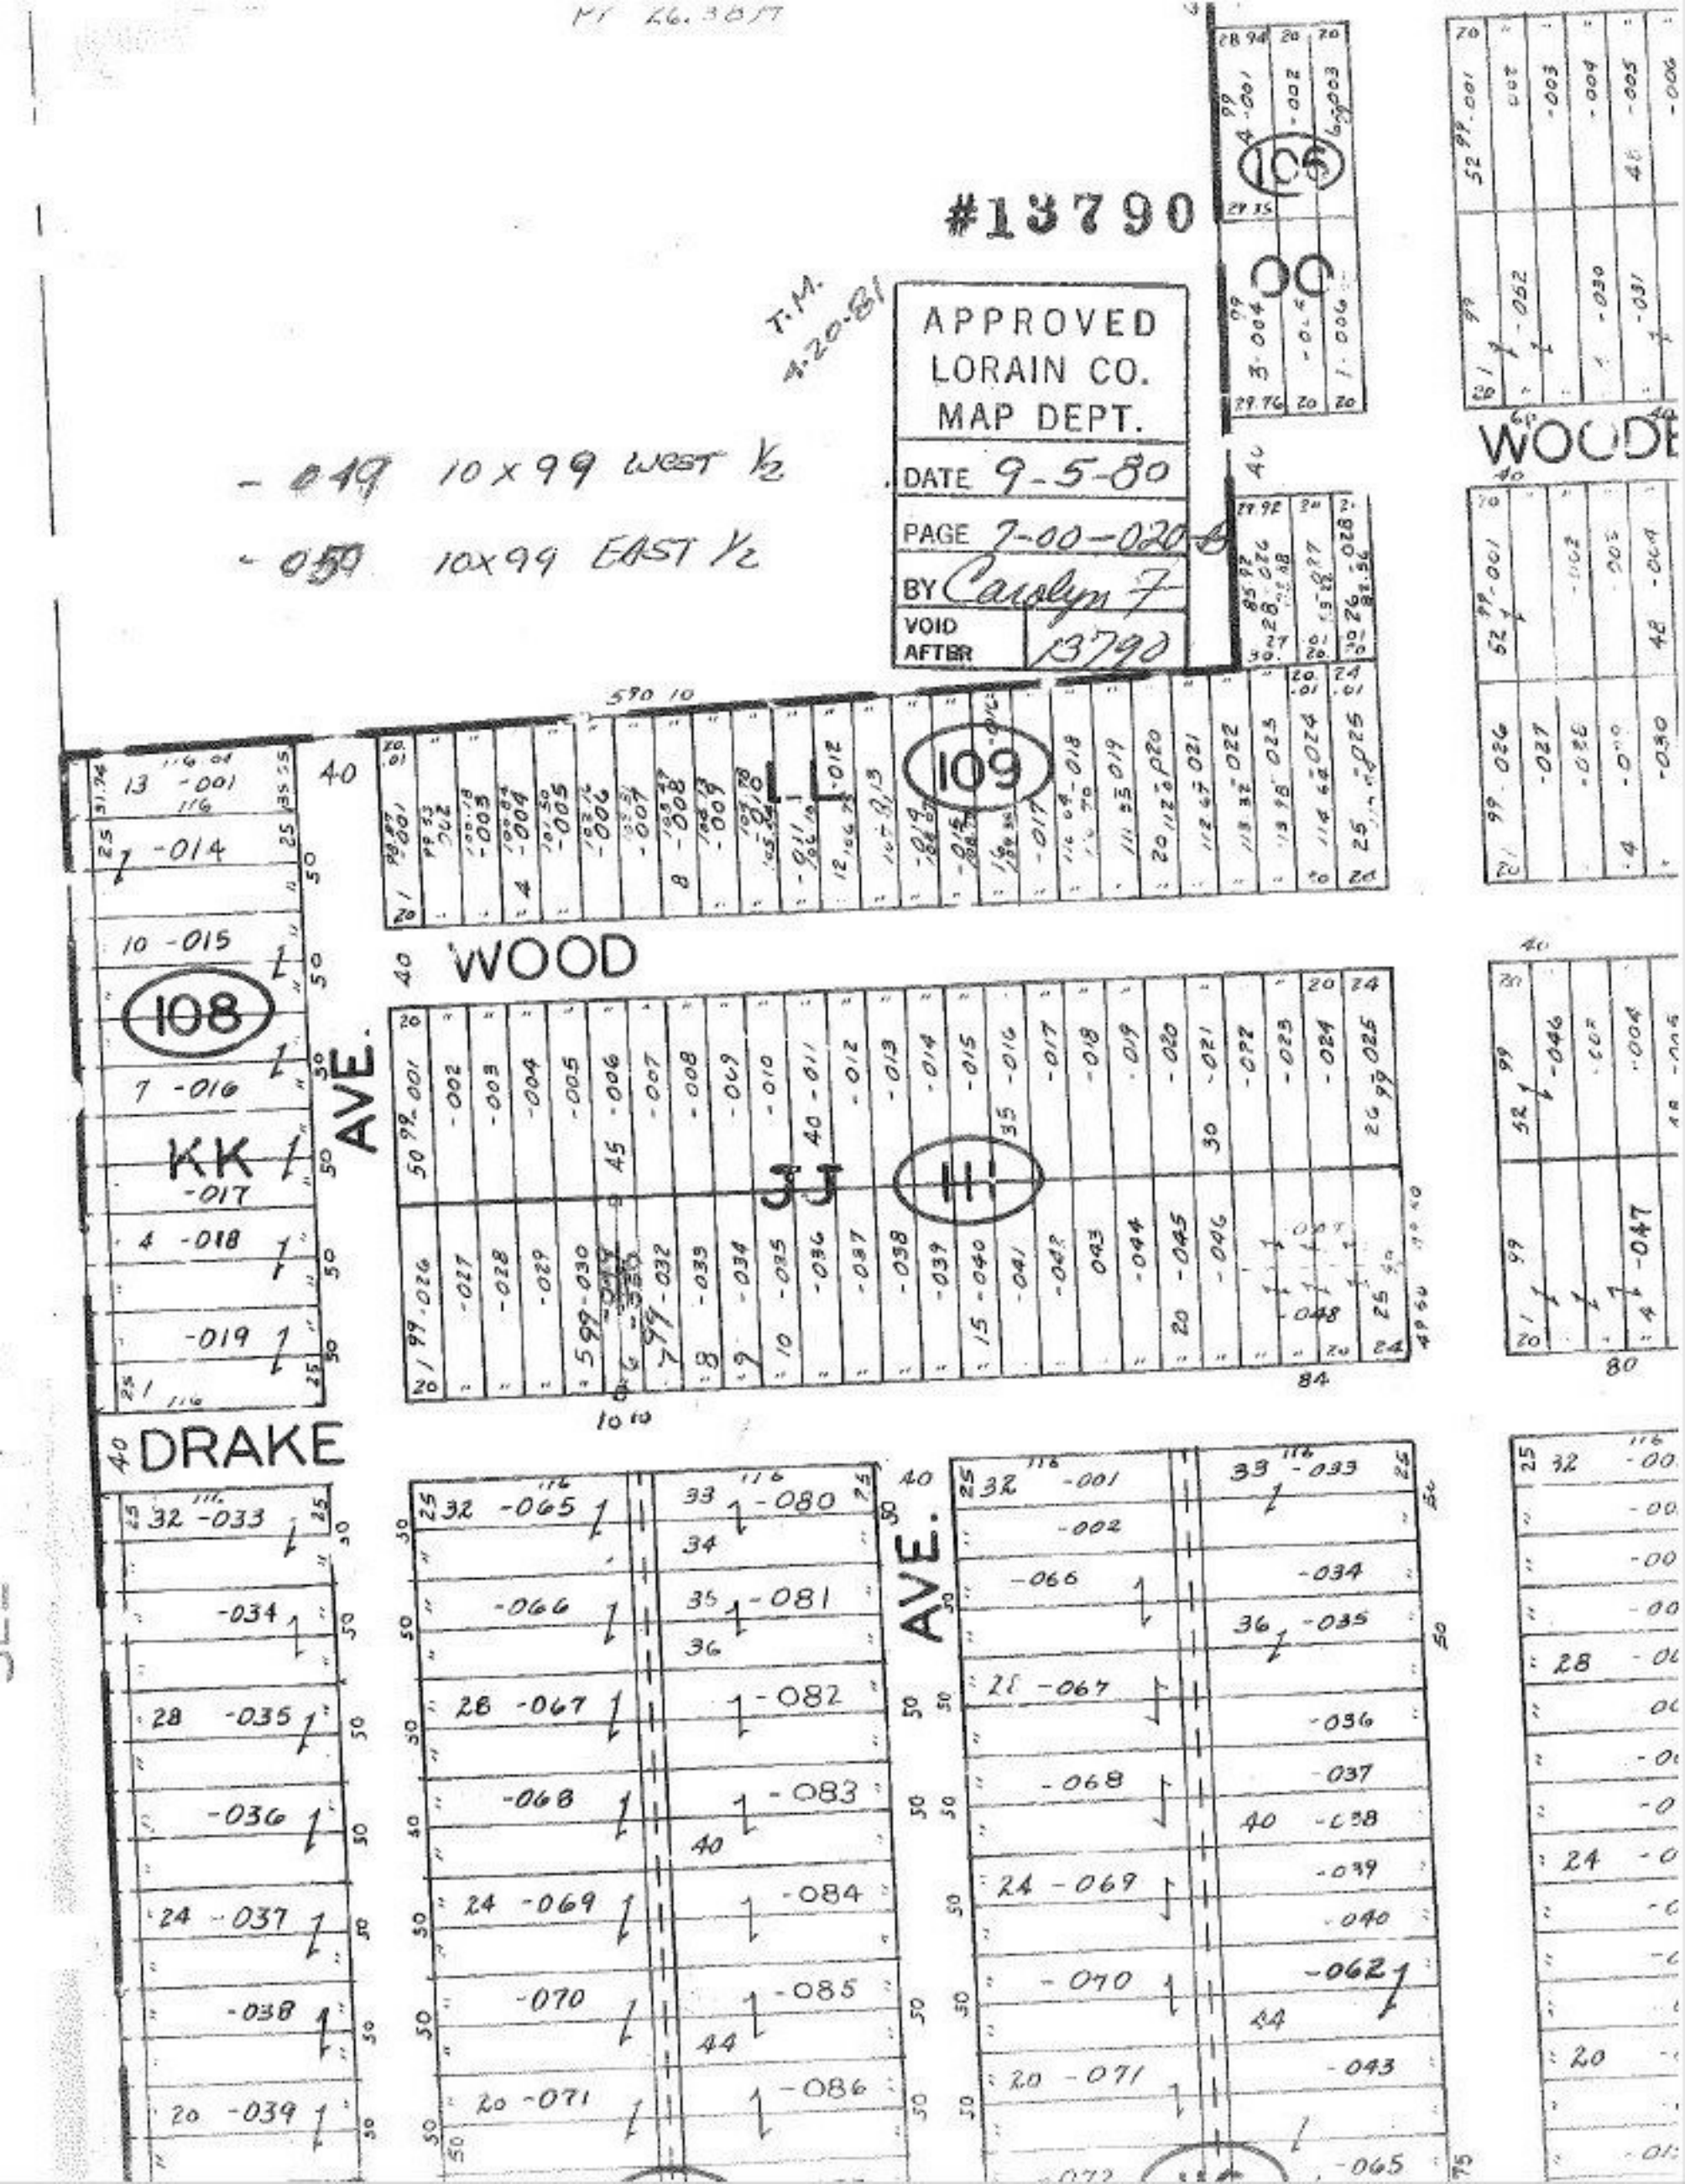

#13790
T.M. 4-20-81
APPROVED
LORAIN CO.
MAP DEPT.
DATE 9-5-80
PAGE 7-00-020-B
BY Carolyn F
VOID AFTER 13790
- 049 10 x 99 WEST 1/2
- 050 10x99 EAST 1/2
WOOD
WOOD
DRAKE
AVE.
AVE.
KK
LL
JJ
108
109
106