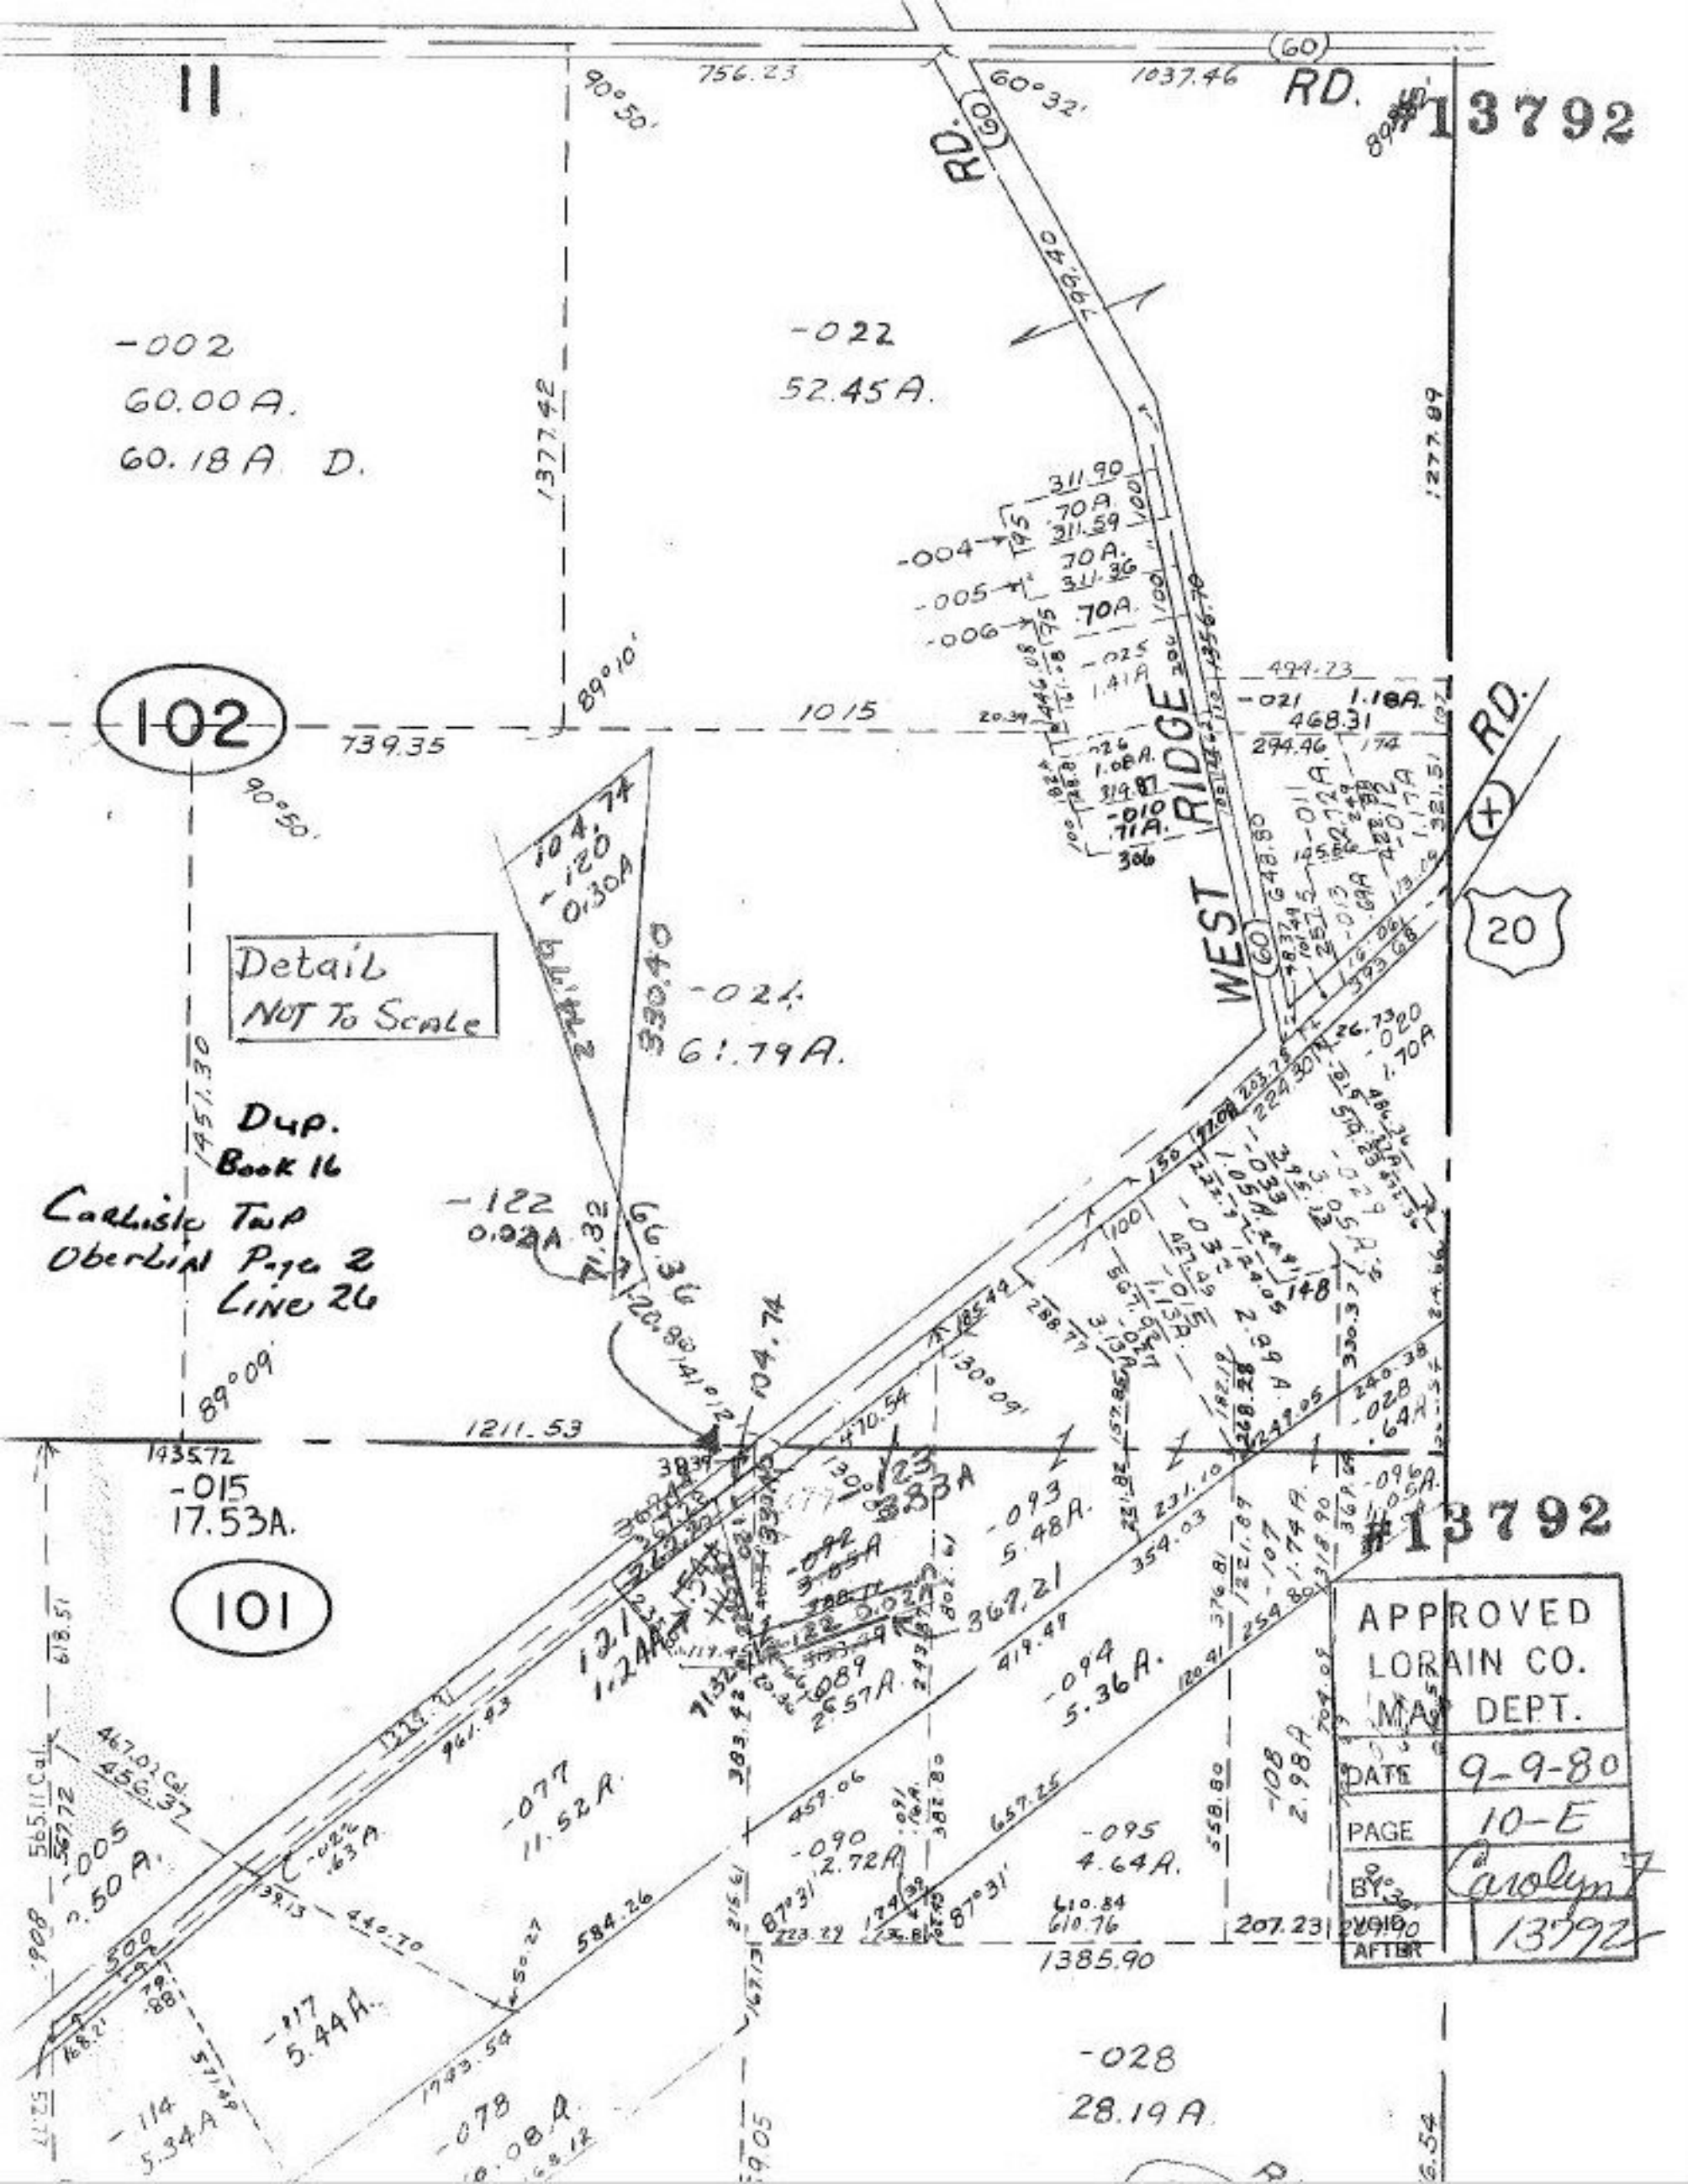

11
#13792
RD.
60
-002
60.00A.
60.18A D.
-022
52.45A.
1377.42
1277.89
102
739.35
1015
89°10'
90°50'
WEST RIDGE
RD.
20
Detail
NOT To Scale
-024
61.79A.
Dup.
Book 16
Carlisle Twp
Oberlin Page 2
Line 26
-122
0.02A
1211.53
-015
17.53A.
101
-093
5.48A.
-094
5.36A.
-077
11.52A.
-095
4.64A.
-117
5.44A.
-114
5.34A
-078
-028
28.19A
1385.90
#13792
APPROVED
LORAIN CO.
MAP DEPT.
DATE 9-9-80
PAGE 10-E
BY Carolyn
VOID AFTER 13792