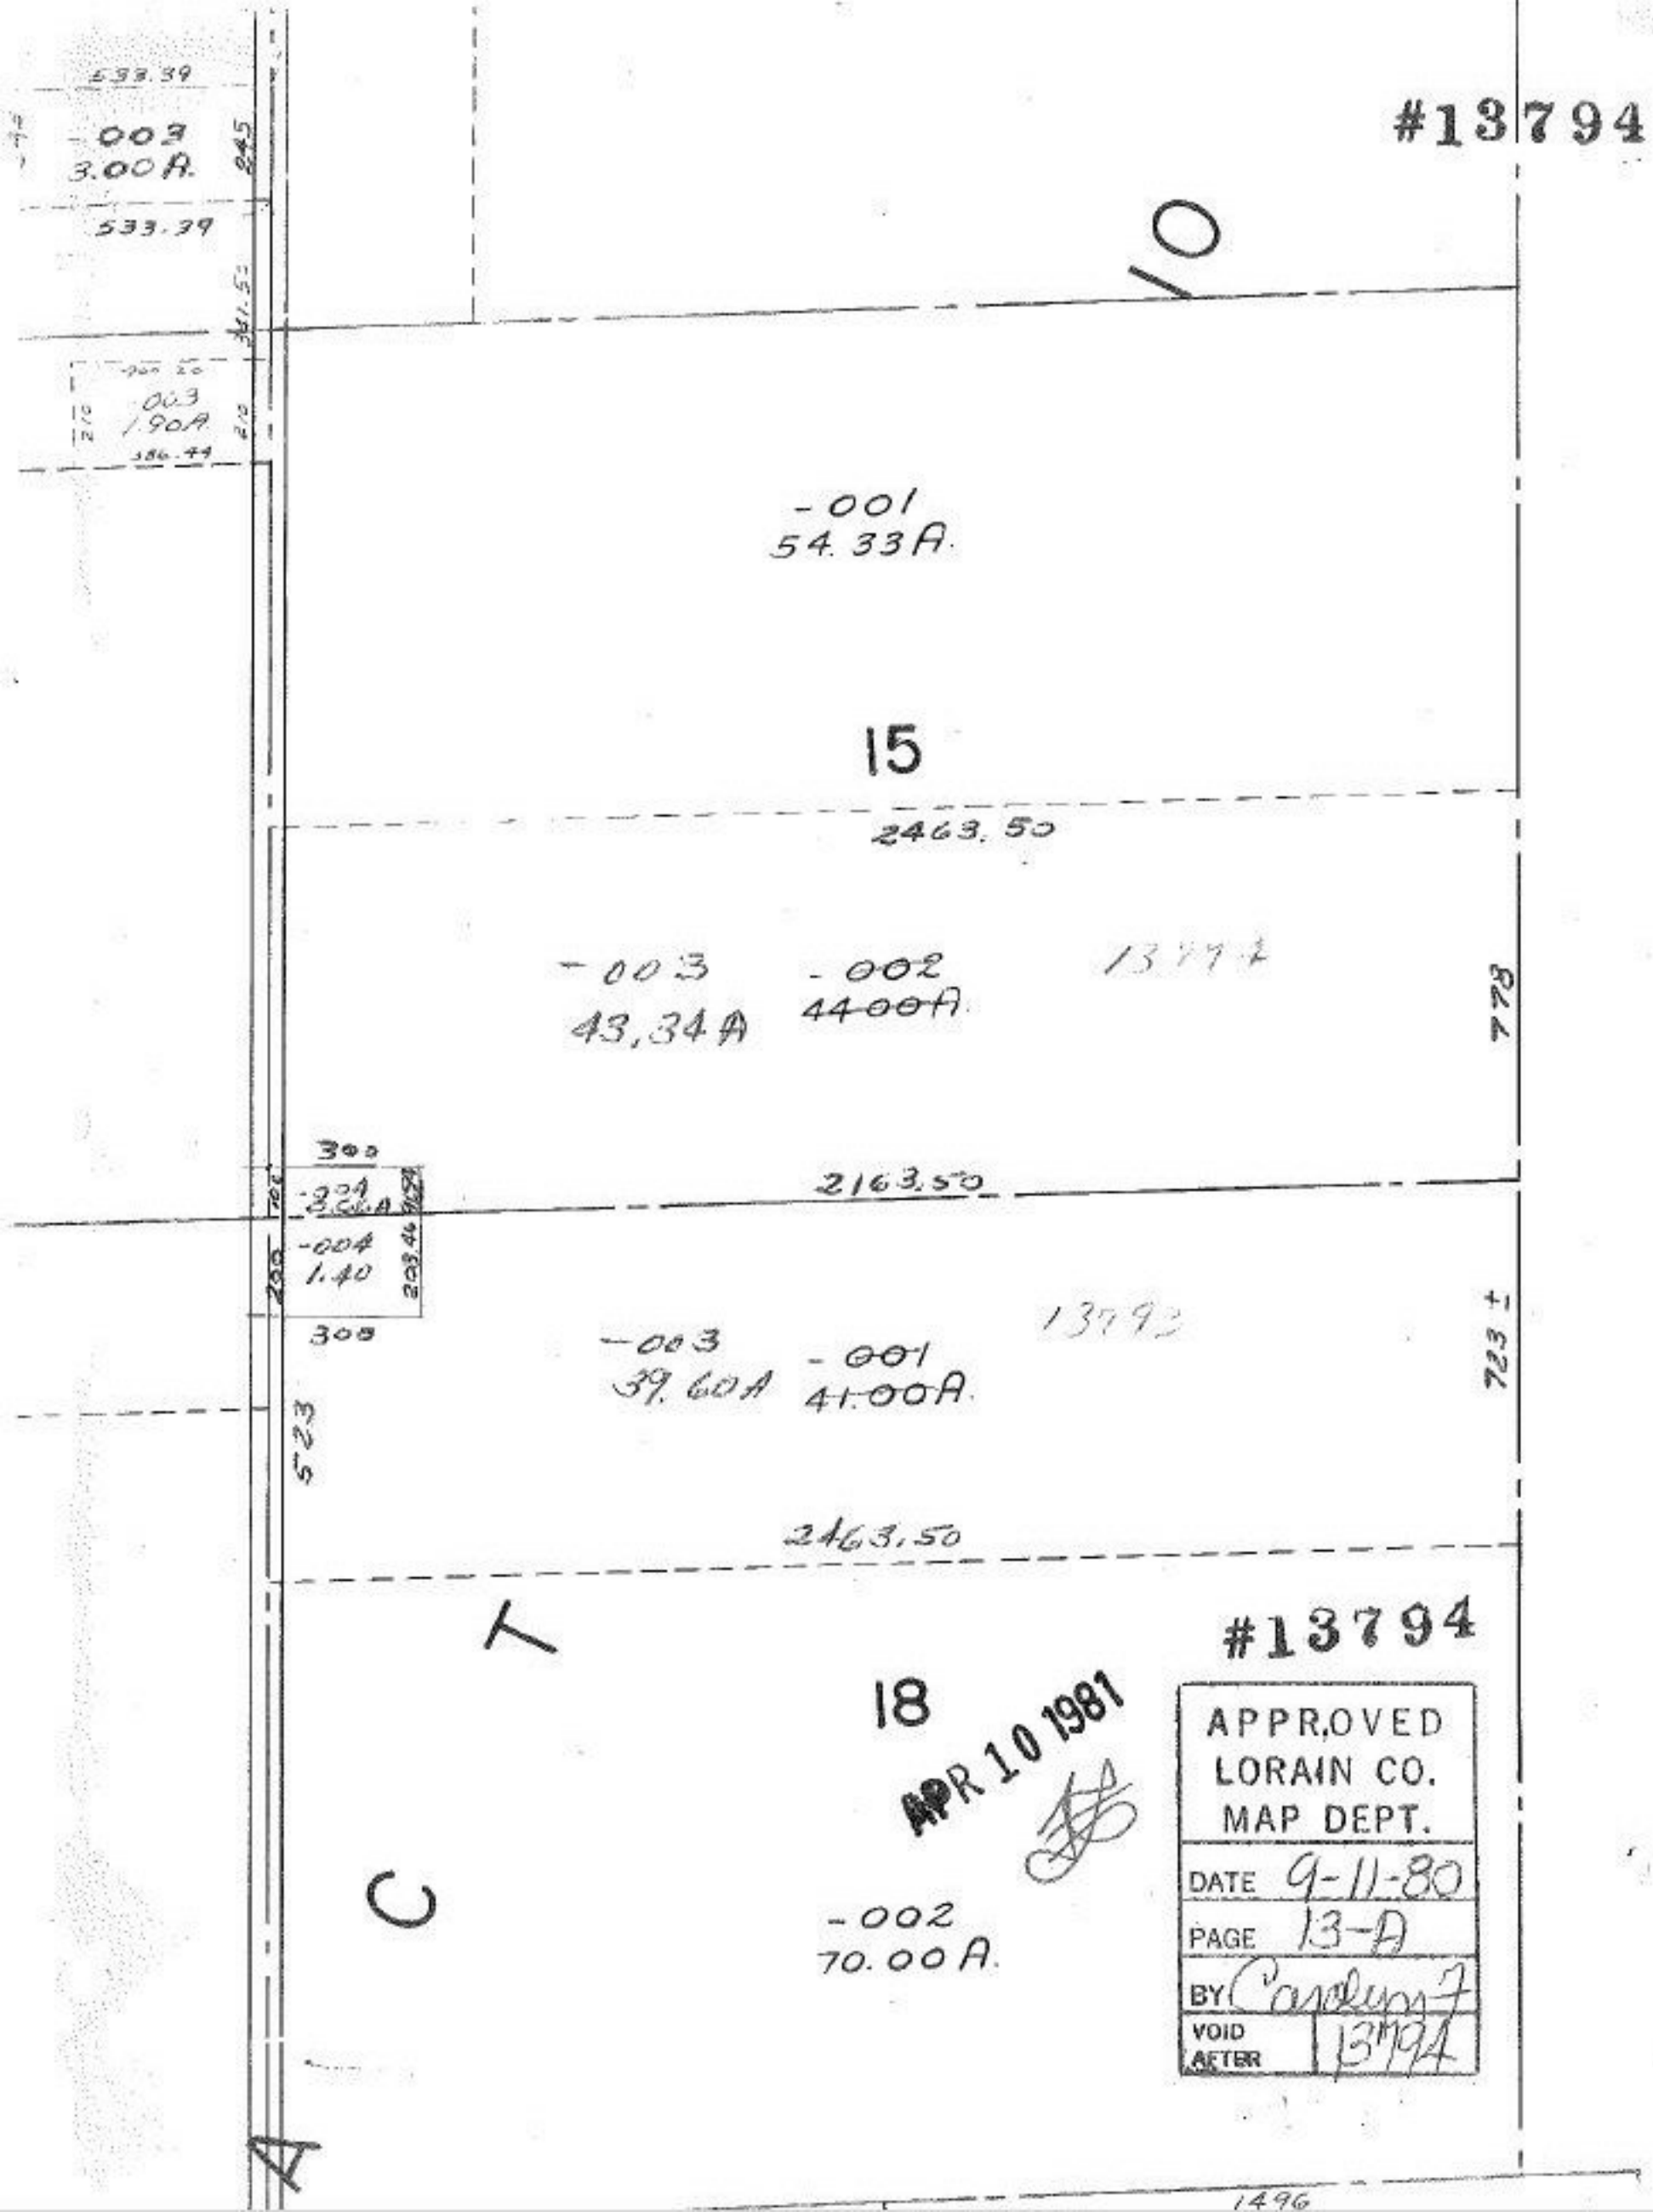

#13794
533.39
-003
3.00A.
533.39
10
-001
54.33A.
15
2463.50
-003
43.34A
-002
44.00A.
13794
778
300
2163.50
-004
1.40
300
-003
39.60A
-001
41.00A.
13792
723 ±
523
2463.50
#13794
18
APR 10 1981
APPROVED
LORAIN CO.
MAP DEPT.
DATE 9-11-80
PAGE 13-A
BY Carolyn F
VOID AFTER 13794
-002
70.00A.
1496