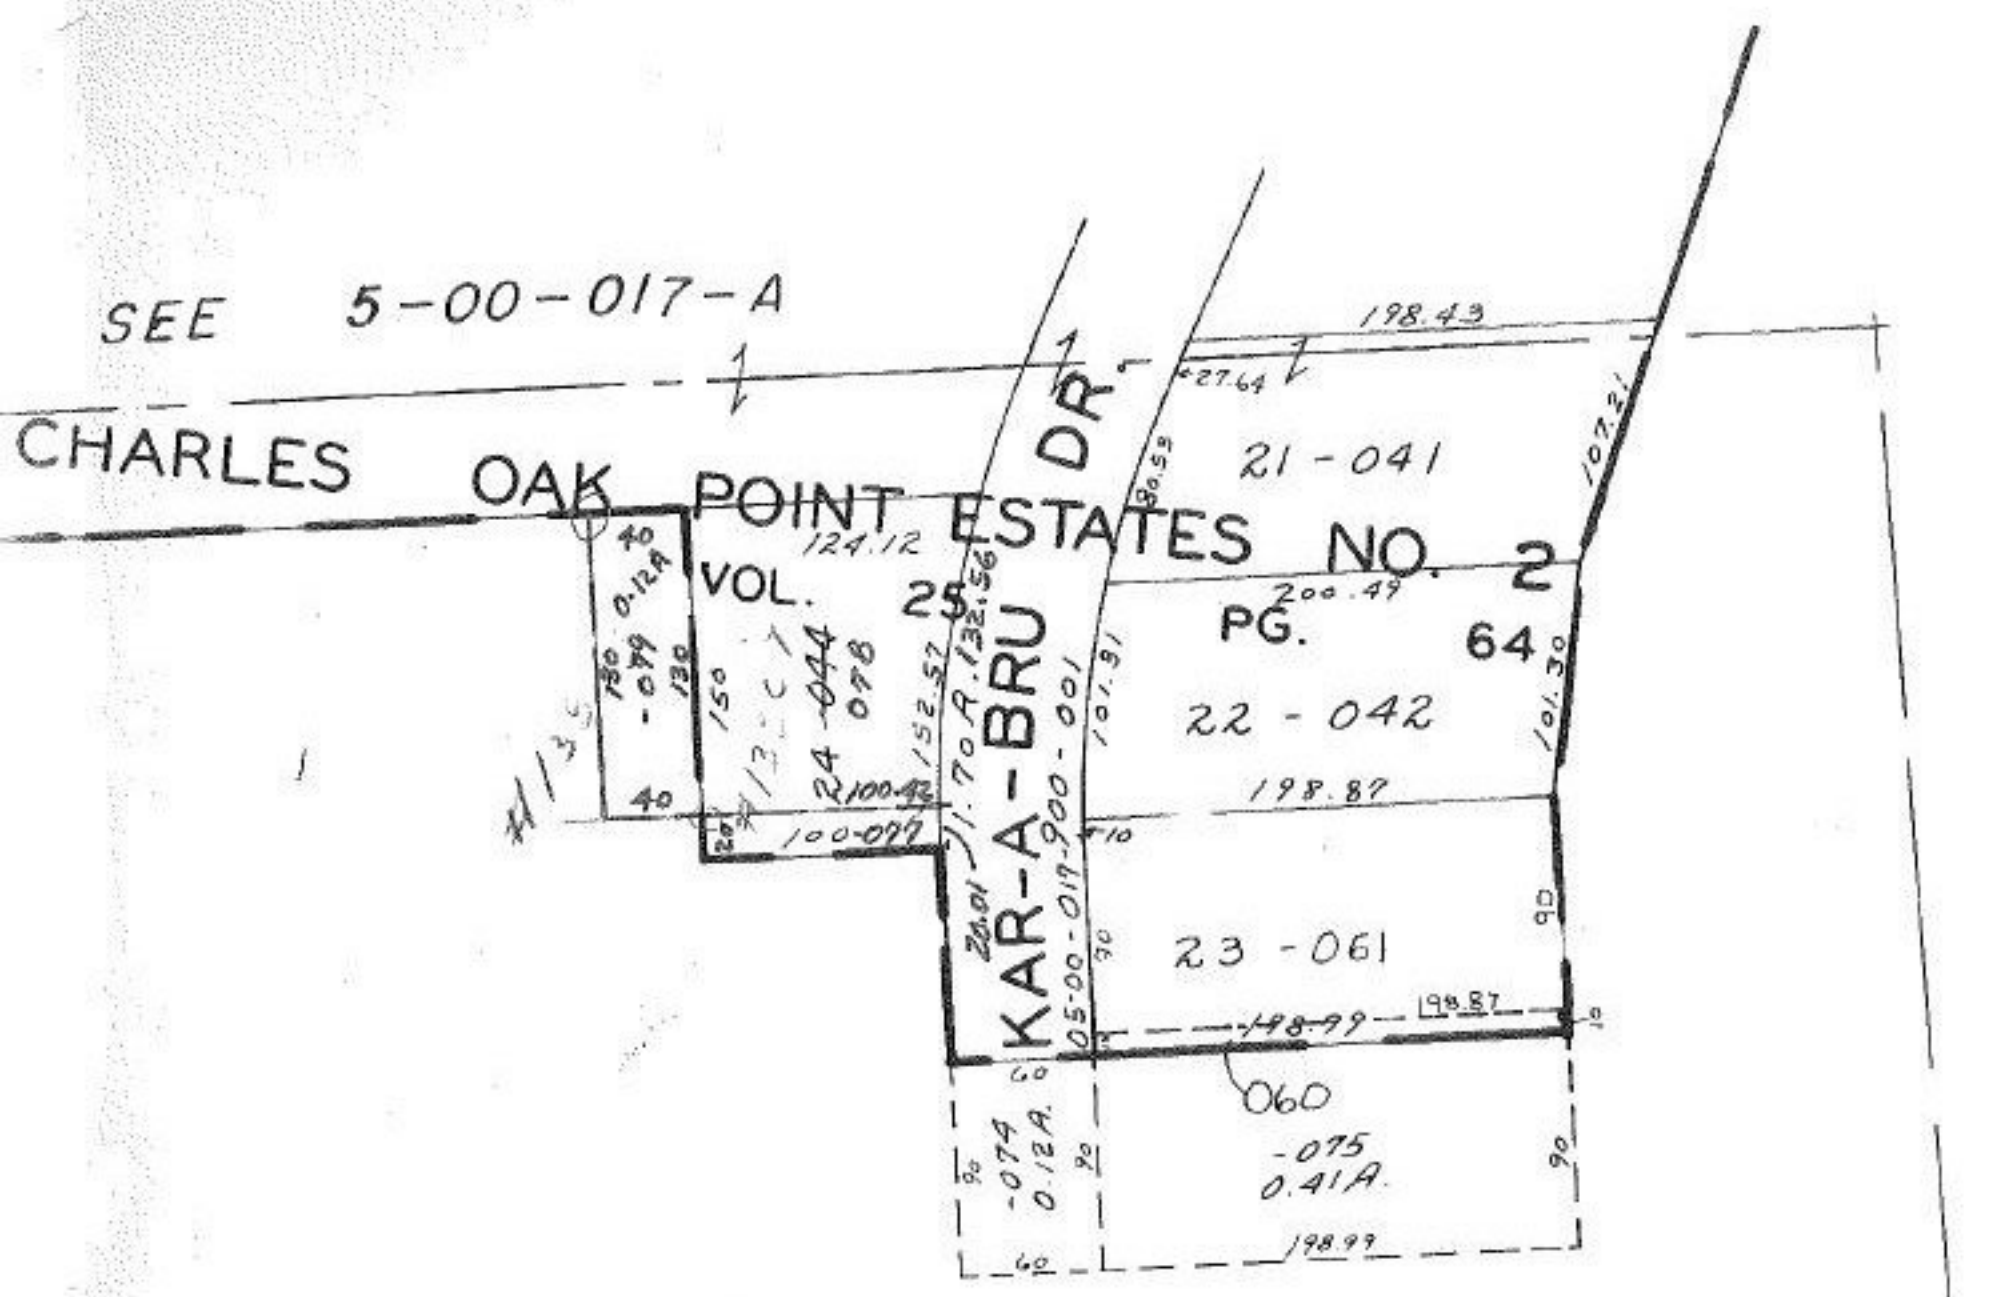
SEE 5-00-017-A
CHARLES OAK POINT ESTATES NO. 2
VOL. 25
PG. 64
KAR-A-BRU DR.
21-041
22-042
23-061
198.43
27.64
124.12
200.49
198.87
198.99
107.21
101.30
100.42
100-077
152.57
132.56
1.70 A.
05-00-017-900-001
20.01
-074
0.12A.
-075
0.41A.
060
#13807
#13808
APPROVED
LORAIN CO.
MAP DEPT.
DATE 9-11-80
PAGE 5-00-016 A & B
BY
VOID AFTER
T.M.
4.10.81
-080
Pt. ~~-076~~
Pt. ~~46.65A.~~
46.53 A.
CHANGE PAGE 500-016-B