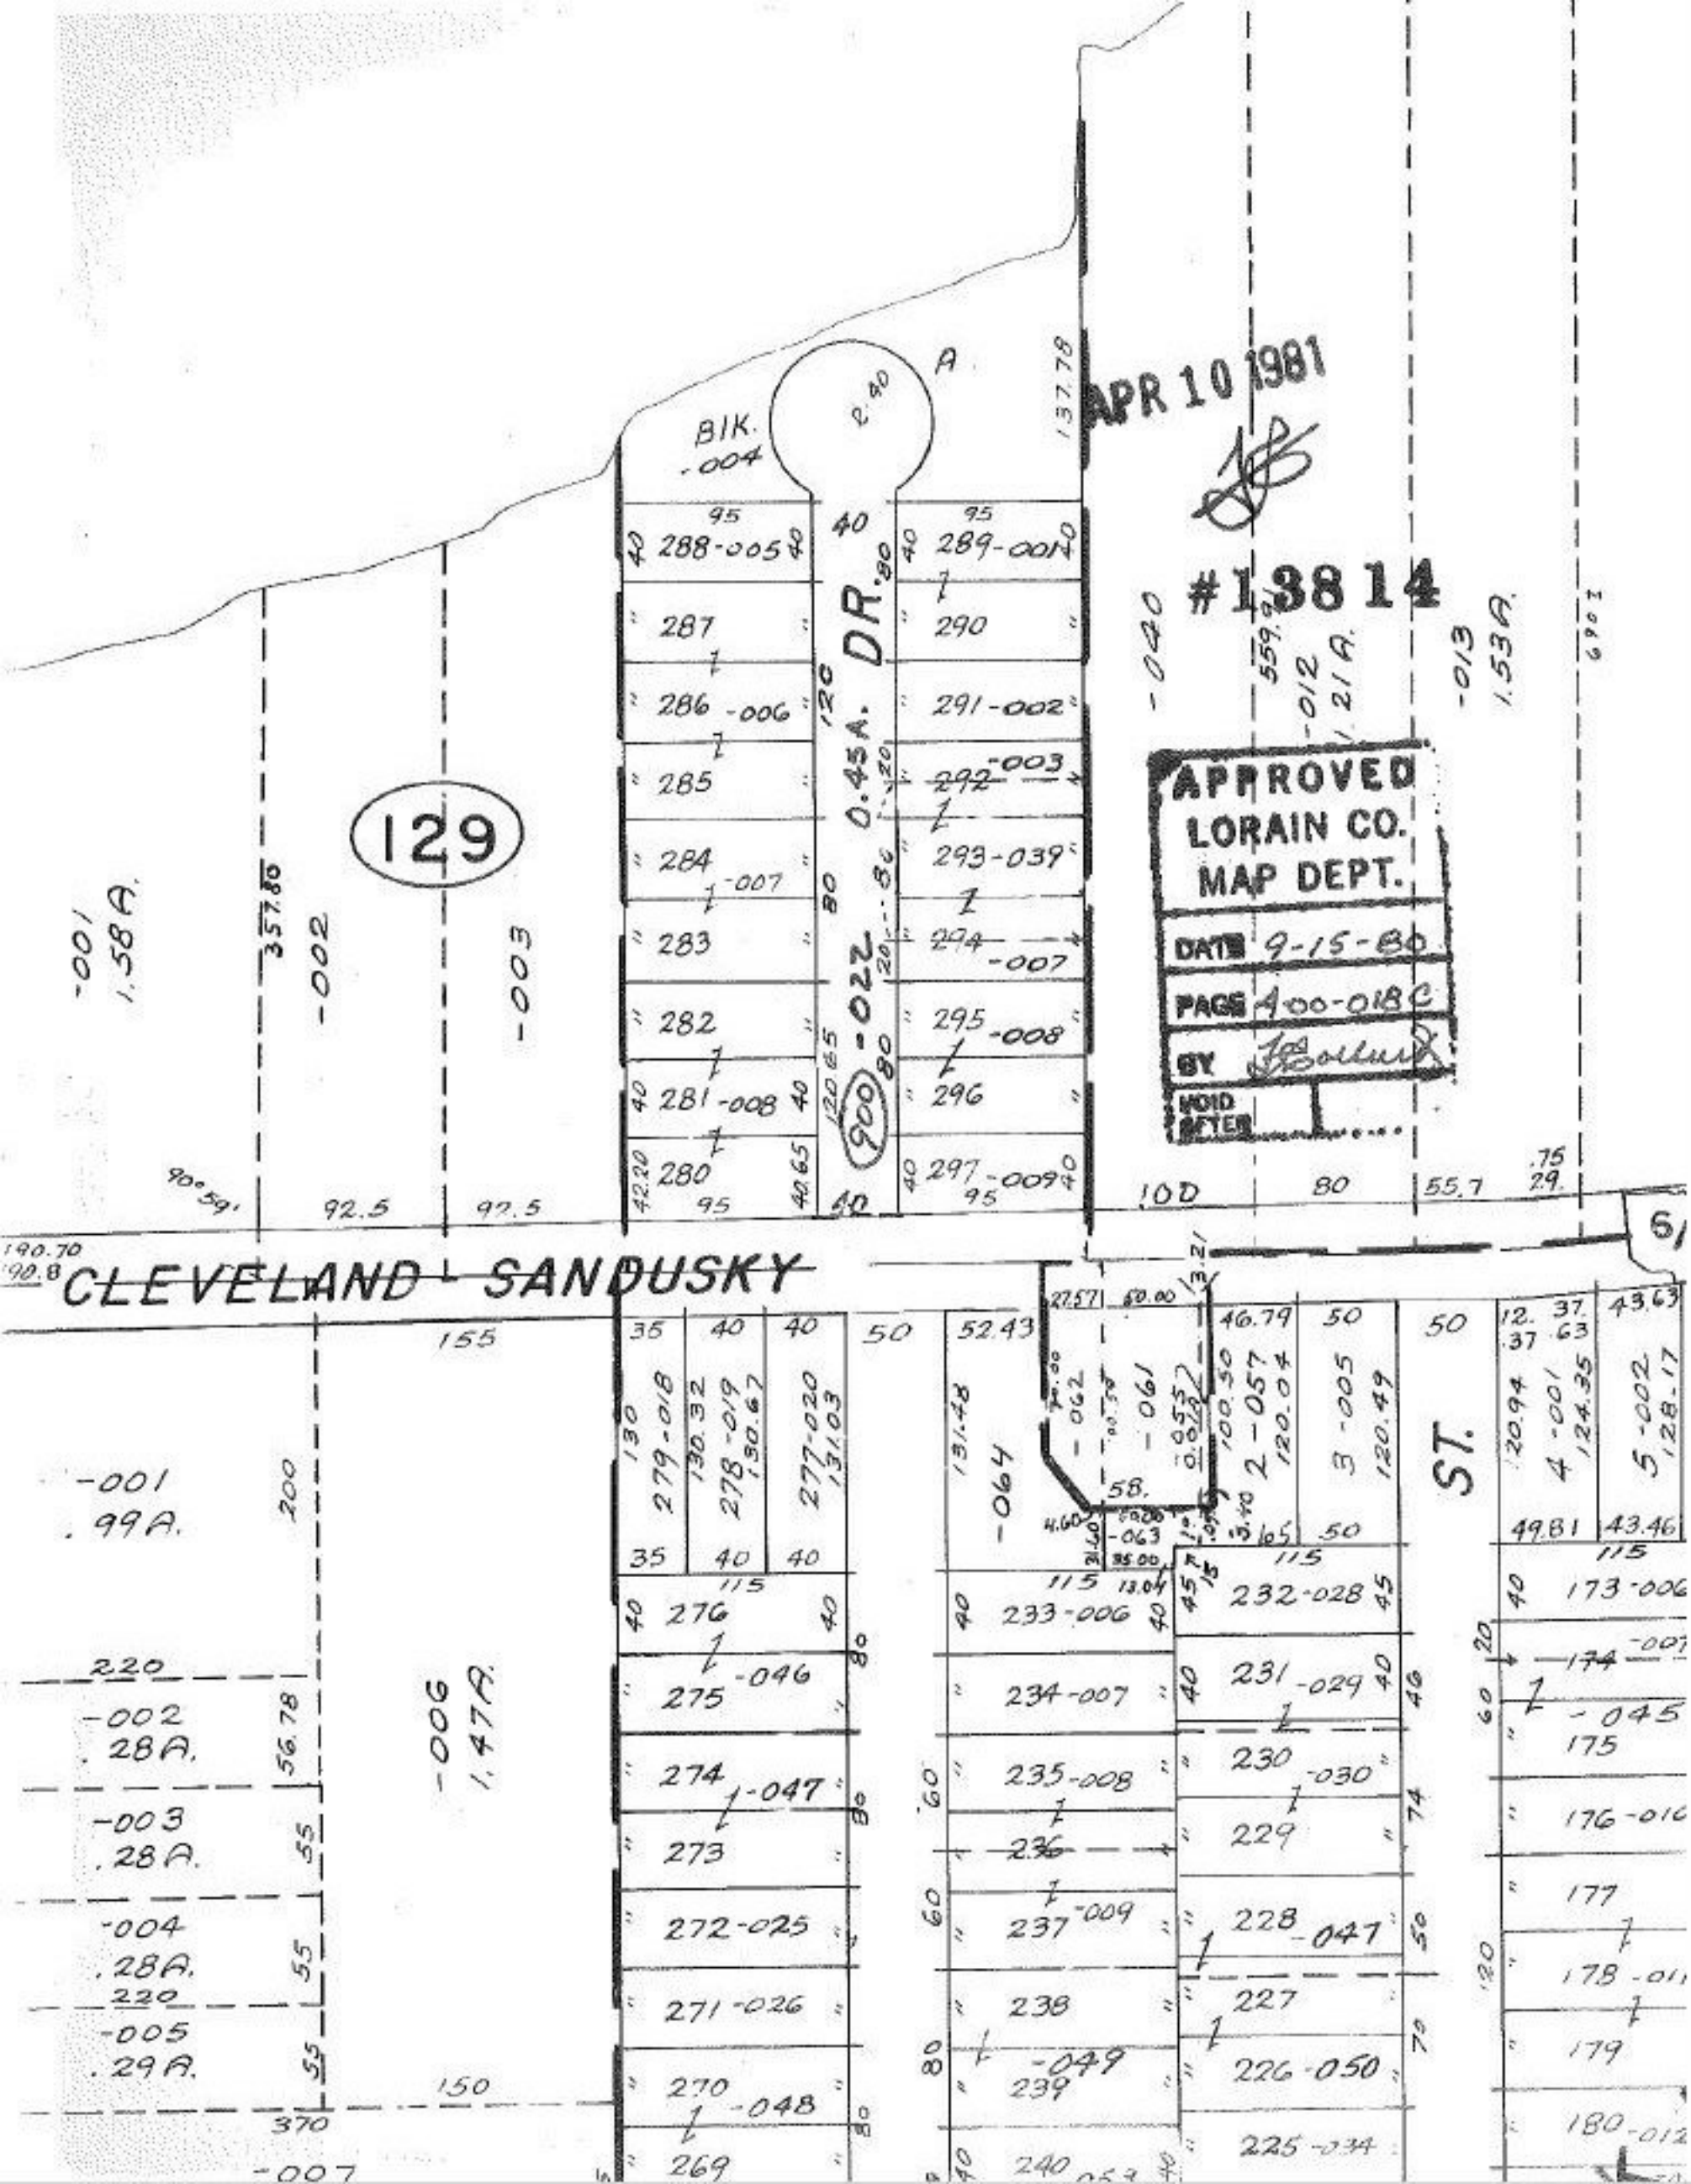
APR 10 1981
#13814
APPROVED
LORAIN CO.
MAP DEPT.
DATE 9-15-80
PAGE 400-018C
BY
VOID AFTER
BLK. -004
DR.
0.45A.
-022
900
129
CLEVELAND - SANDUSKY
ST.
-001 1.58A.
-002
-003
-006 1.47A.
-001 .99A.
-002 .28A.
-003 .28A.
-004 .28A.
-005 .29A.
-007
-040
-012 1.21A.
-013 1.53A.
288-005
289-001
287
290
286-006
291-002
285
292-003
284-007
293-039
283
294-007
282
295-008
281-008
296
280
297-009
279-018
278-019
277-020
276
275-046
274-047
273
272-025
271-026
270-048
269
-064
-062
-061
-063
233-006
234-007
235-008
236
237-009
238
239-049
240
2-057
3-005
4-001
5-002
232-028
231-029
230-030
229
228-047
227
226-050
225-034
173-006
174-007
175-045
176-010
177
178-011
179
180-012