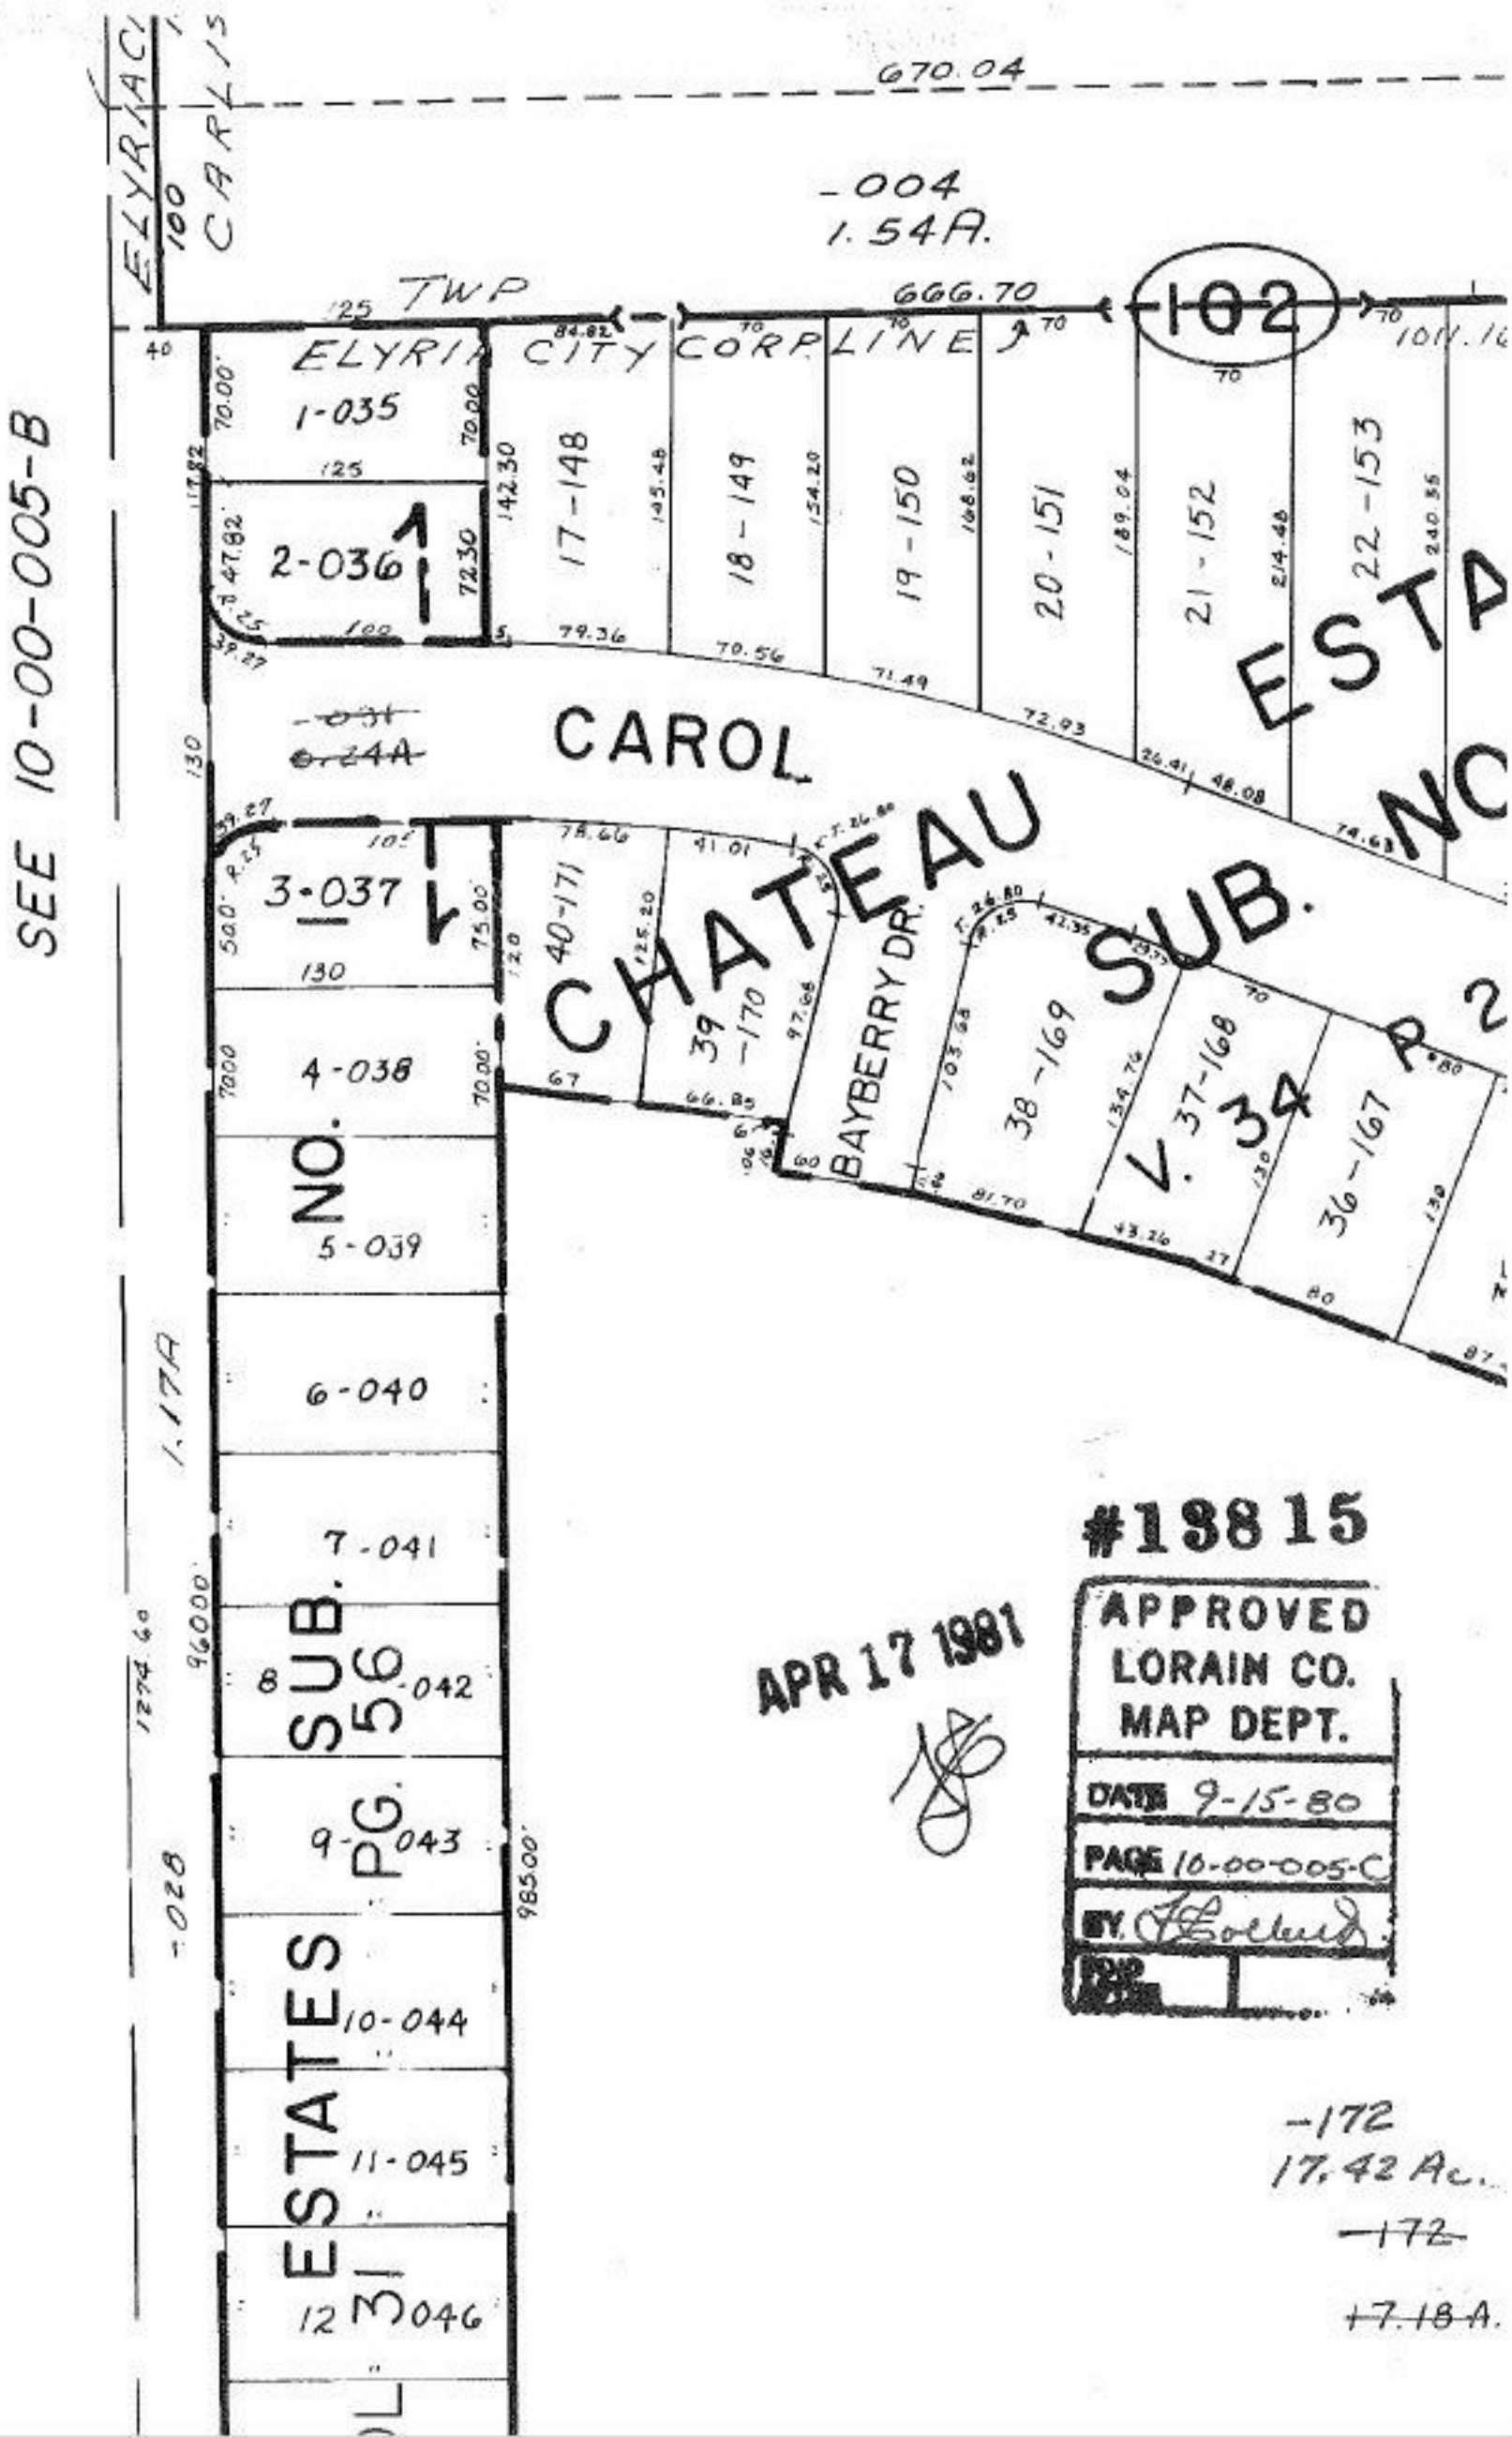

#13815

APPROVED
LORAIN CO.
MAP DEPT.
DATE 9-15-80
PAGE 10-00-005-C
BY [signature]

APR 17 1981