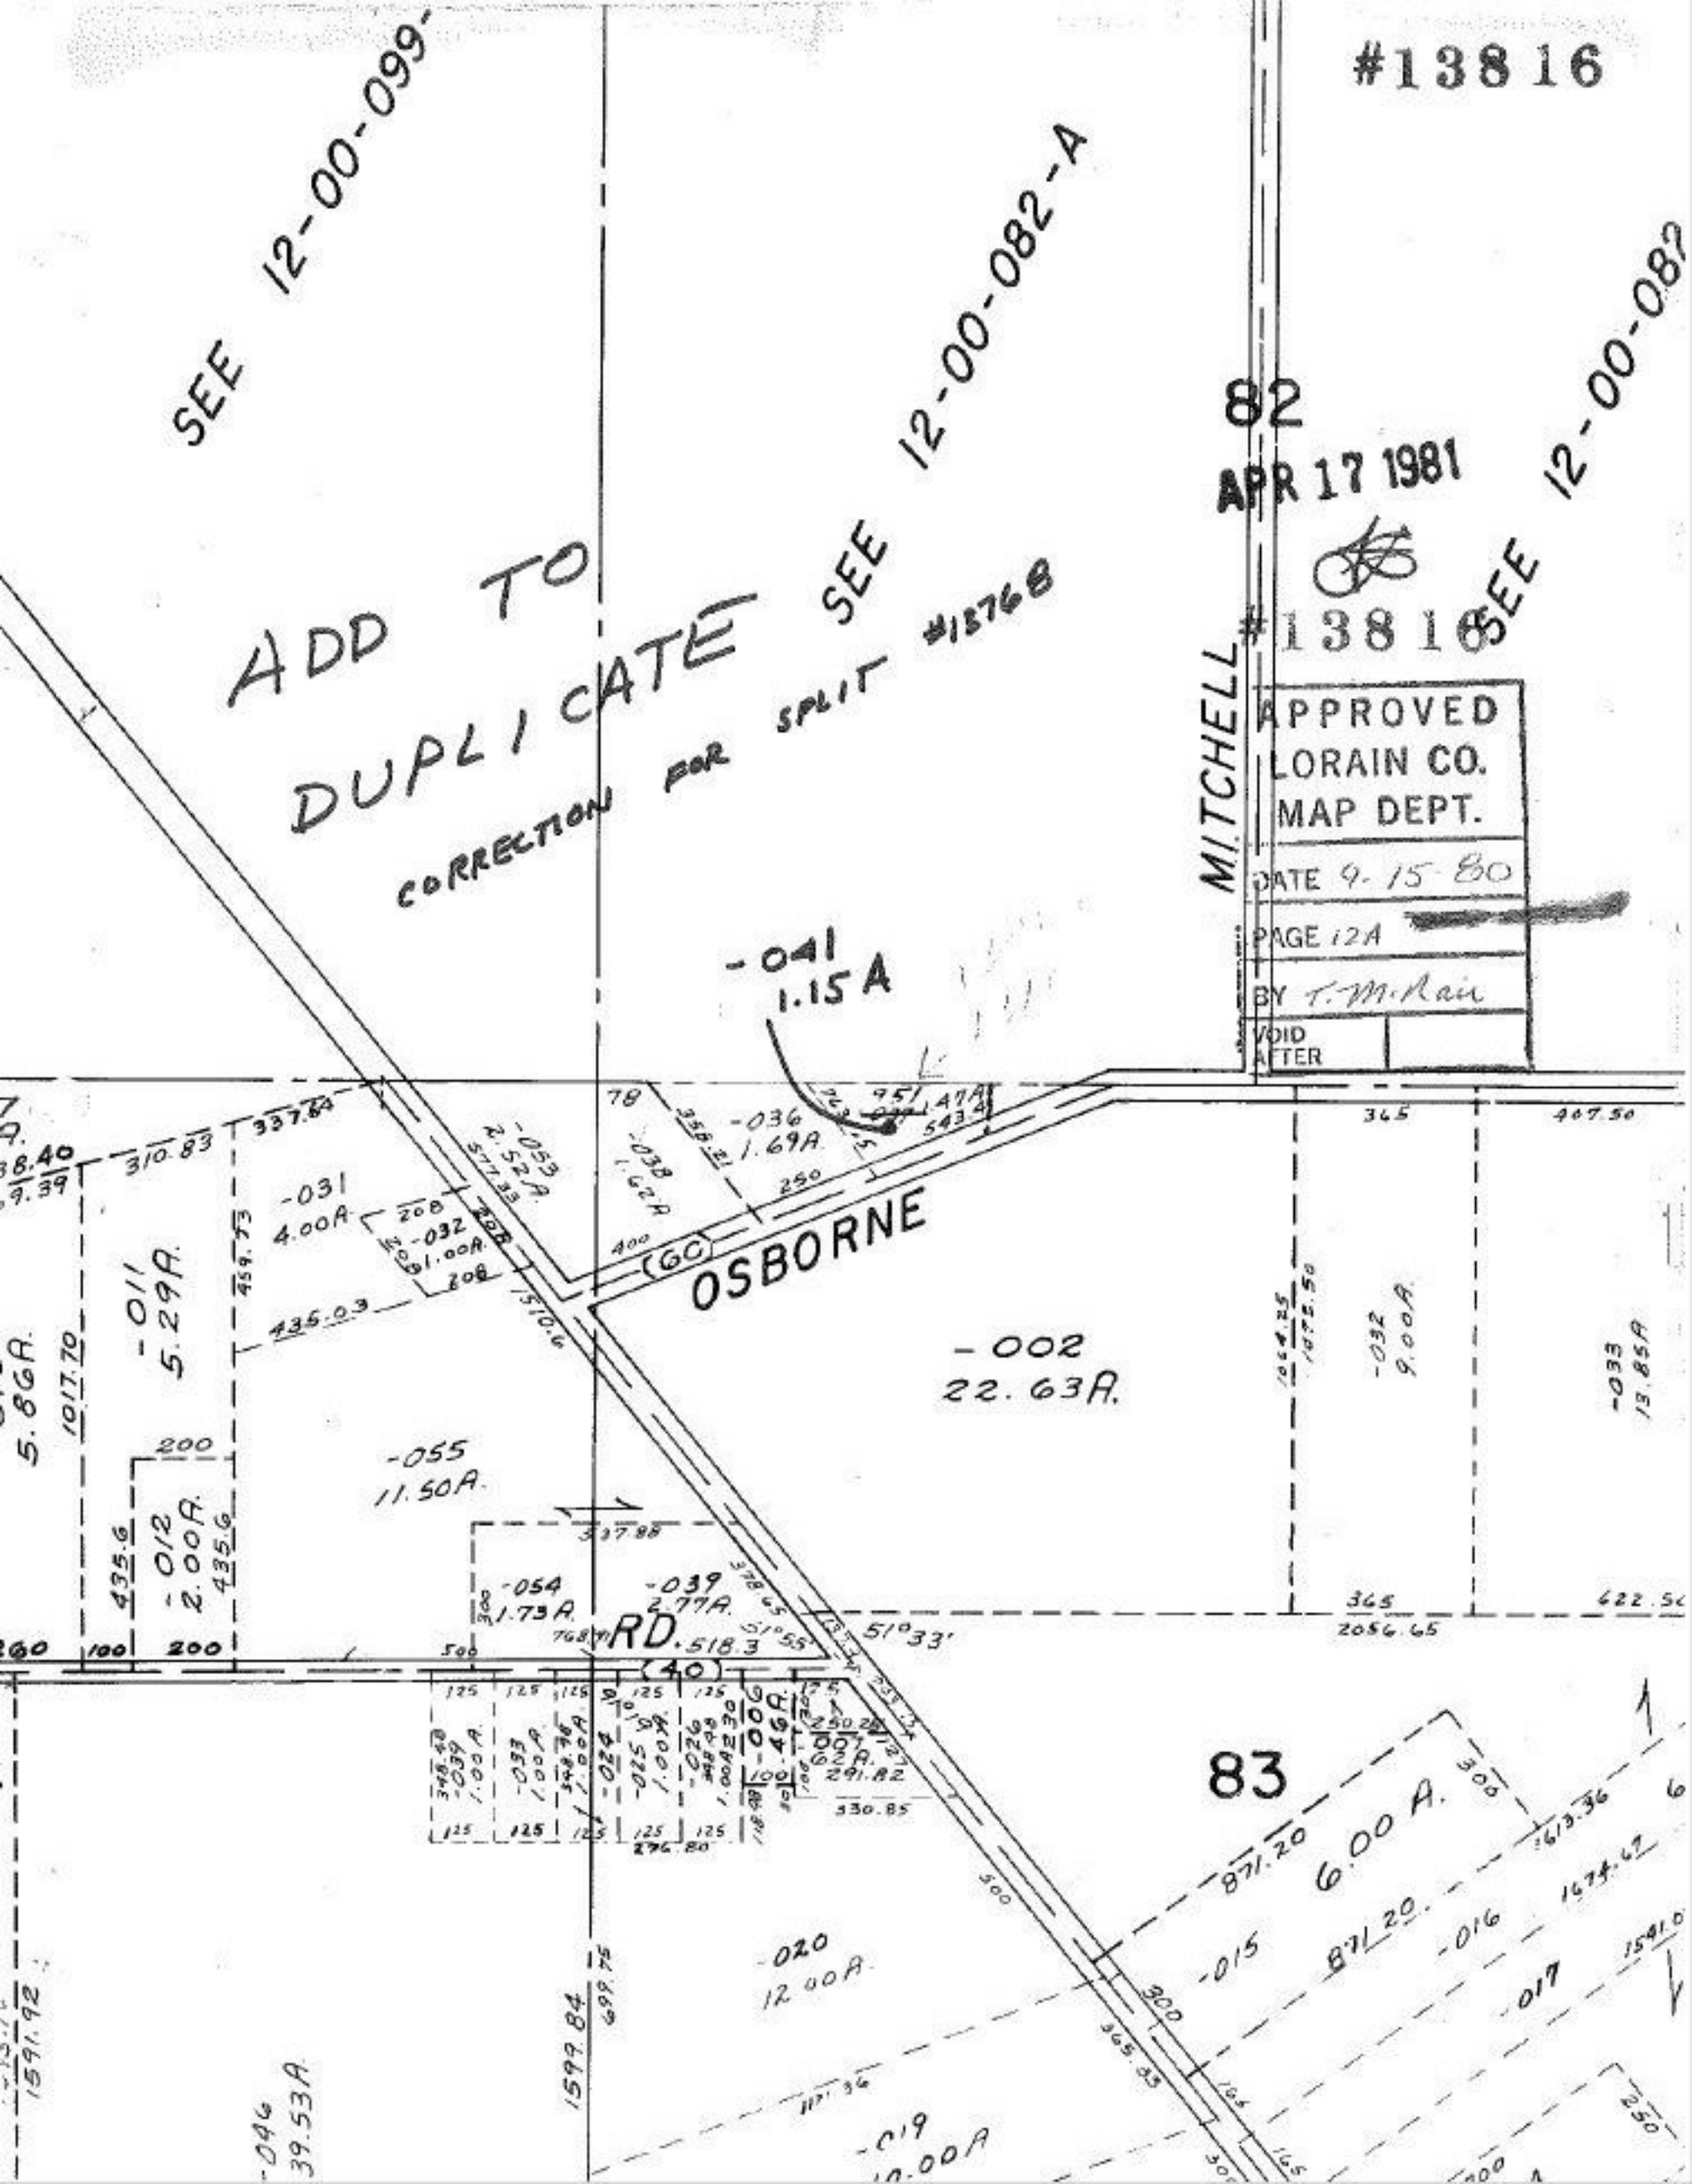

#13816
SEE 12-00-099-
SEE 12-00-082-A
SEE 12-00-082
82
APR 17 1981
ADD TO
DUPLICATE
CORRECTION FOR SPLIT #13768
#13816
MITCHELL
APPROVED
LORAIN CO.
MAP DEPT.
DATE 9-15-80
PAGE 12A
BY T. M. Rair
VOID
AFTER
-041
1.15 A
-036
1.69A
-053
2.52A
-038
1.62A
-031
4.00A
-032
1.00A
OSBORNE
-011
5.29A
-002
22.63A
-032
9.00A
-033
13.85A
-055
11.50A
-012
2.00A
-054
1.73A
-039
2.77A
RD.
83
6.00 A.
-015
-016
-017
-020
12.00A
-019
10.00A
-046
39.53A