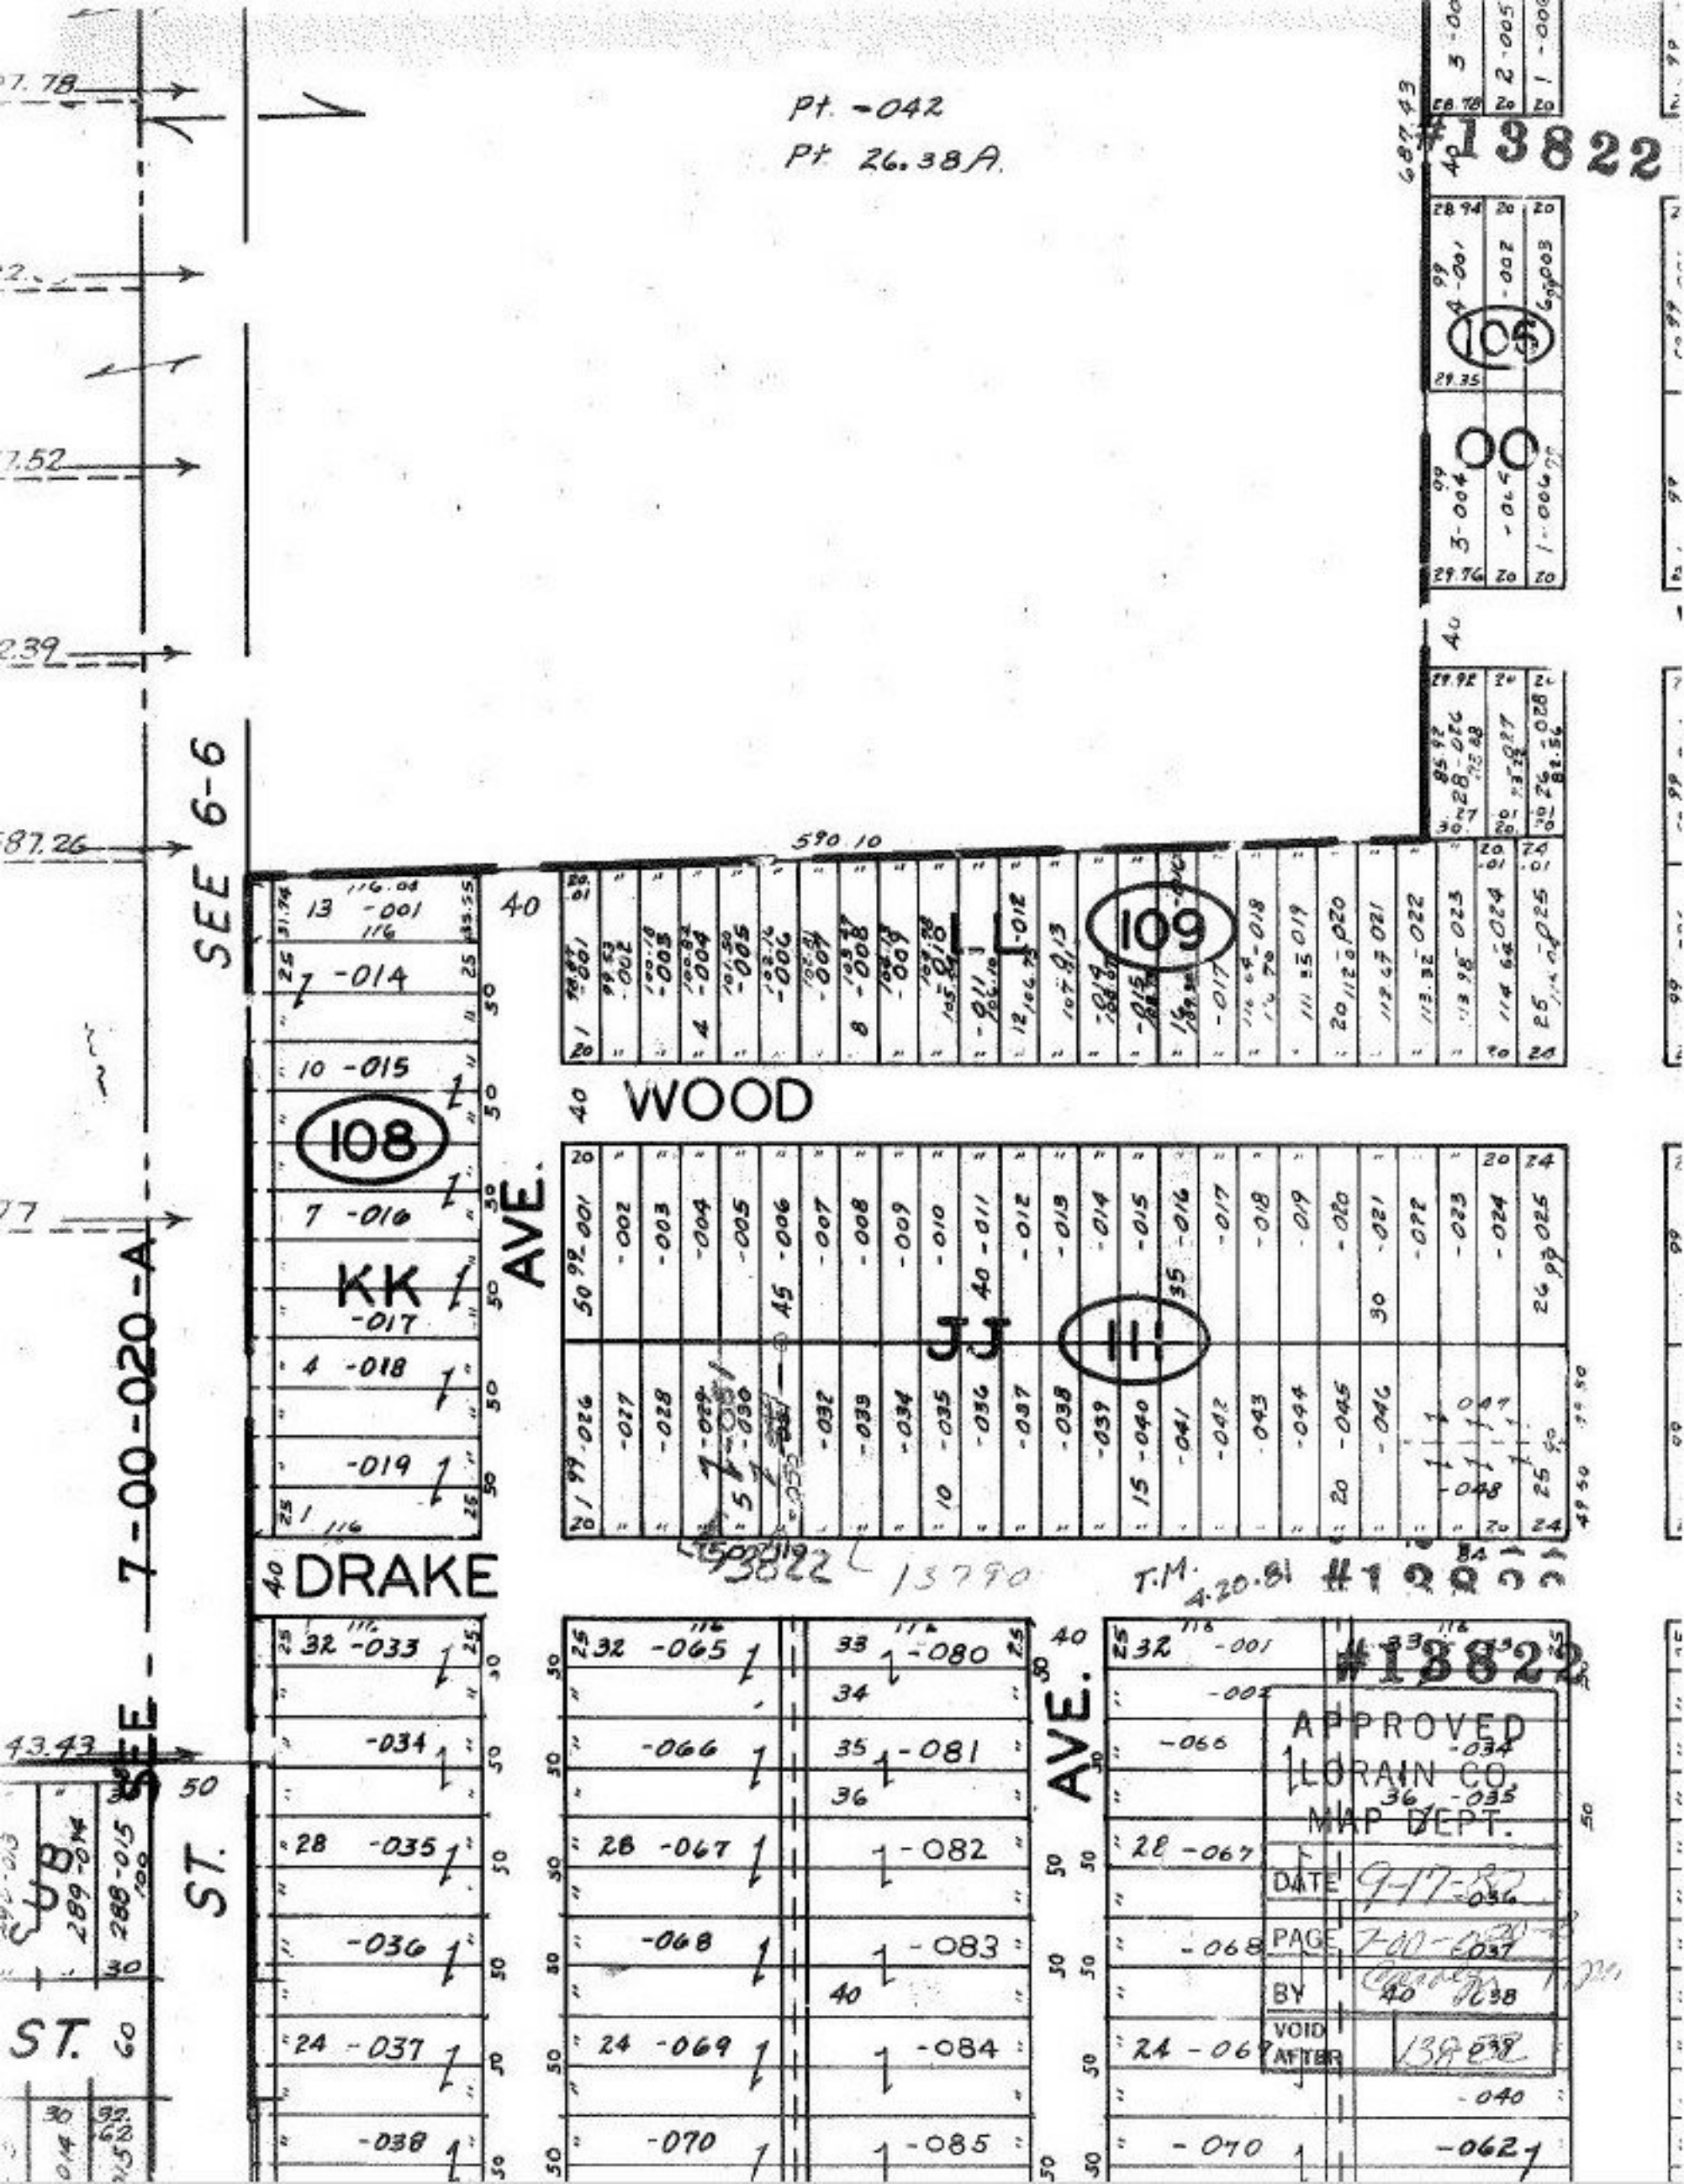

Pt. -042
Pt. 26.38A.
#13822
SEE 6-6
SEE 7-00-020-A
WOOD
DRAKE
AVE.
ST.
KK
JJ
108
109
111
105
00
13822
13790
T.M. 4-20-81
#13822
APPROVED
LORAIN CO.
MAP DEPT.
DATE 9-17-82
PAGE 7-00-020-A
BY
VOID AFTER 13822