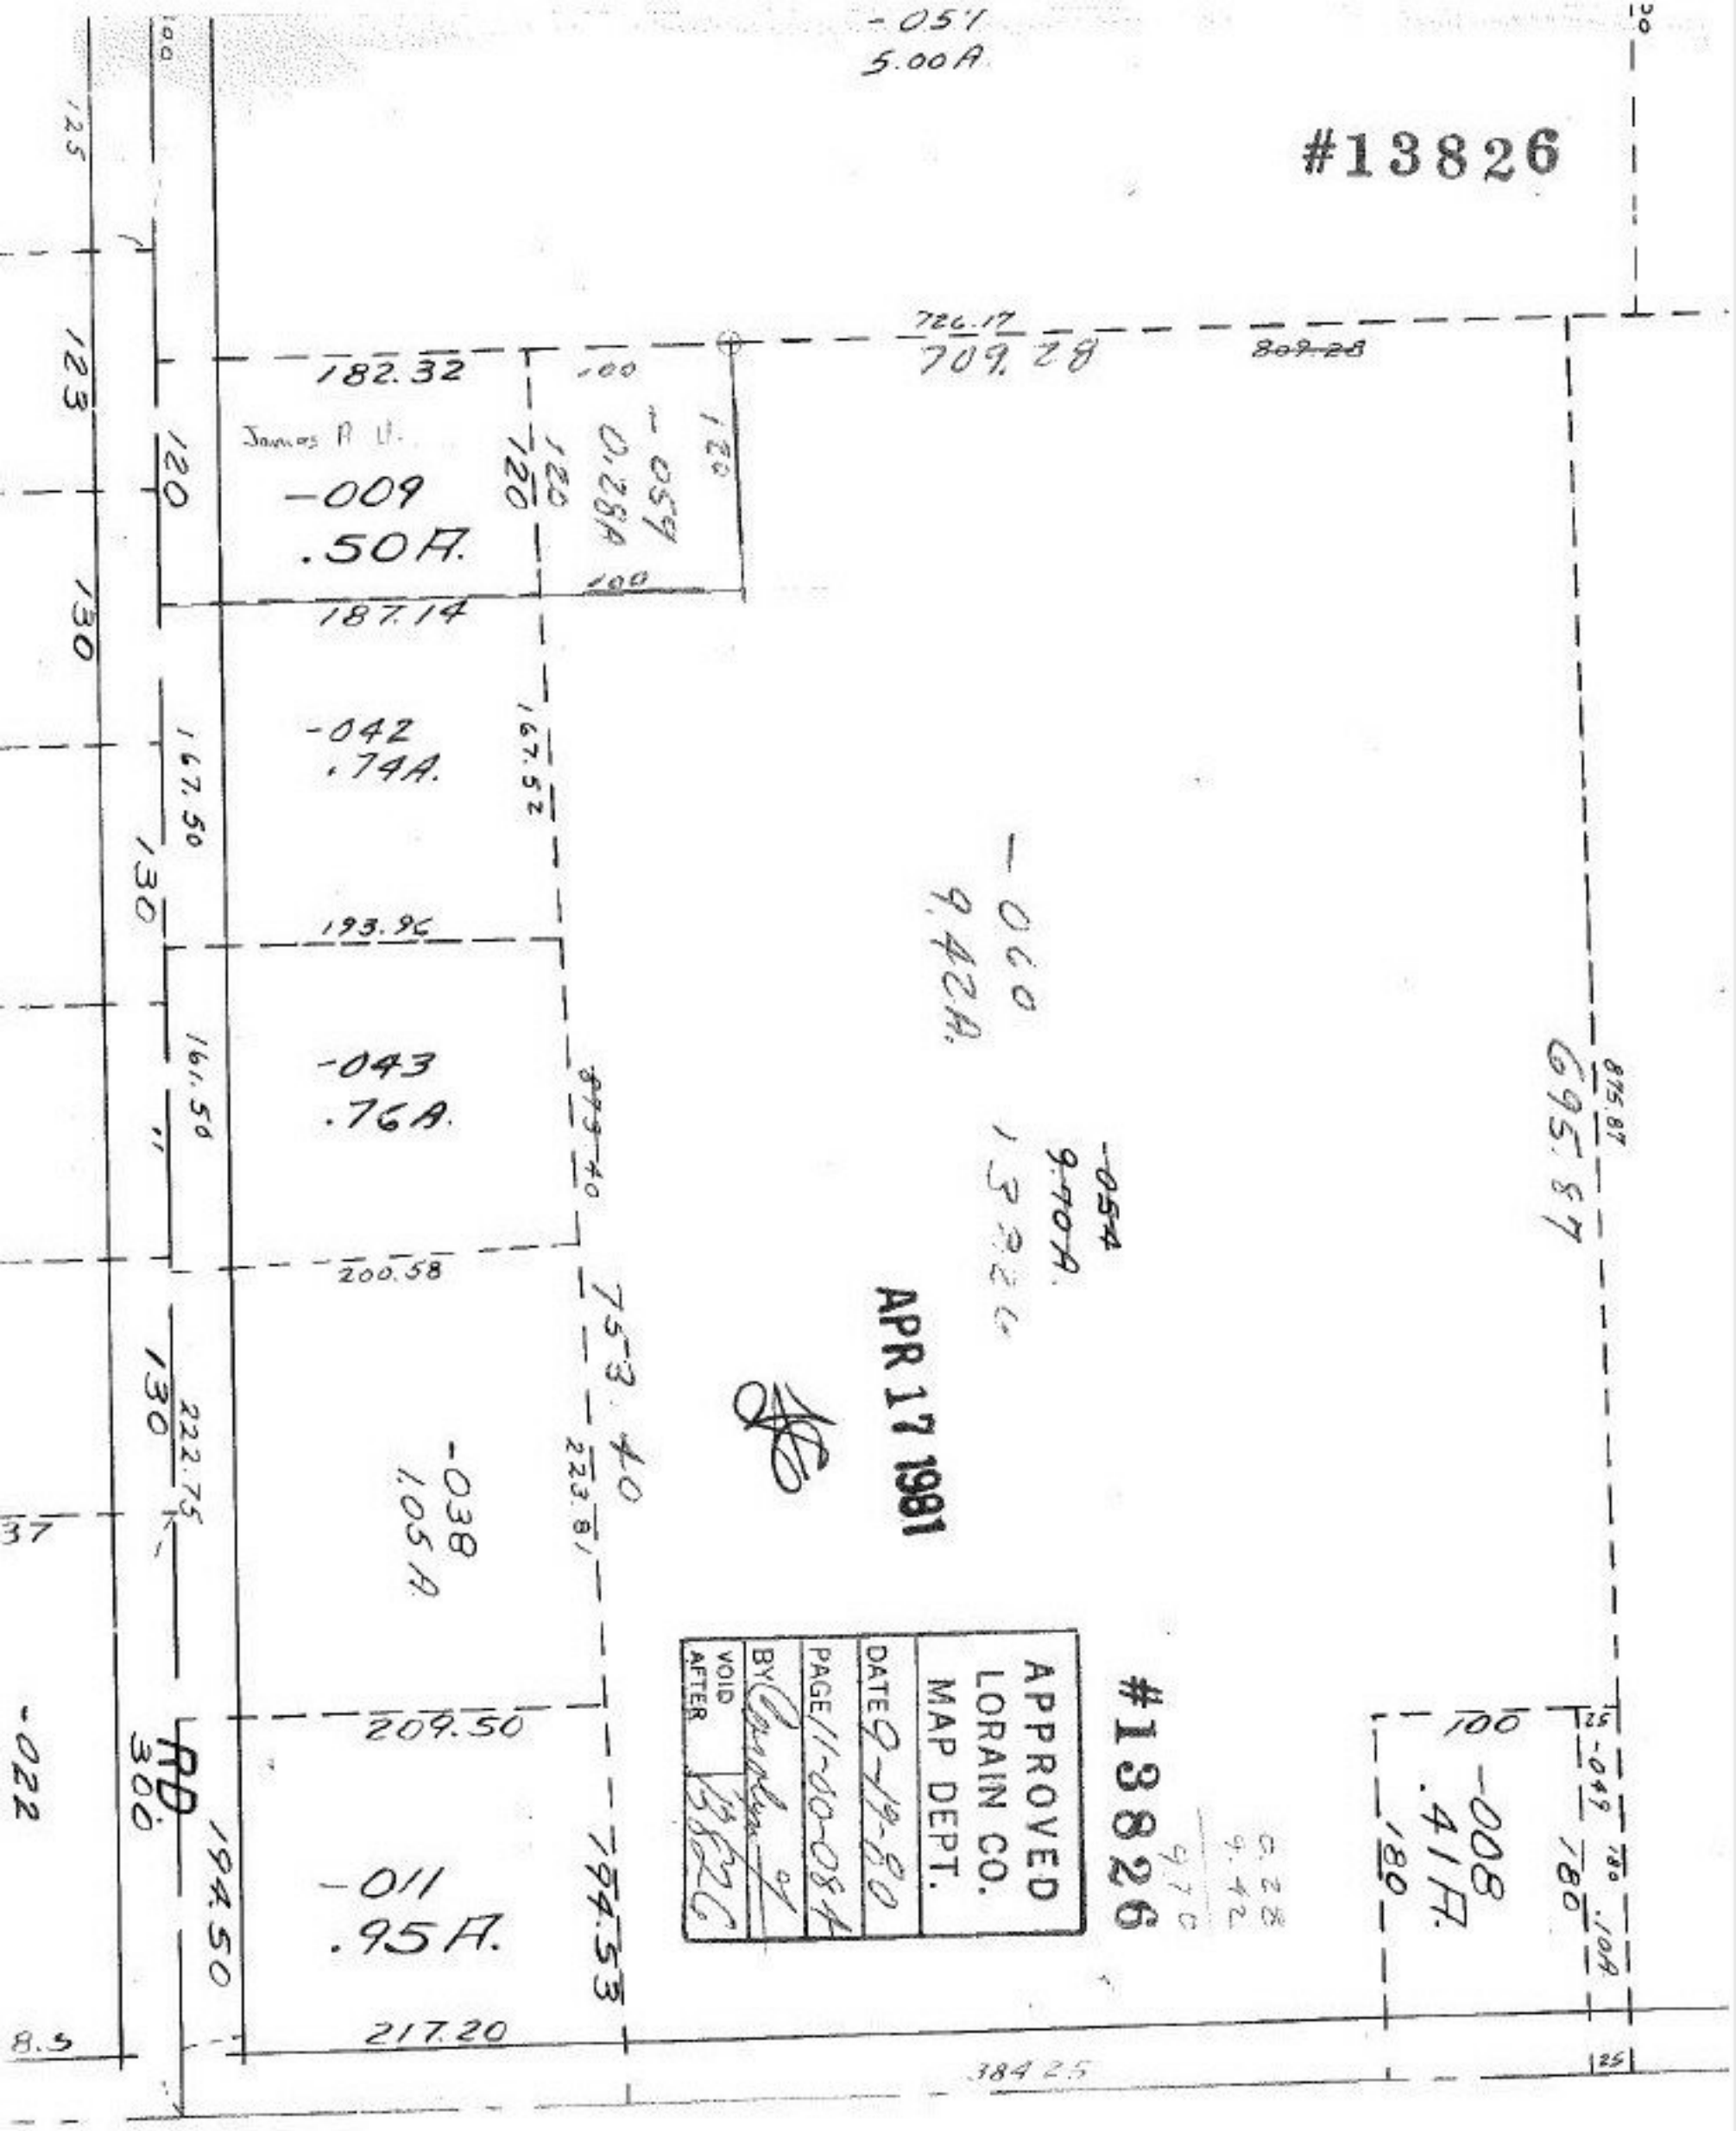

#13826
-057
5.00A
726.17
709.28
809.28
182.32
James R. U.
-009
.50A.
-059
0.28A
187.14
-042
.74A.
167.50
167.52
193.96
-043
.76A.
161.50
200.58
-060
9.42A.
-054
9.70A.
13826
695.87
875.87
753.40
223.81
-038
1.05A.
222.75
209.50
-011
.95A.
194.50
194.53
217.20
384.25
-008
.41A.
-049
.10A
RD.
300
-022
APR 17 1981
APPROVED
LORAIN CO.
MAP DEPT.
DATE 9-19-80
PAGE 11-00-084
BY
VOID AFTER
#13826