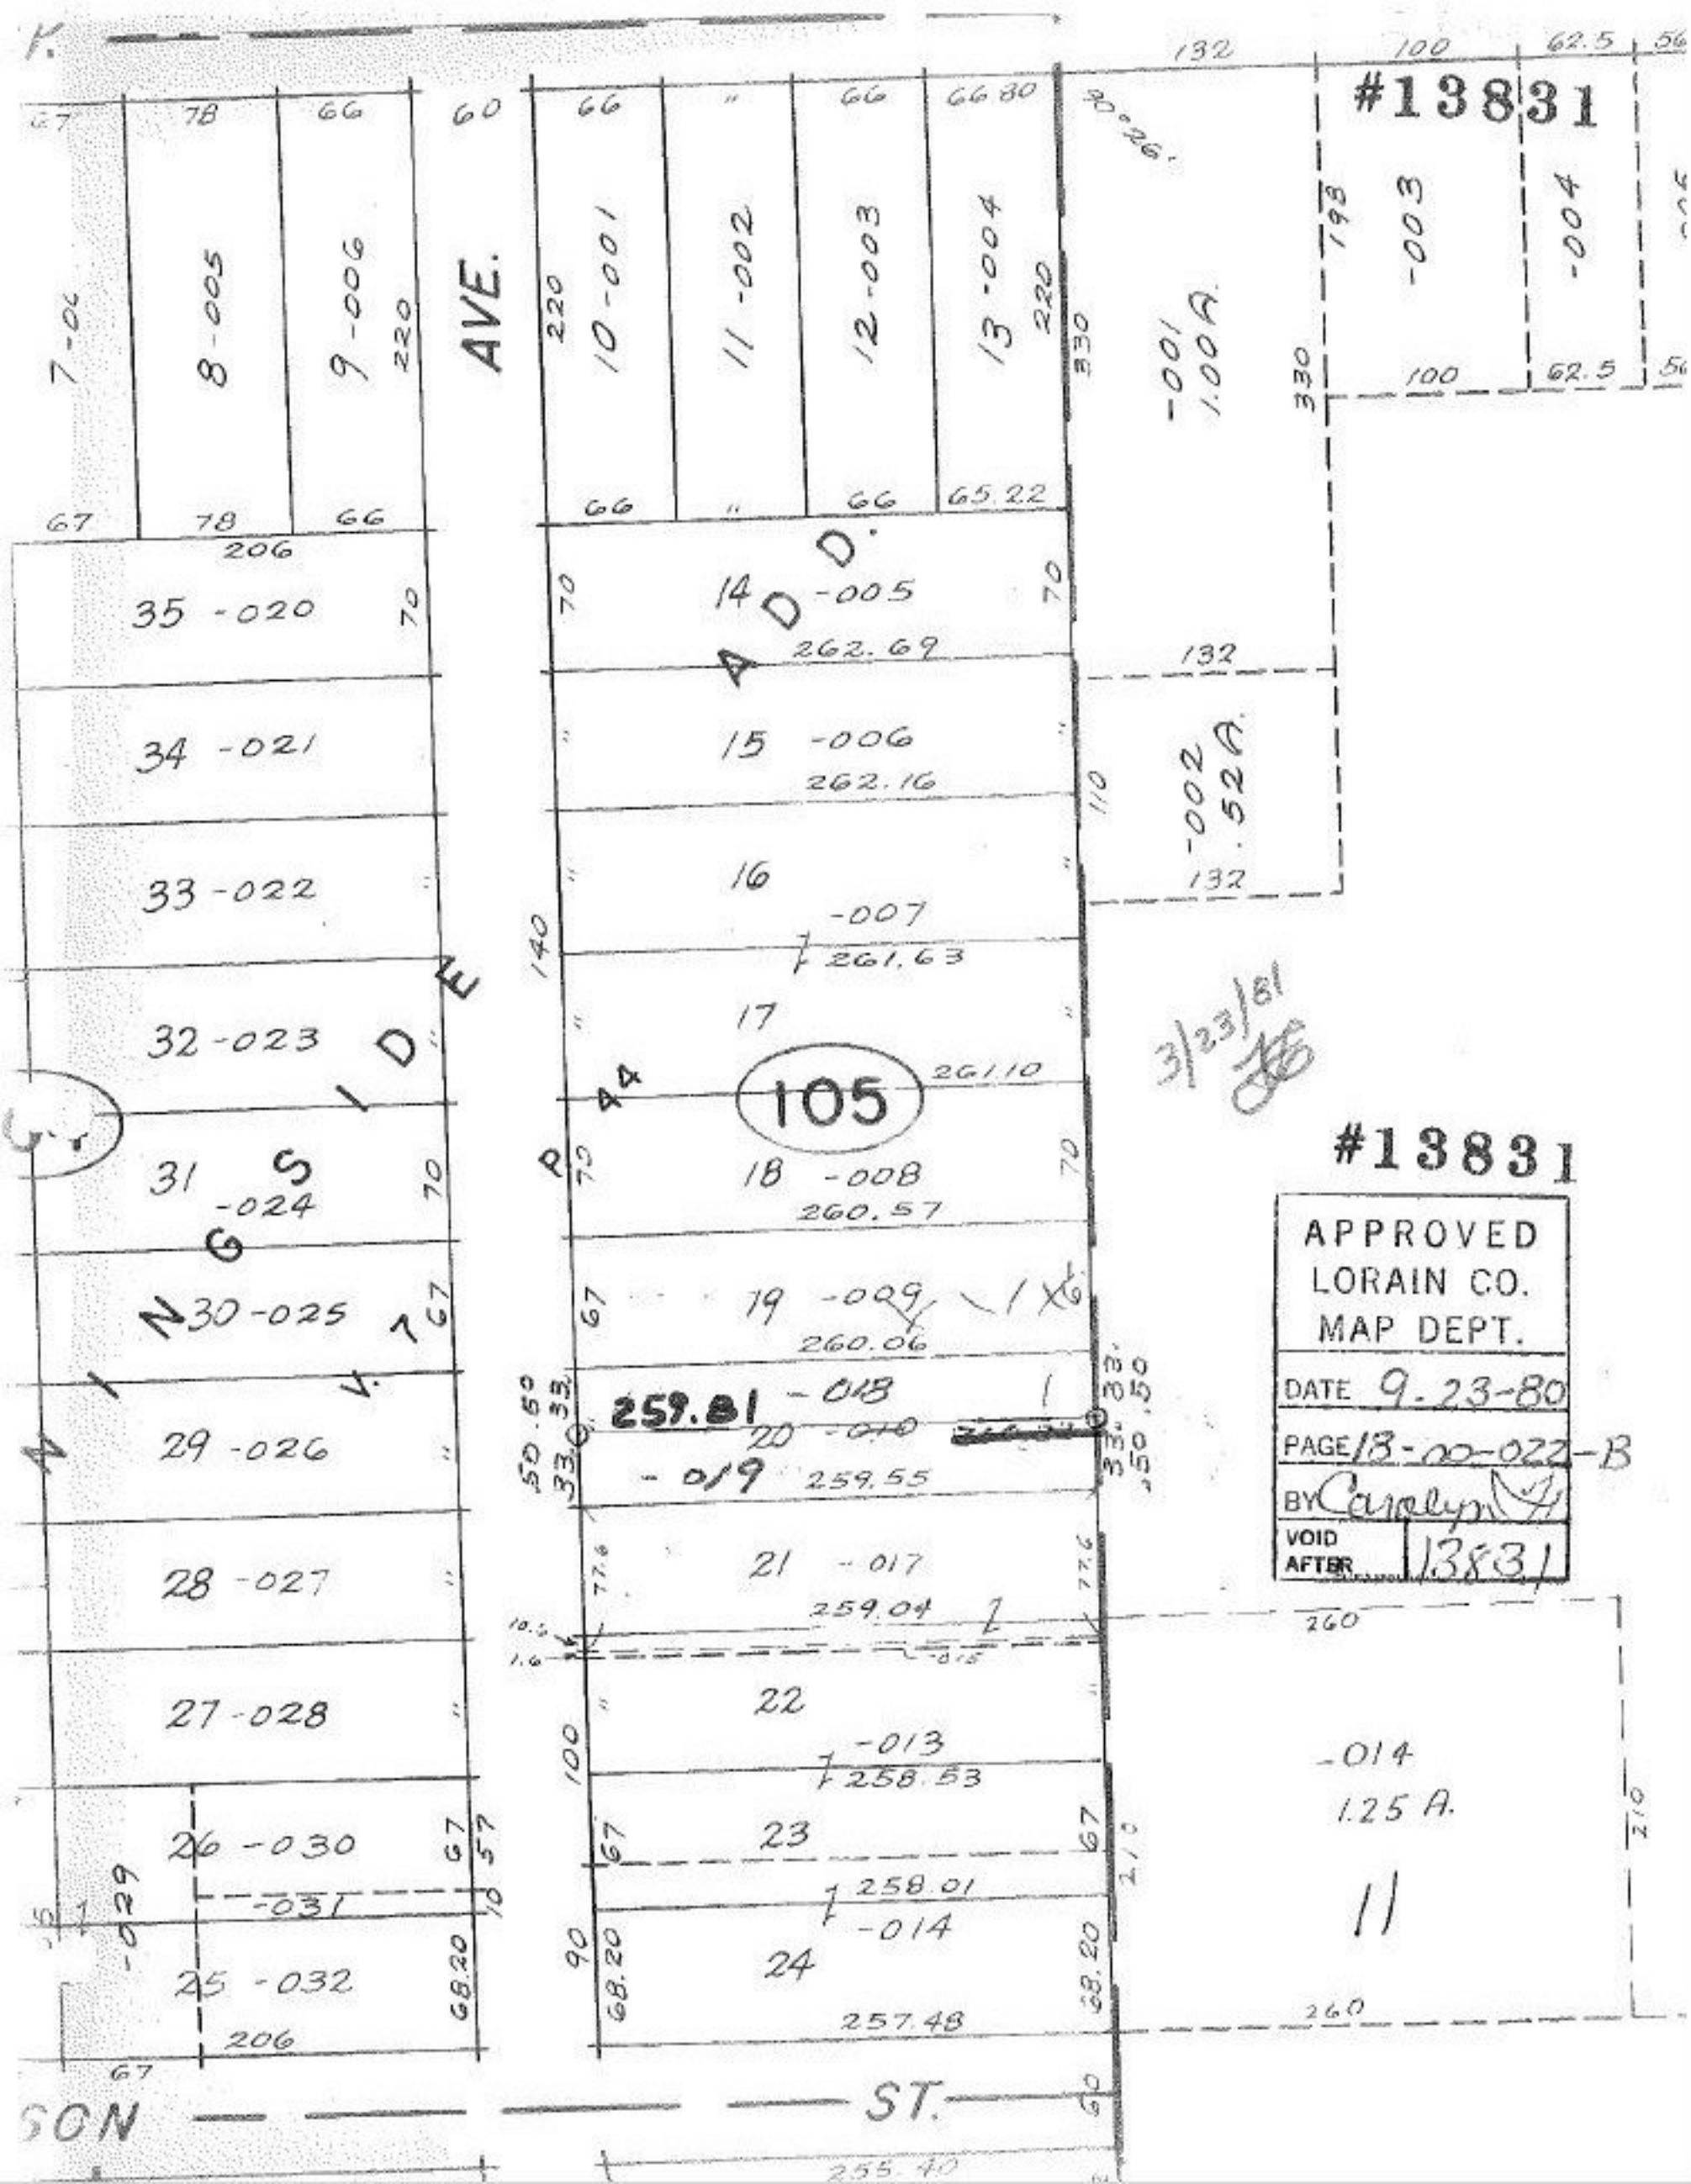

#13831
AVE.
ADD.
105
#13831
APPROVED
LORAIN CO.
MAP DEPT.
DATE 9-23-80
PAGE 18-00-022-B
BY Carolyn
VOID AFTER 13831
3/23/81
ST.