SEE 5-00-017-A

#13837

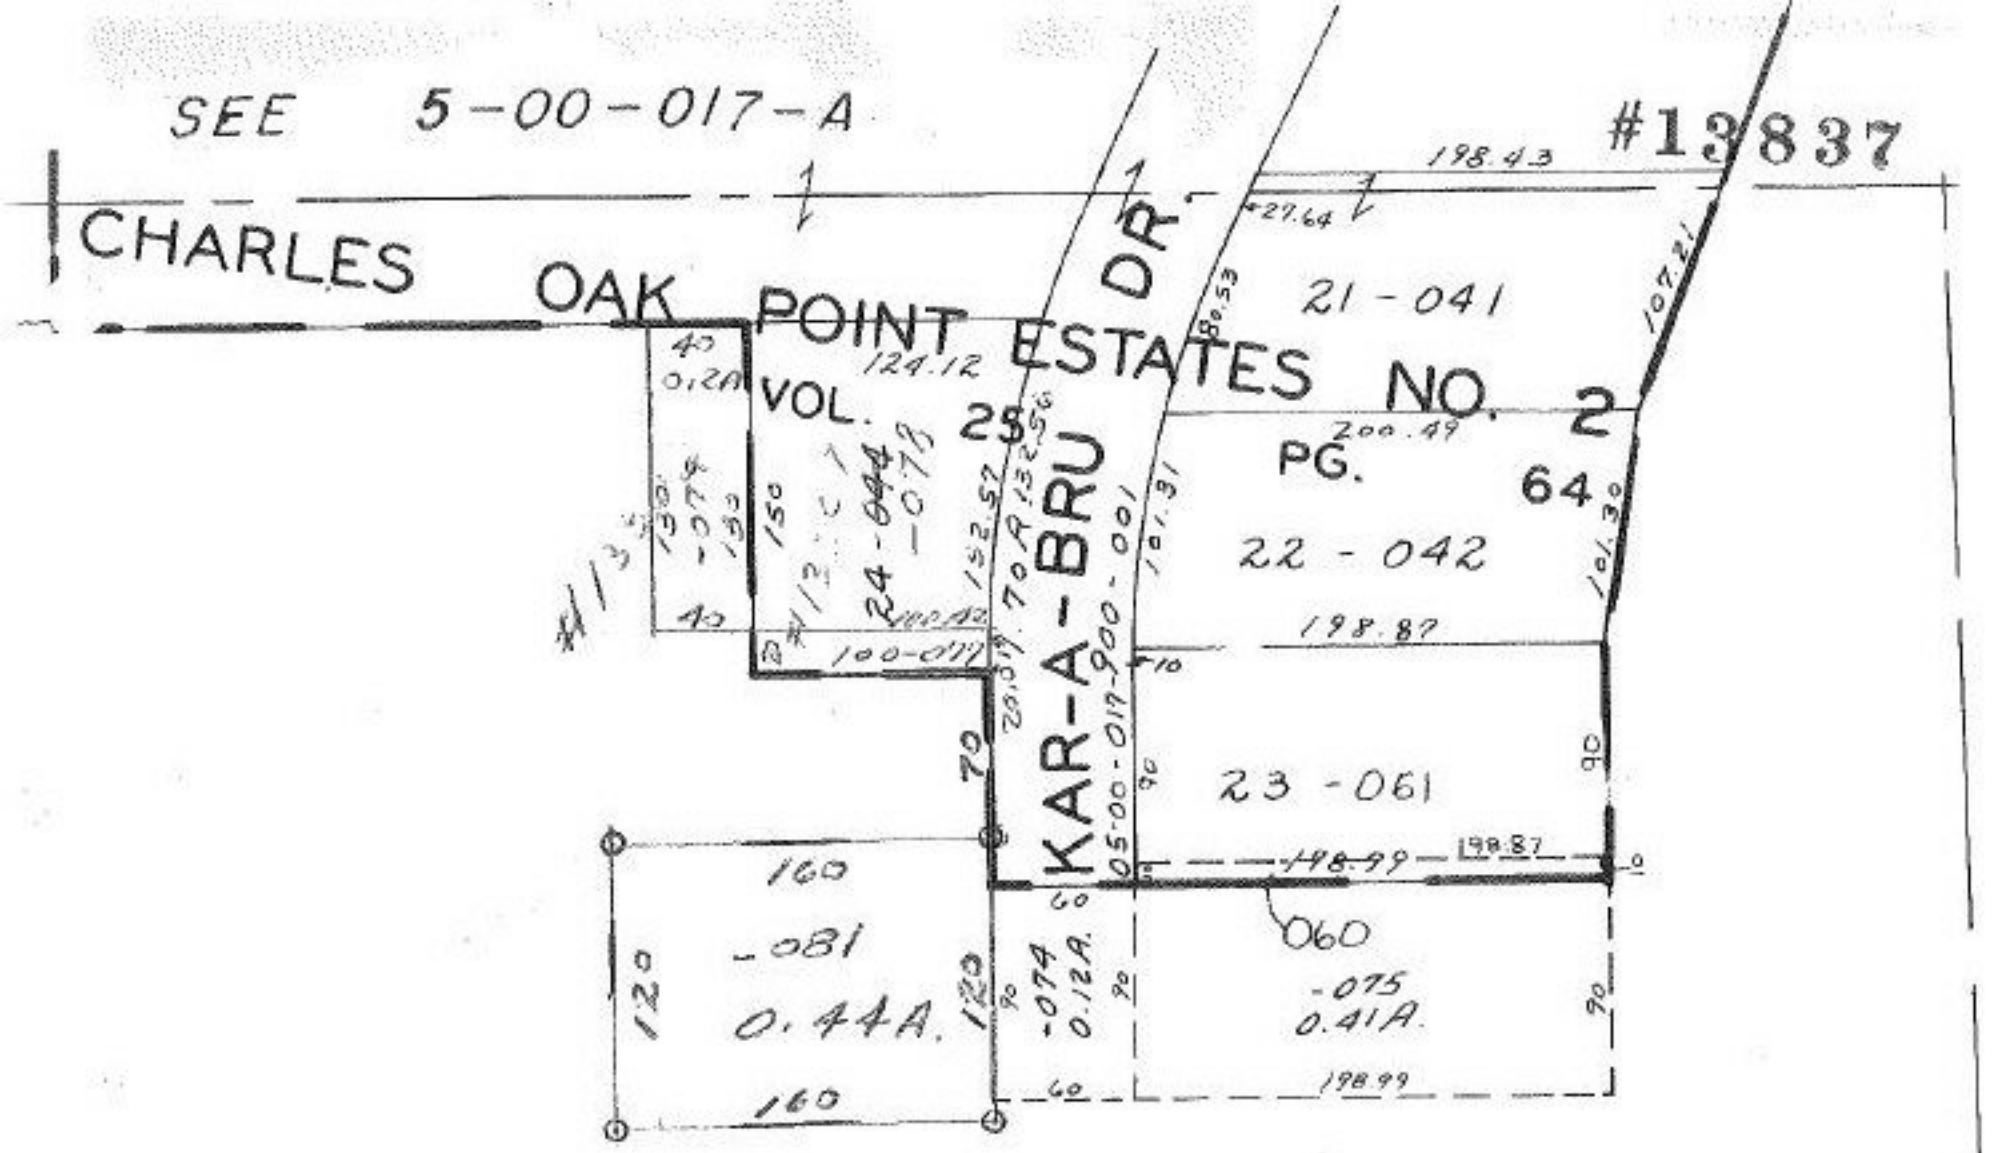

#13837

T.M.
4-10.81

APPROVED
LORAIN CO.
MAP DEPT.

DATE 9-26-80

PAGE 5-00-016-A&B

BY Carolyn F.

VOID AFTER 13837

120

-080
Pt. ~~-076~~ Pt. -082
~~46.53~~
Pt. ~~46.65A~~ Pt. ~~45.09~~ A
46.09 A

45.09
.44
45.53