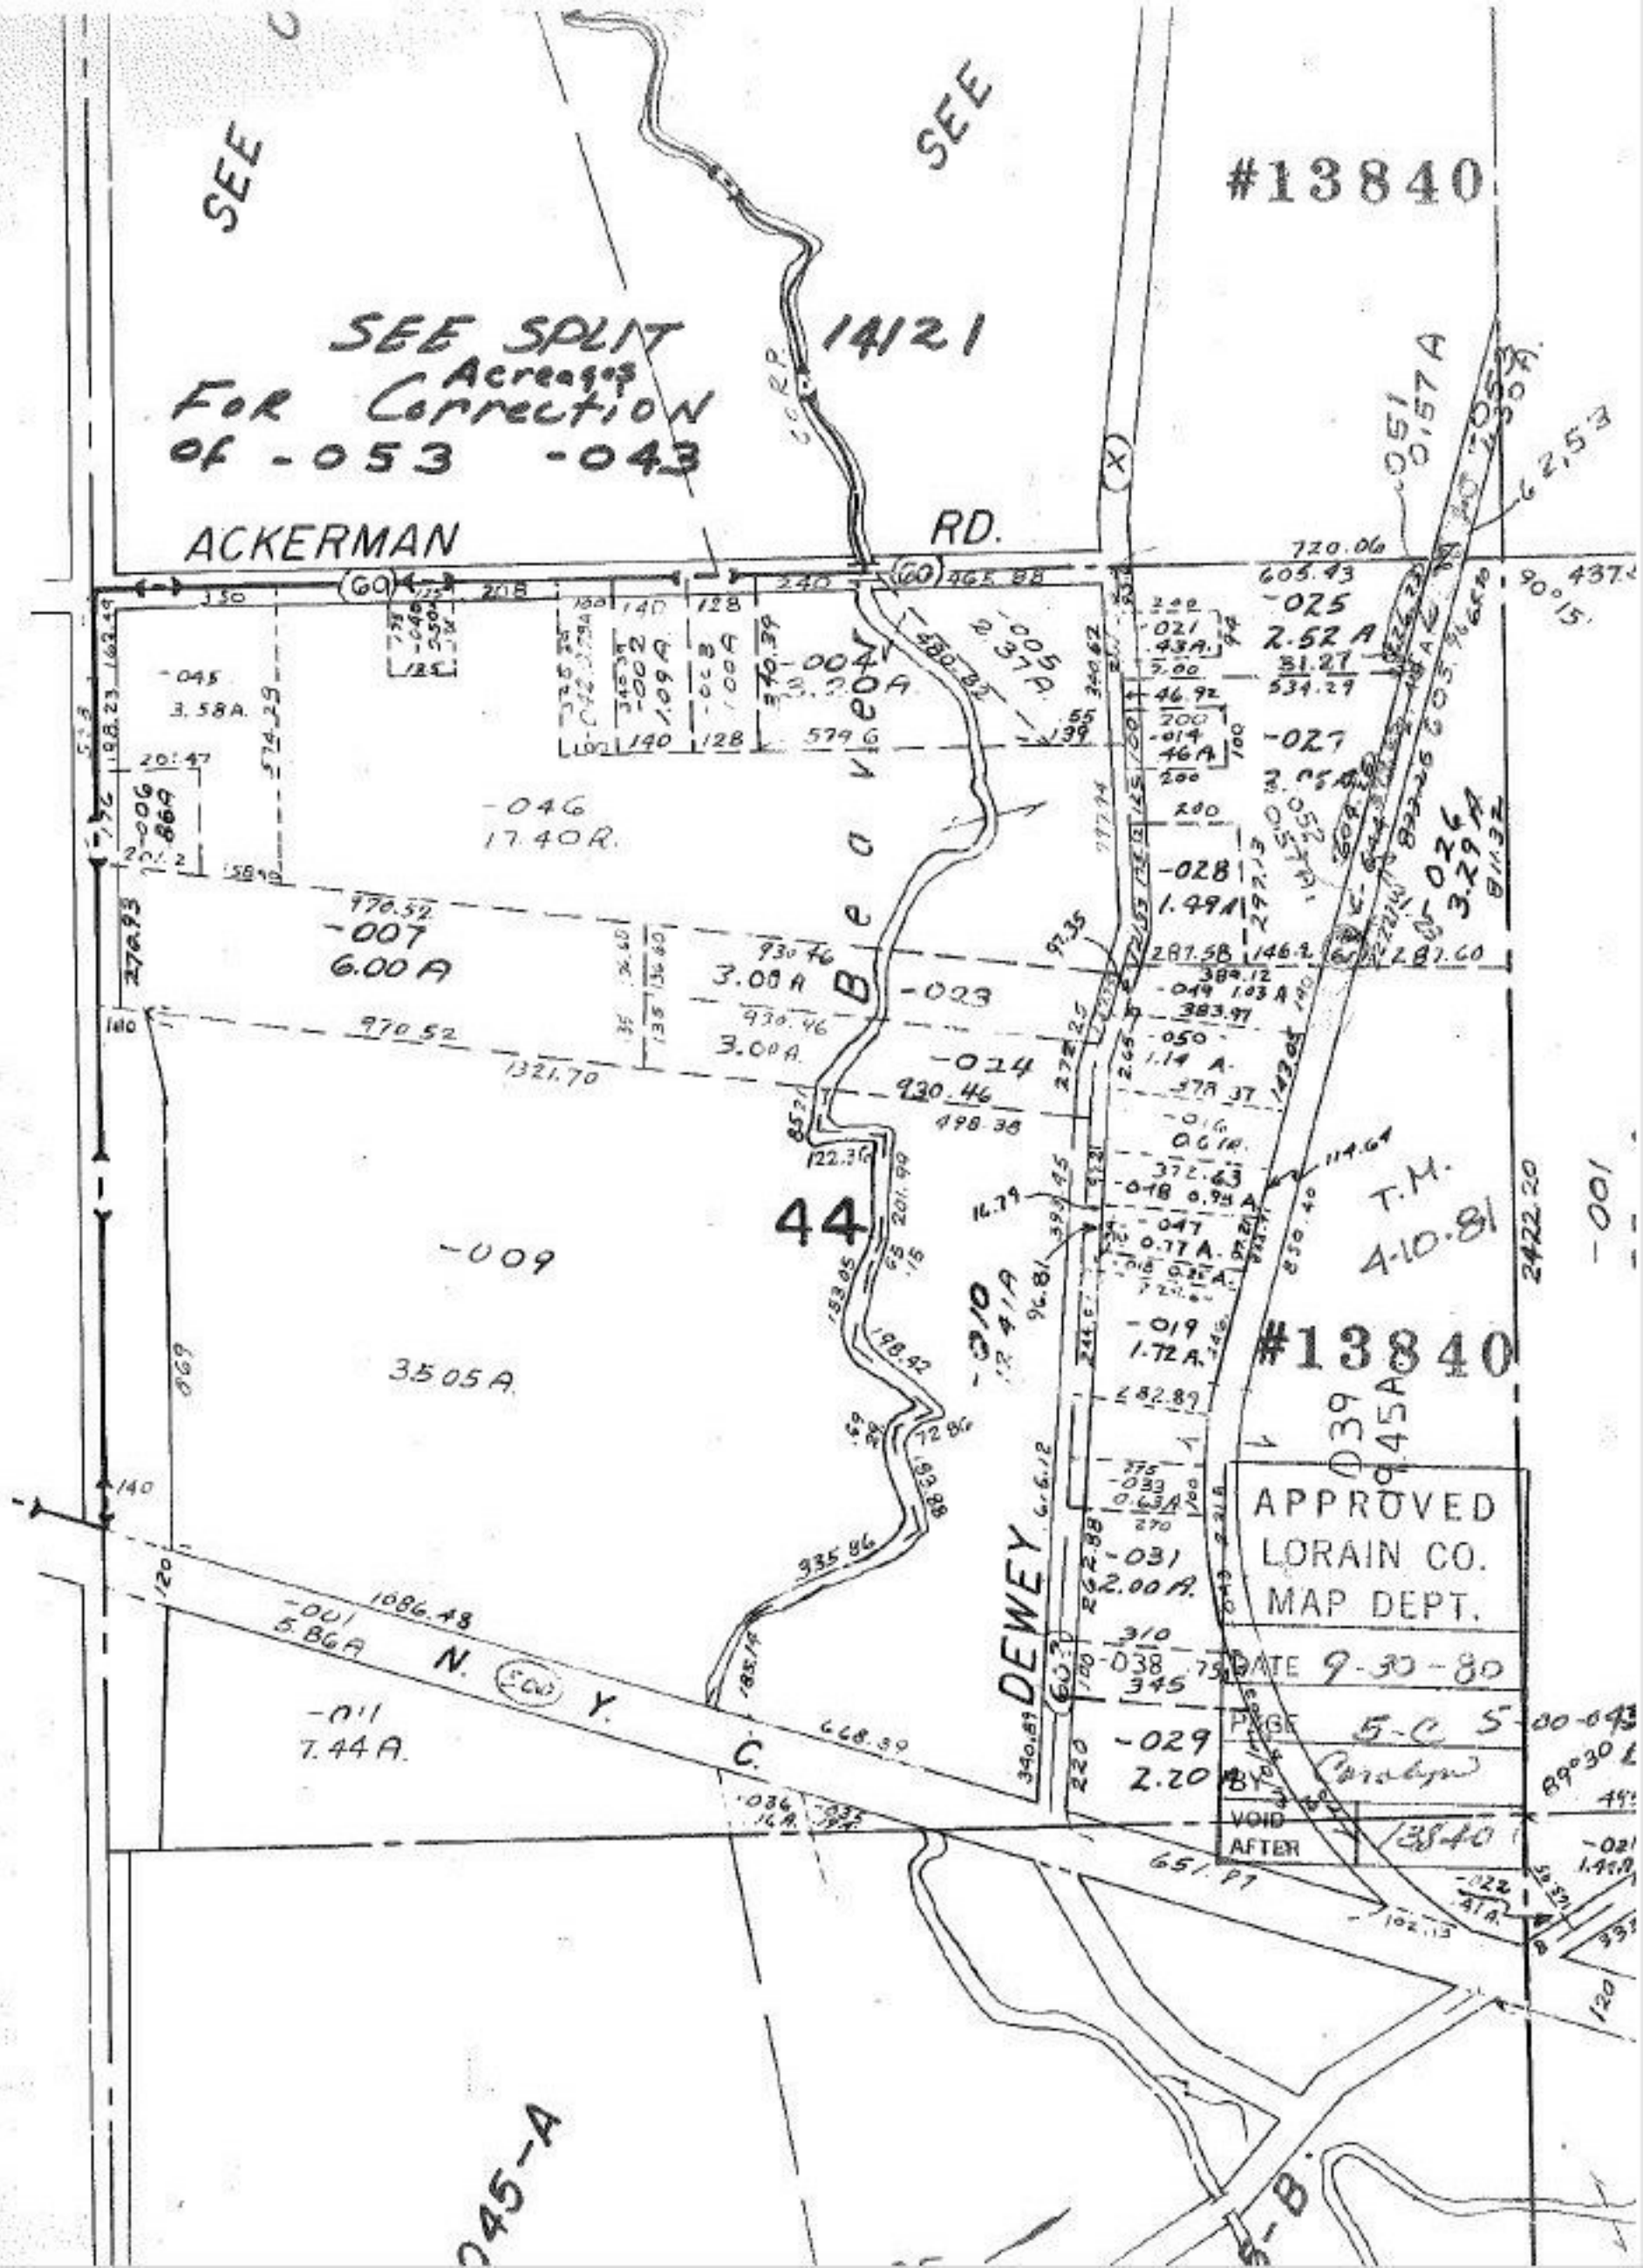

SEE
SEE
#13840
SEE SPLIT 14121
Acreages
For Correction
of -053 -043
ACKERMAN RD.
Beaver
DEWEY
N. Y. C.
44
-046
17.40 R.
-007
6.00 A
-009
35.05 A
-011
7.44 A.
-025
2.52 A
-027
-028
1.49 A
-026
3.29 A
-023
-024
-019
1.72 A.
-031
2.00 A.
-029
2.20 A
-001
5.86 A
T.M.
4-10-81
#13840
APPROVED
LORAIN CO.
MAP DEPT.
DATE 9-30-80
PAGE 5-C
BY
VOID
AFTER
13840
045-A