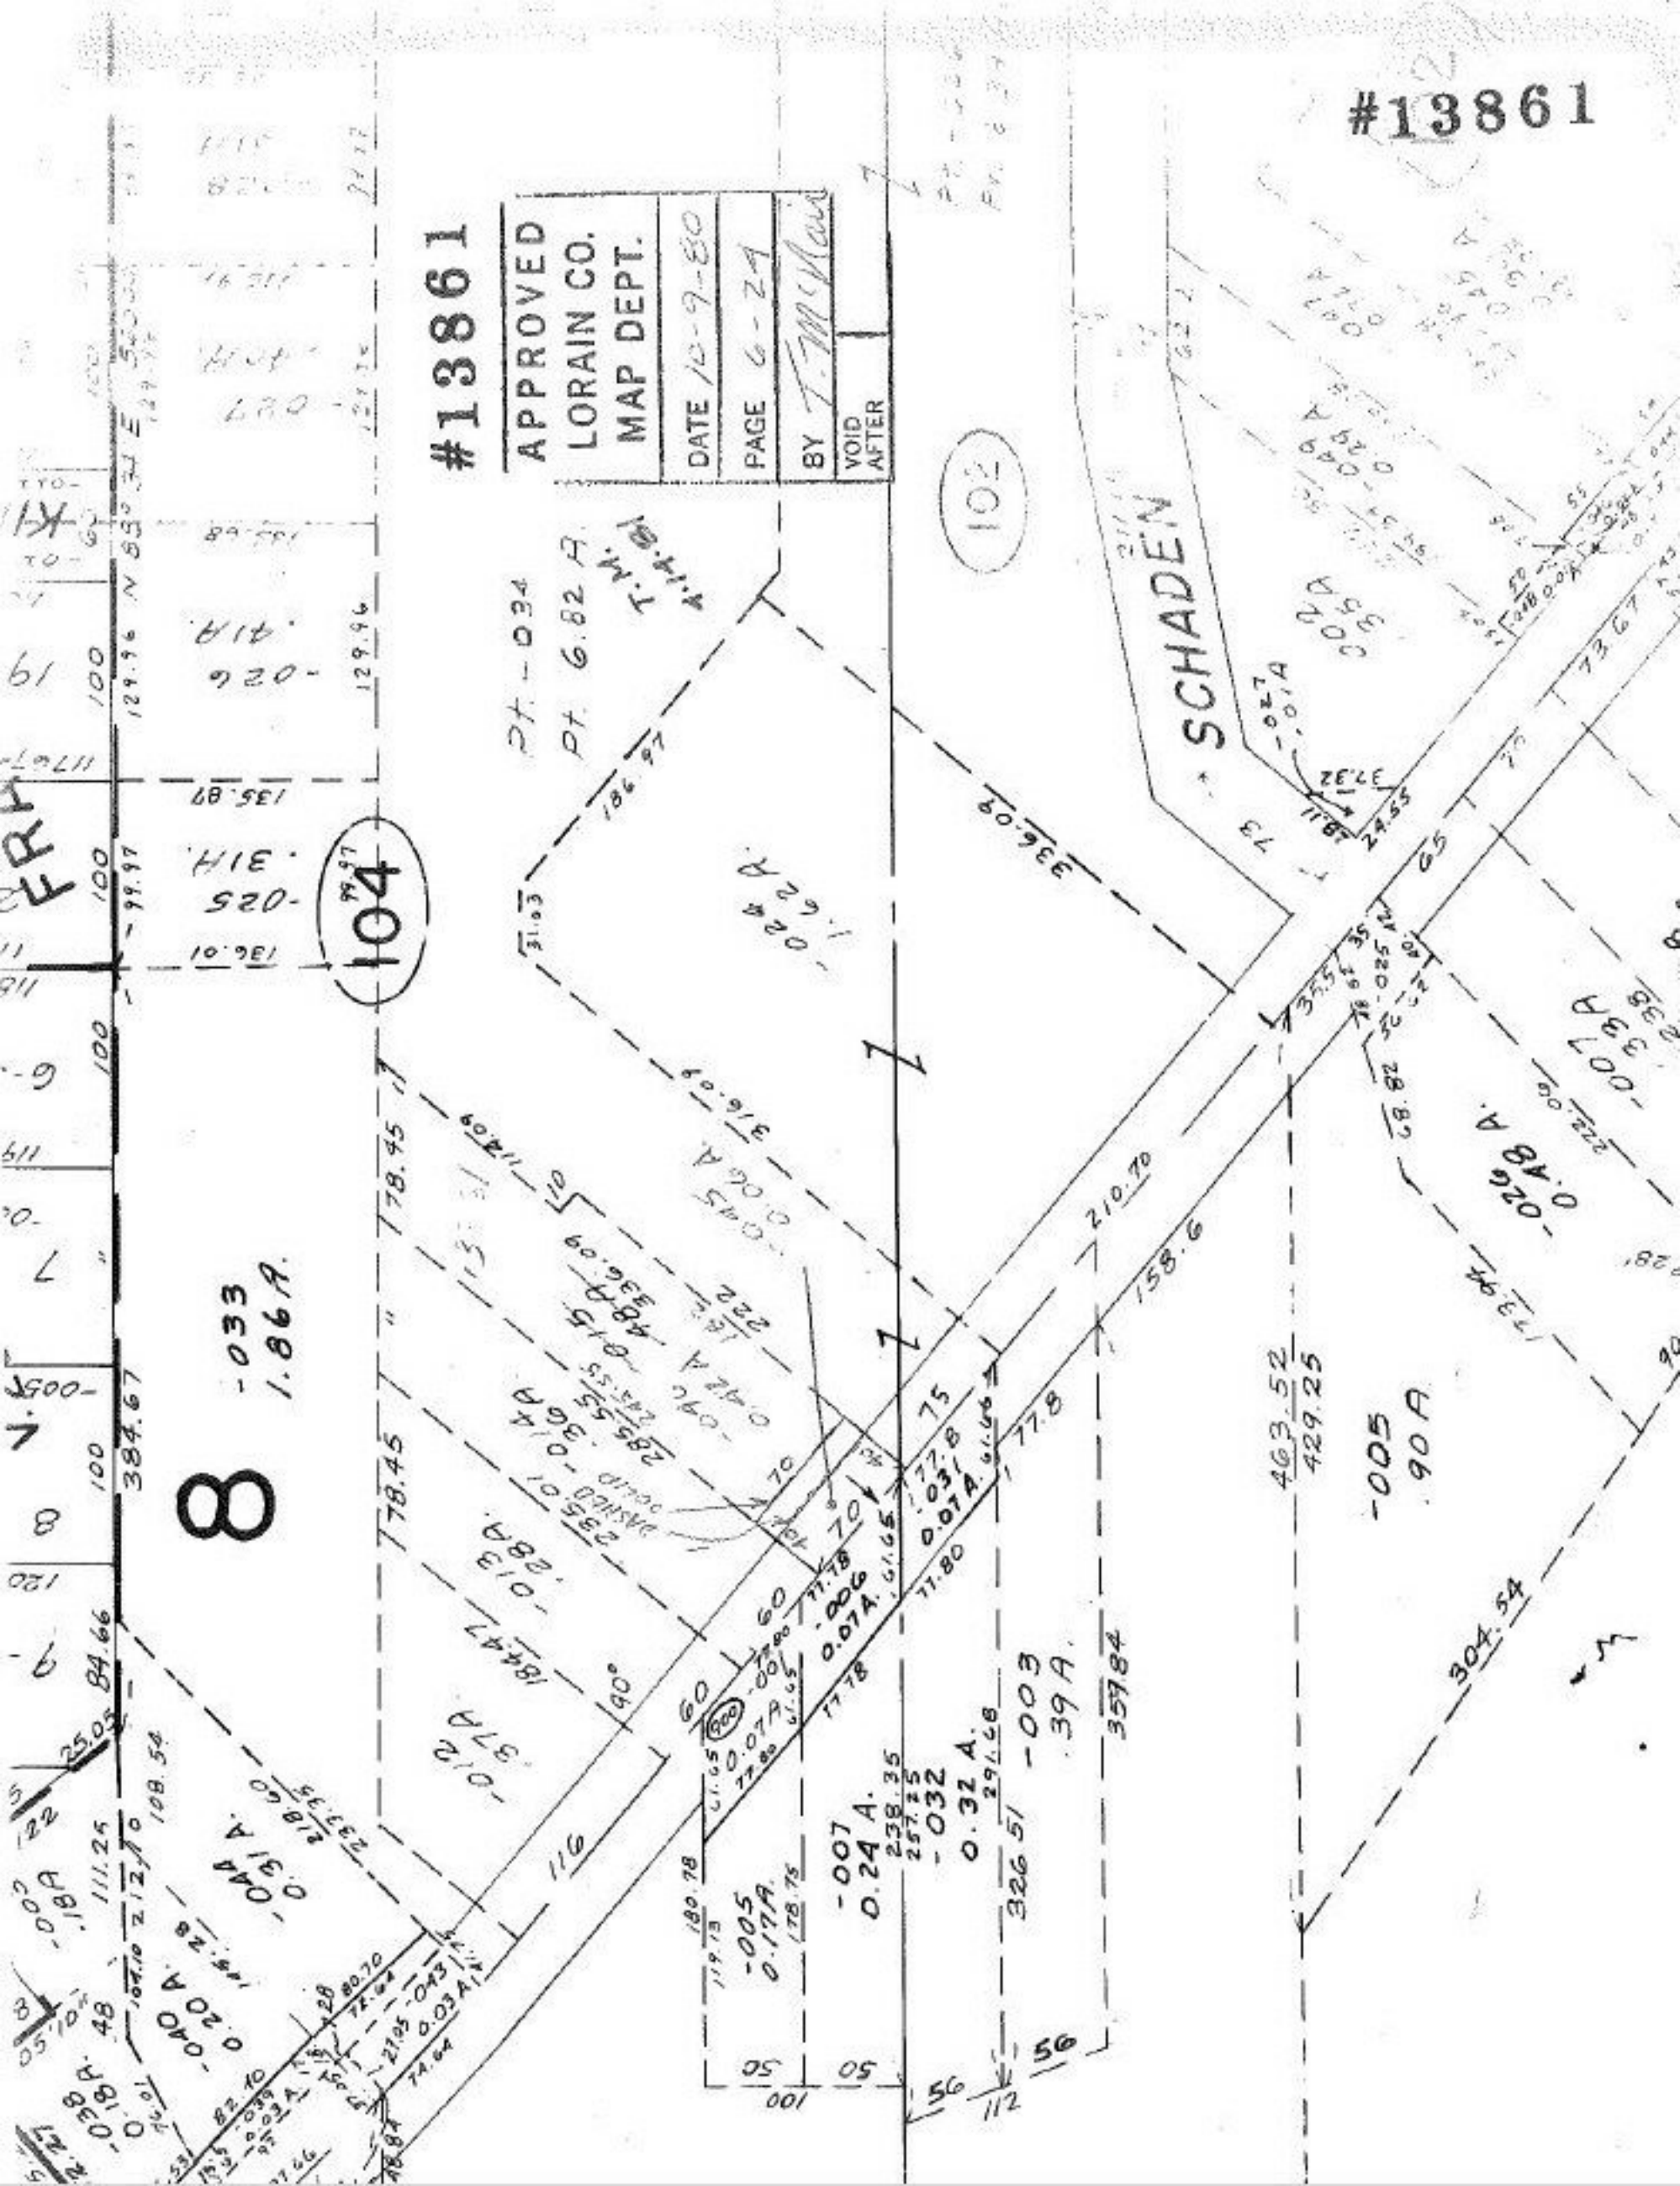
#13861
#13861
APPROVED
LORAIN CO.
MAP DEPT.
DATE 10-9-80
PAGE 6-24
BY
VOID AFTER
SCHADEN
102
104
8
-033
1.86 A.
-005
.90 A
-003
.39 A.
-007
0.24 A.
-032
0.32 A.
-005
0.17 A.
-044
0.31 A.
-040
0.20 A.
-012
.37 A
-013
.28 A.
-026
.41 A.
-025
.31 A.
-026
0.48 A.
-007
.33 A
Pt. -034
Pt. 6.82 A.
336.09
186.97
463.52
429.25
304.54
359.84
326.51
210.70
158.6
384.67
84.66
111.25
108.54
116
112
100
56
50