#13866

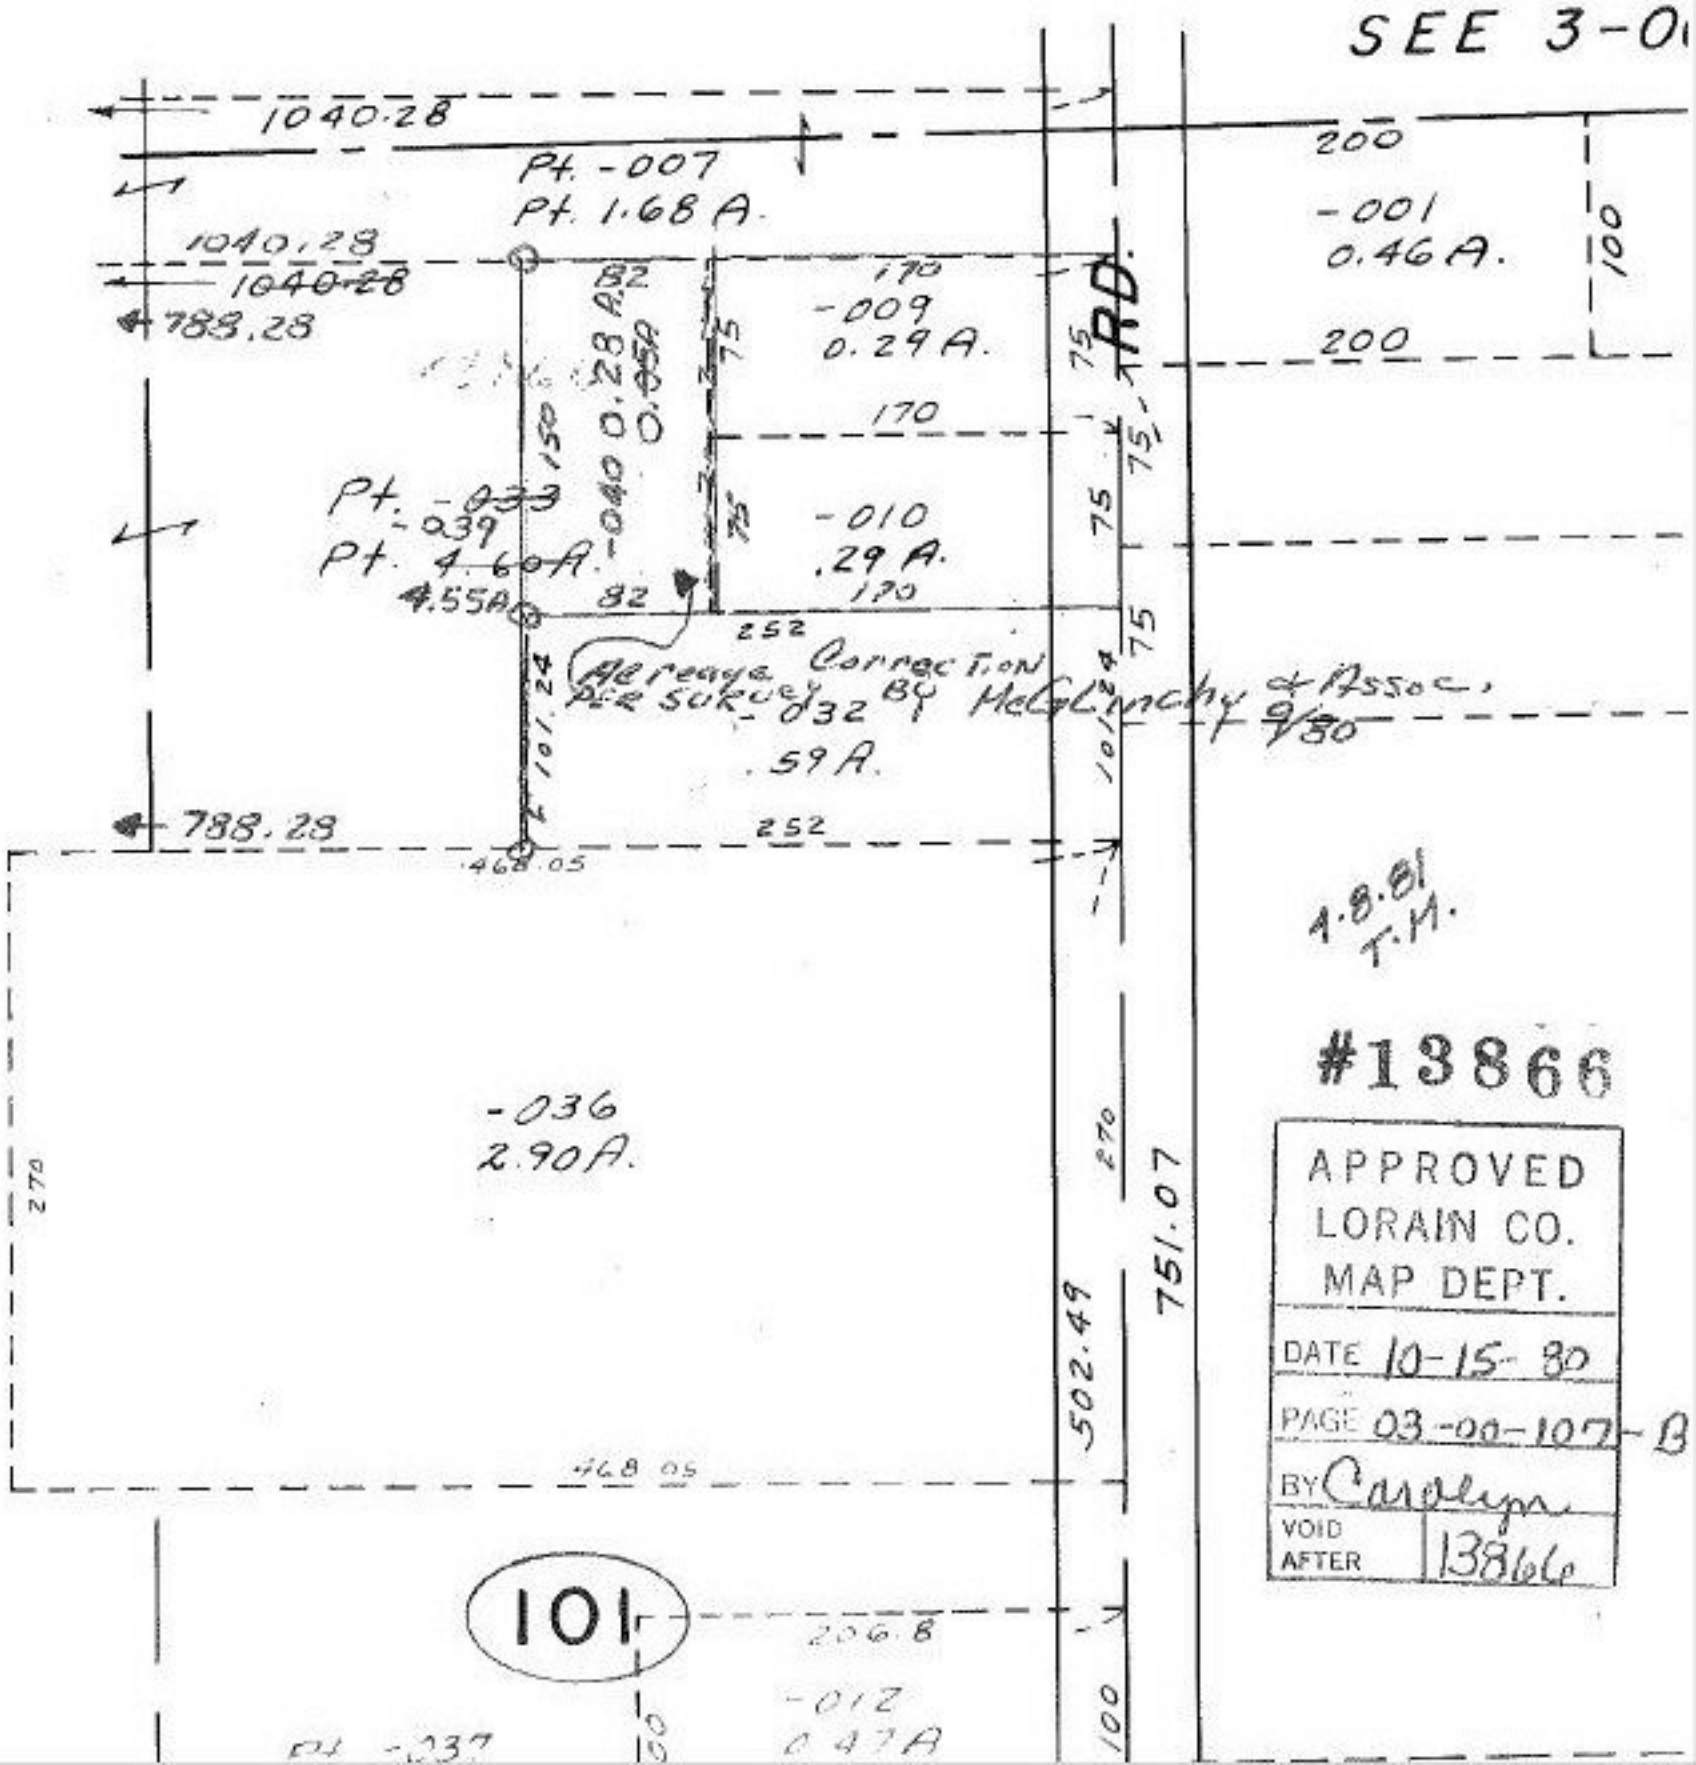

#13866

APPROVED
LORAIN CO.
MAP DEPT.

DATE 10-15-80

PAGE 03-00-107-B

BY Carolyn

VOID AFTER 13866