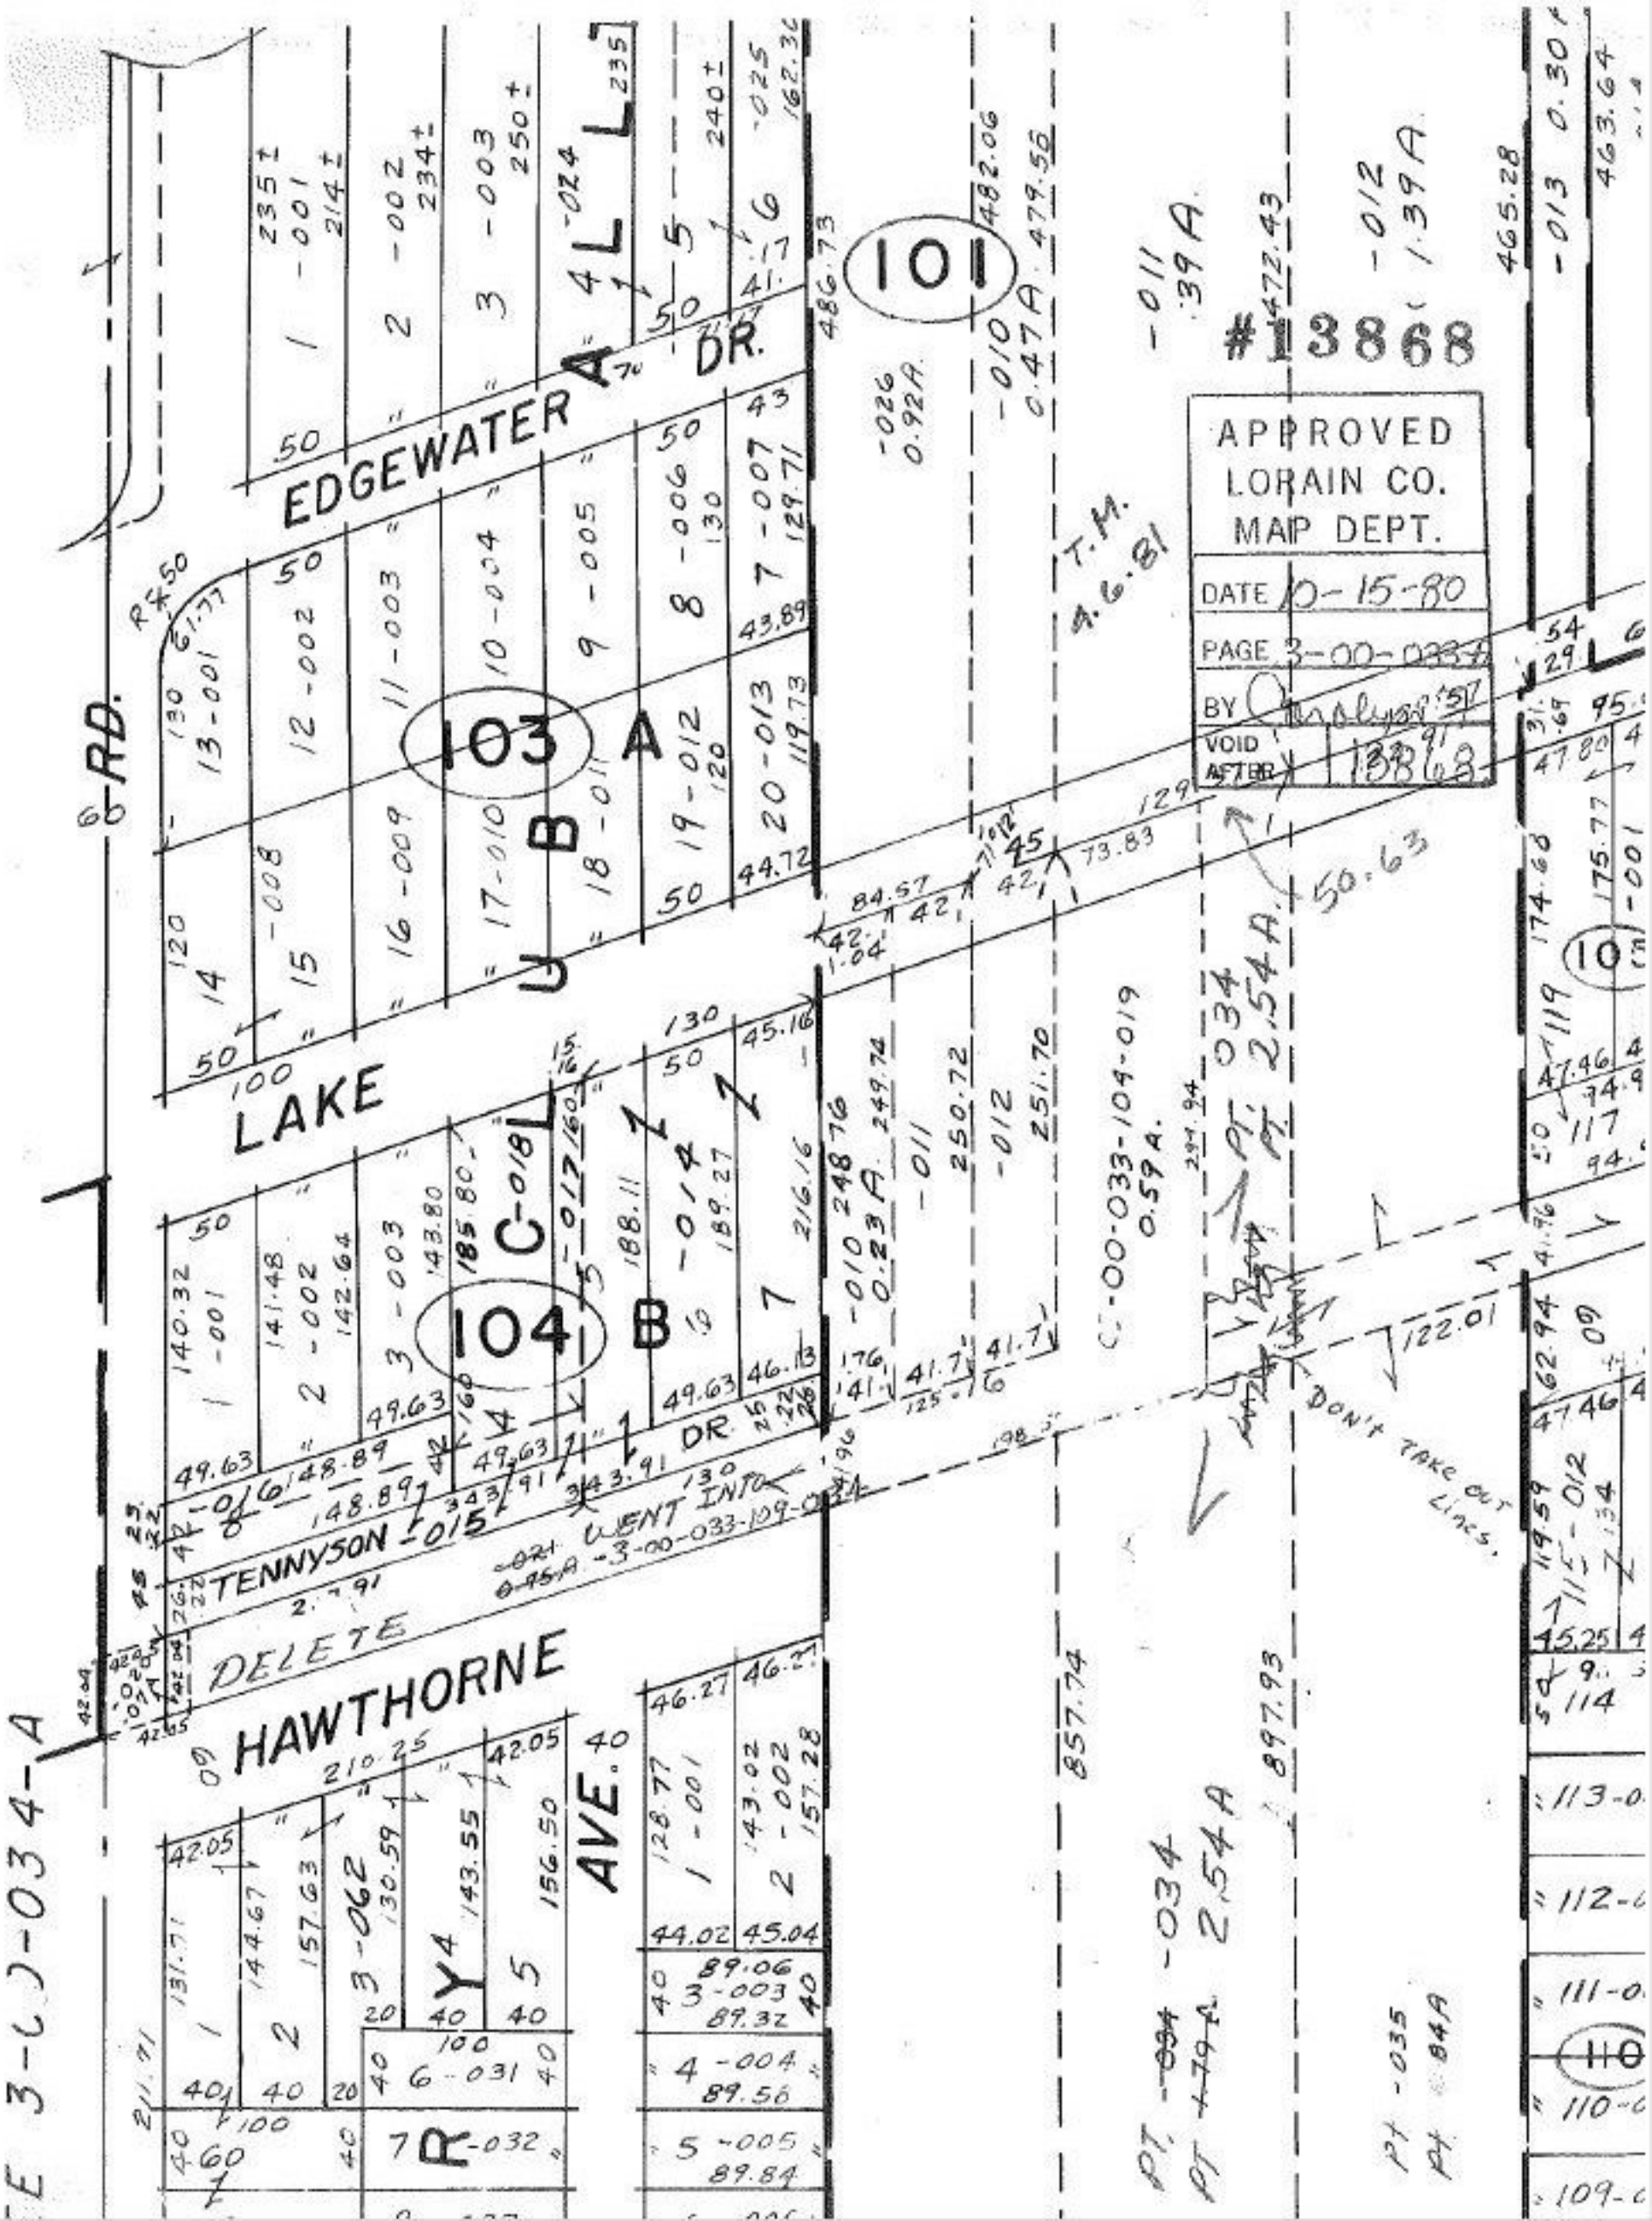

#13868
APPROVED
LORAIN CO.
MAP DEPT.
DATE 10-15-80
PAGE 3-00-033-A
BY
VOID AFTER 13868
EDGEWATER DR.
LAKE
HAWTHORNE AVE.
TENNYSON DR.
DELETE
WENT INTO
DON'T TAKE OUT LINES.
T.M. 4.6.81
101
103 A
104 B
110