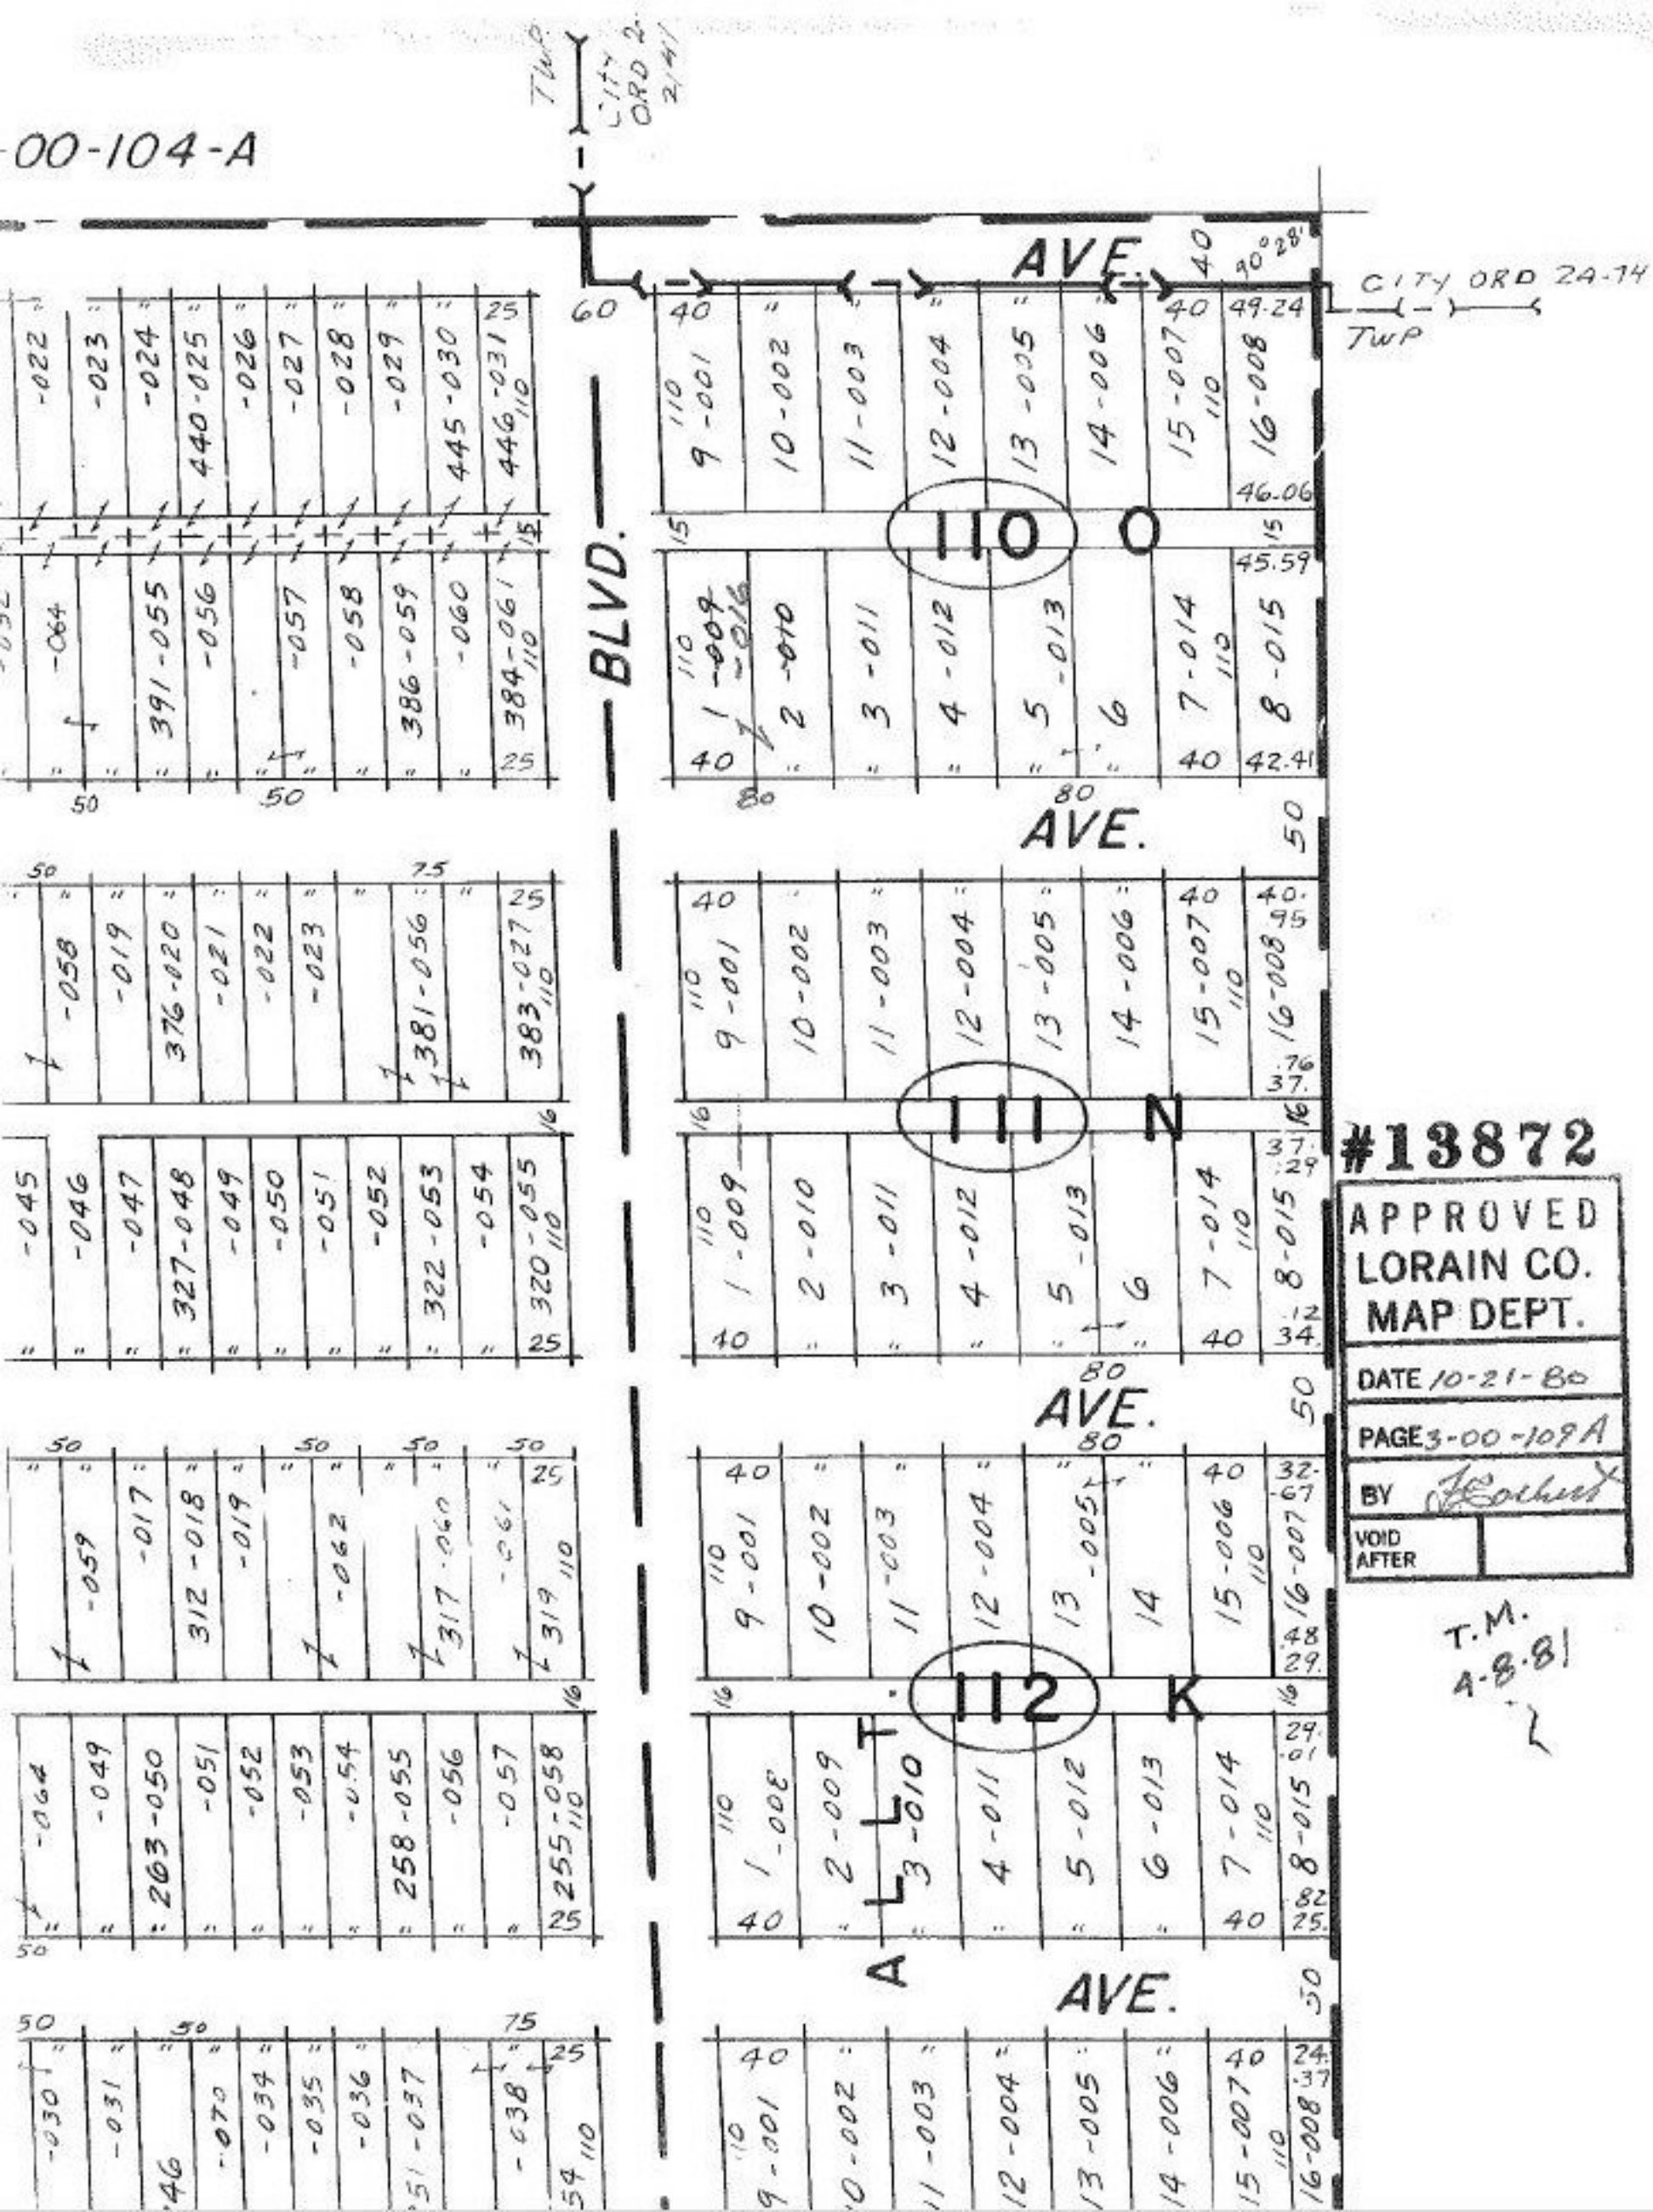

#13872

APPROVED
LORAIN CO.
MAP DEPT.

DATE 10-21-80

PAGE 3-00-109A

BY [signature]

VOID AFTER

T.M.
4-8-81