#13873

APPROVED
LORAIN CO.
MAP DEPT.
DATE 10-21-80
PAGE 3-00-037-A
BY
VOID AFTER

T.M.
A-6-81

Erie
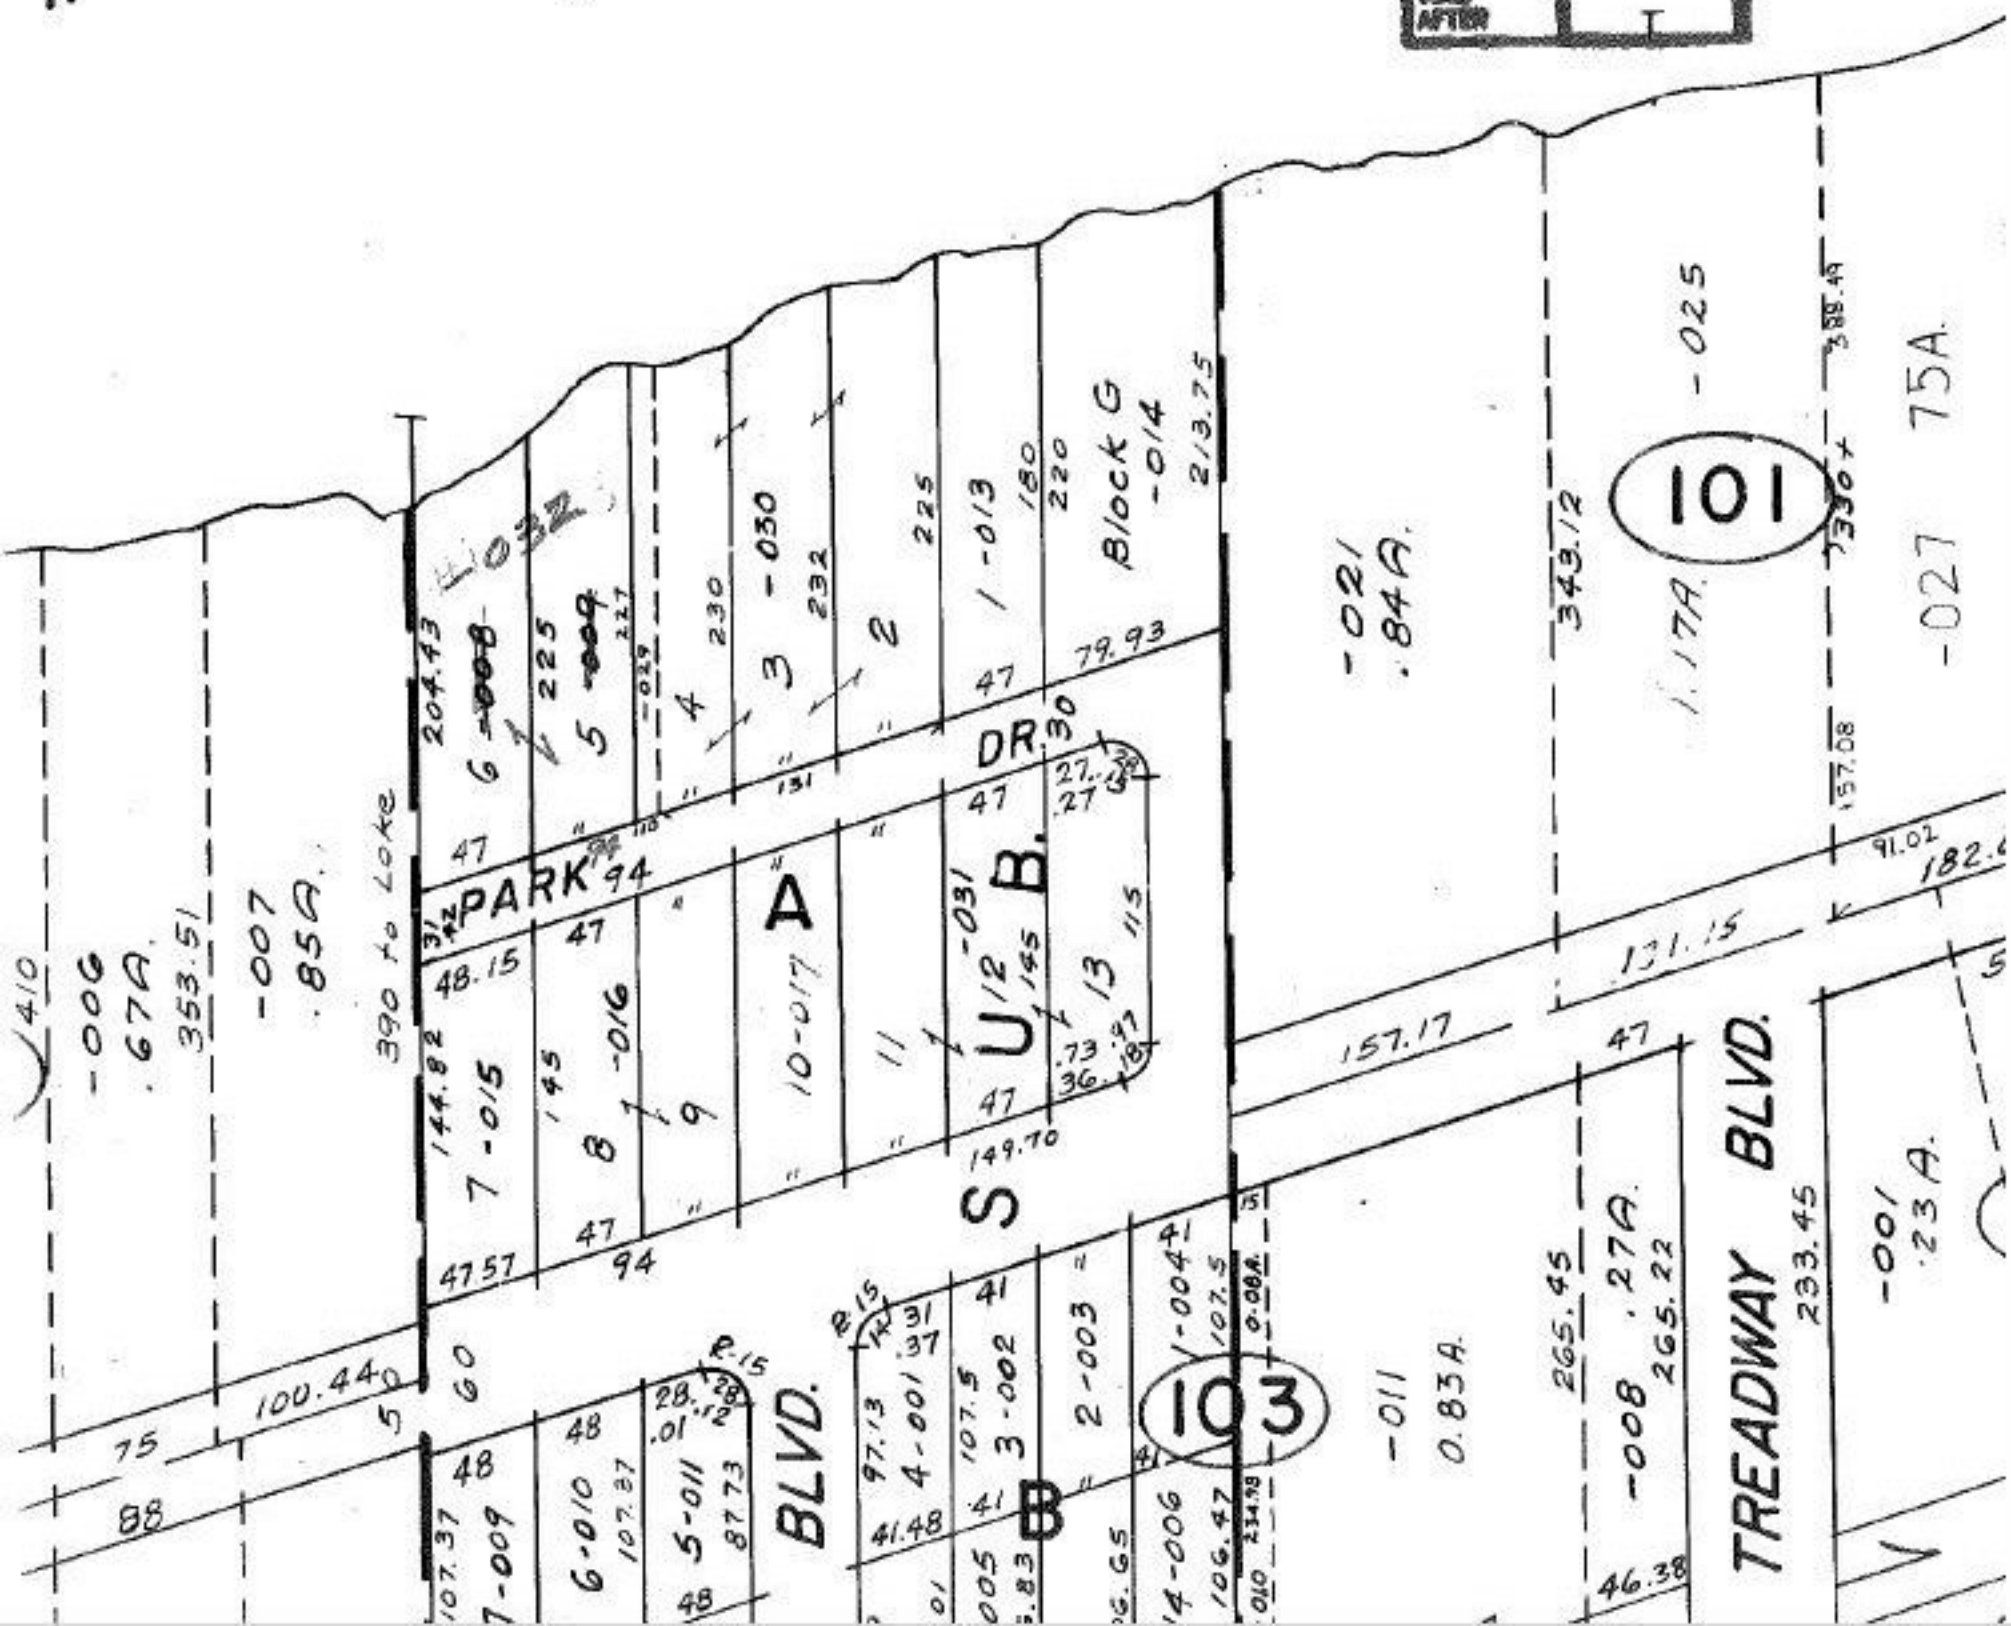
Lake