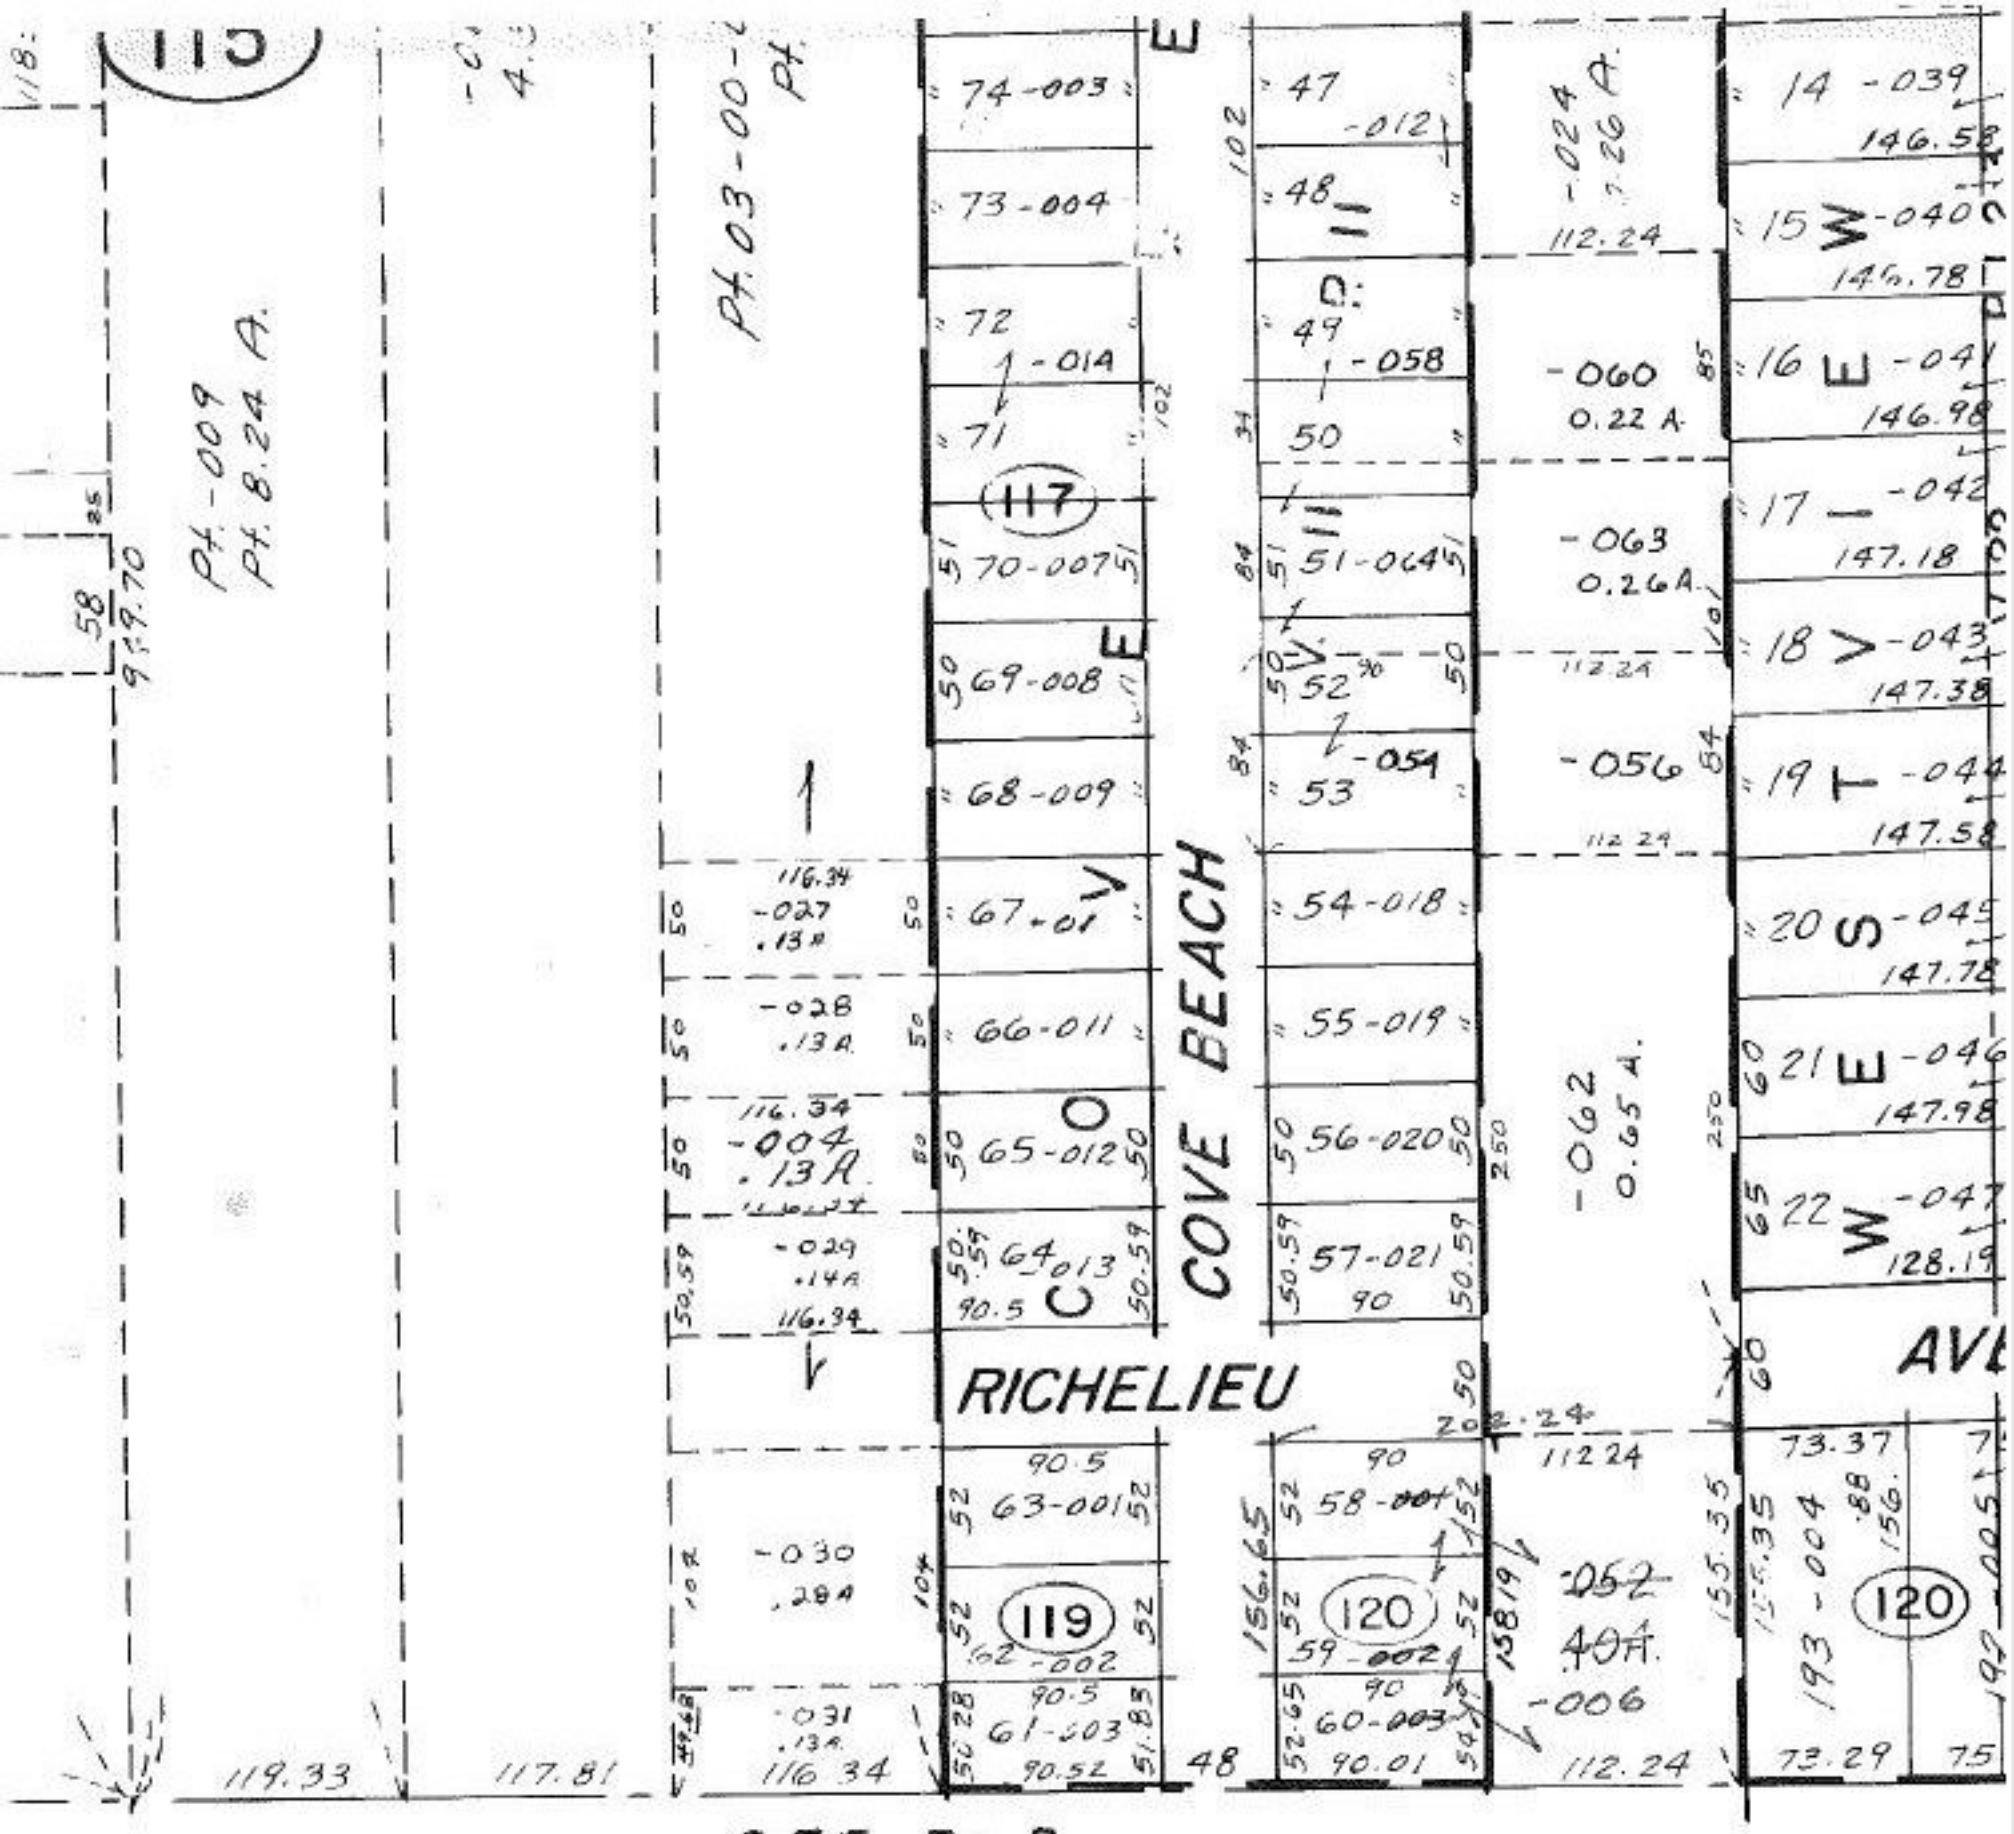

SEE 3-D

#13873

APPROVED
LORAIN CO.
MAP DEPT.

DATE 10-21-80

PAGE 3-00-033 B

BY [signature]

VOID AFTER

T.M.
1.6.81

WP