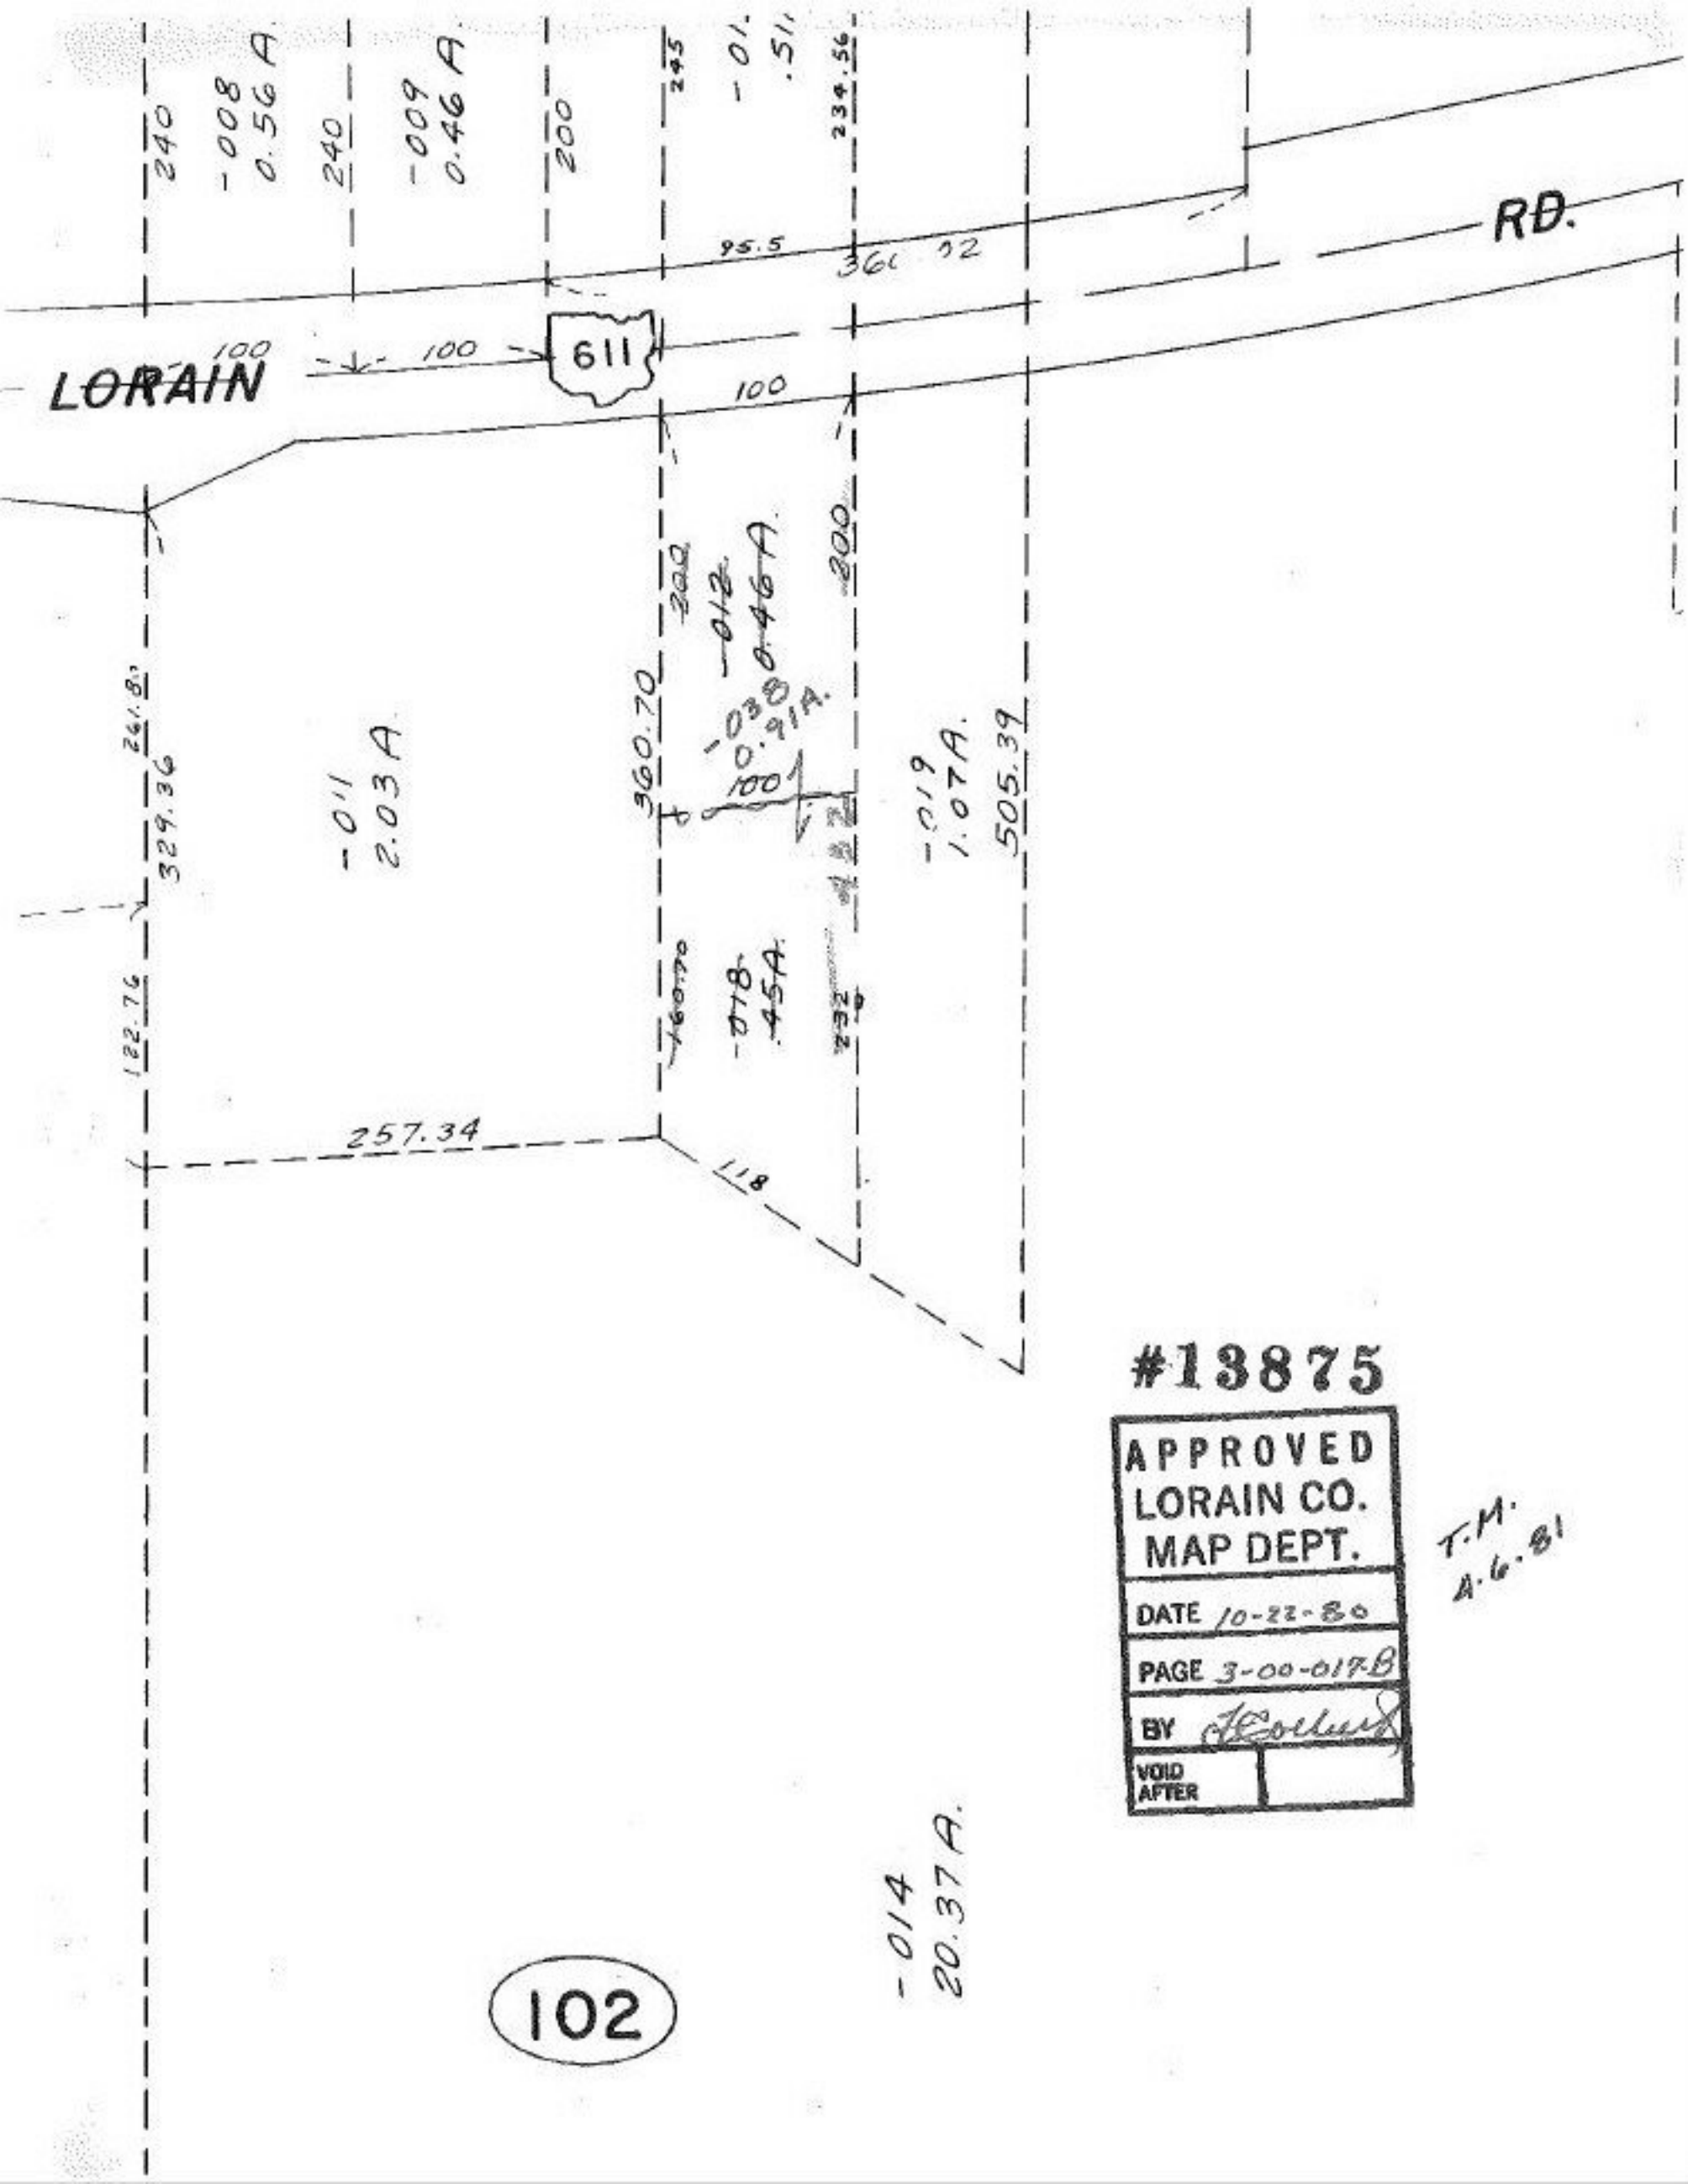

#13875

APPROVED
LORAIN CO.
MAP DEPT.

DATE 10-22-80

PAGE 3-00-017-B

BY [signature]

VOID AFTER

T.M.
4.6.81