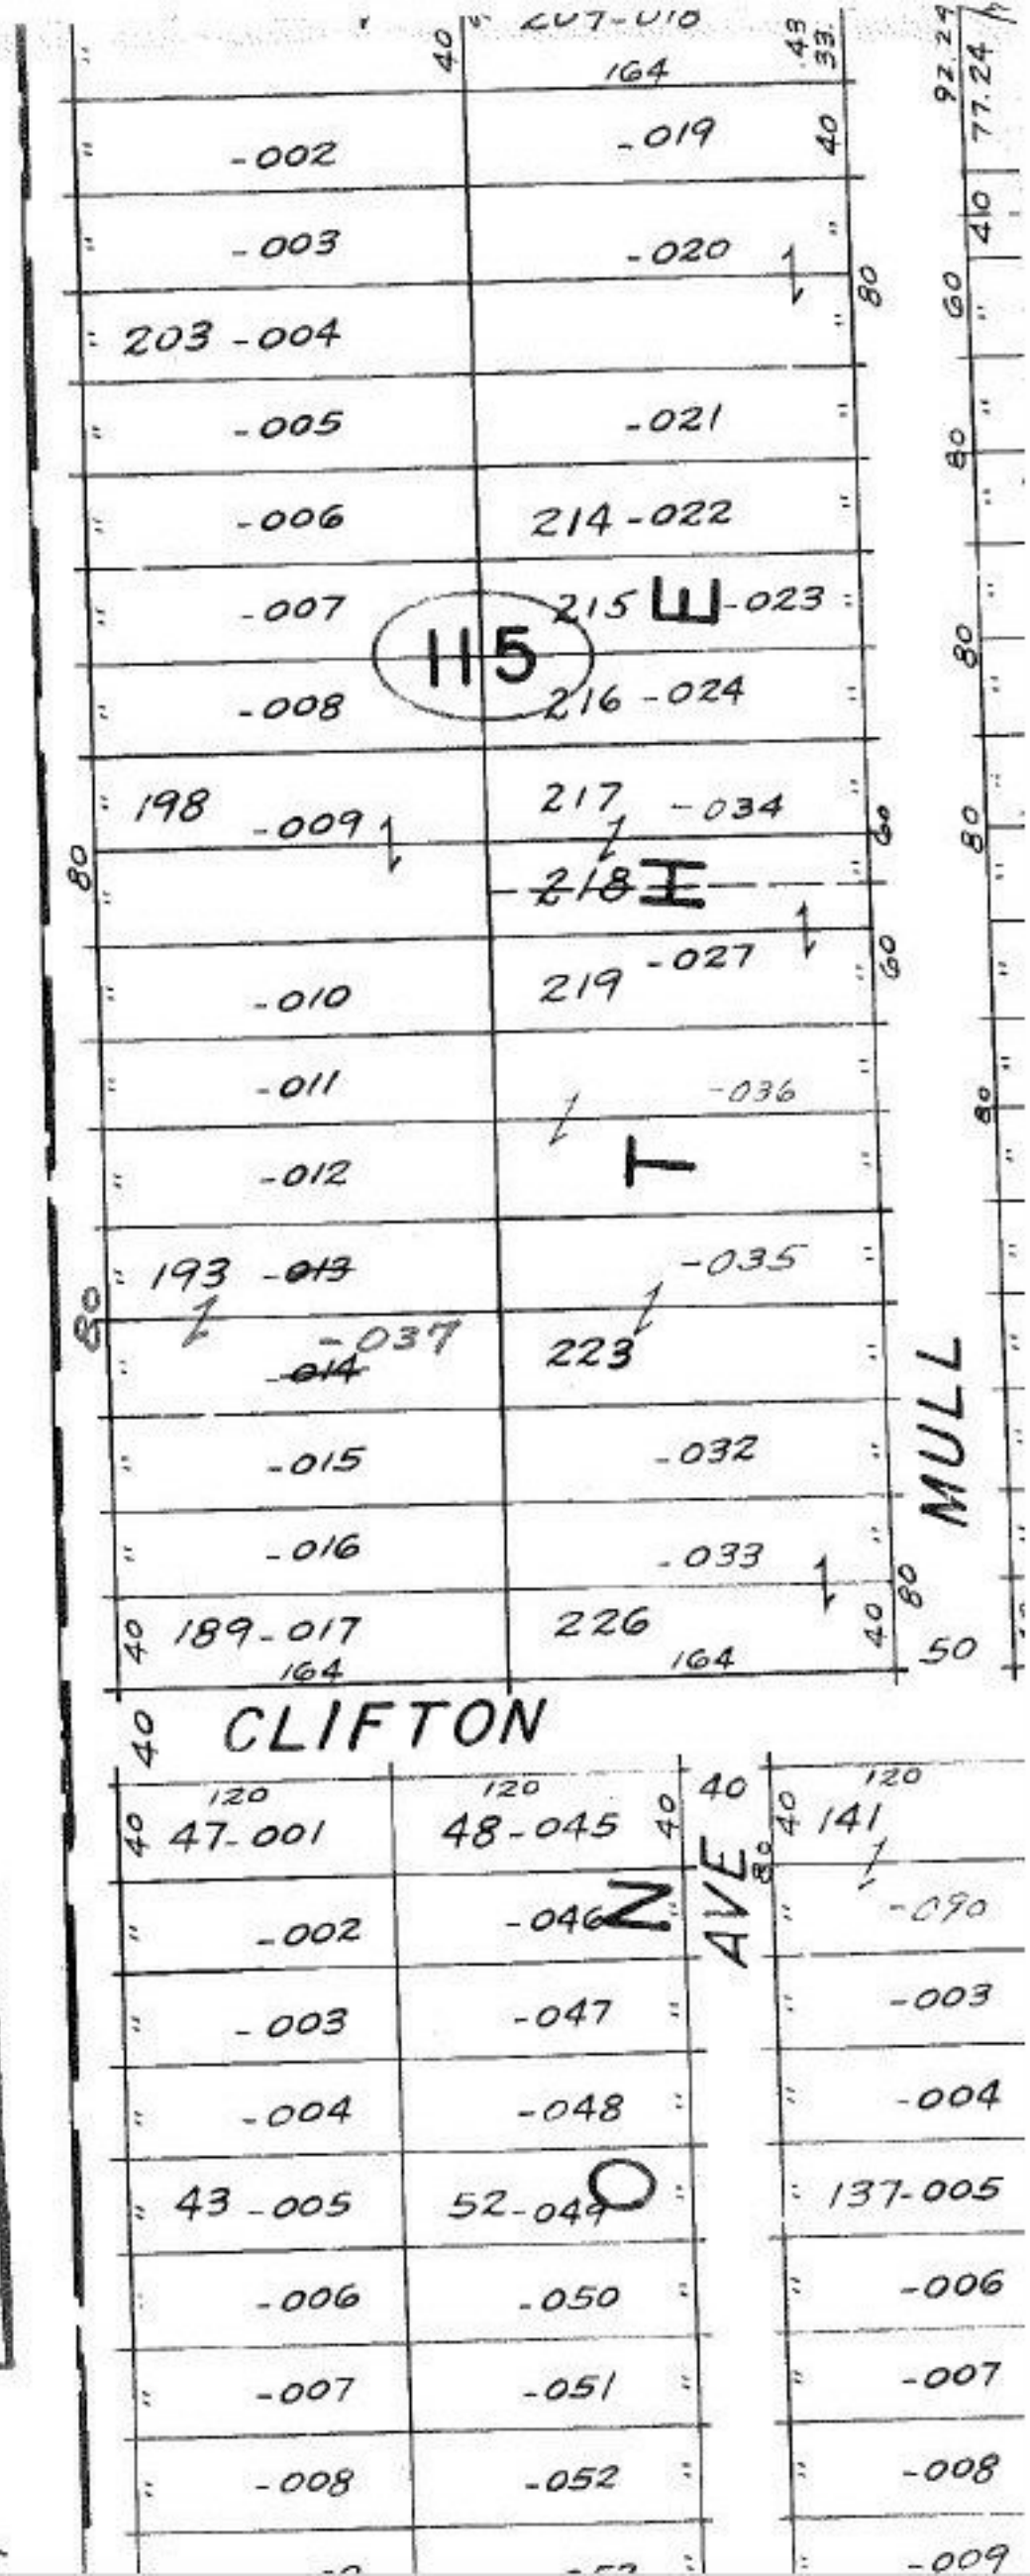

#13875
APPROVED
LORAIN CO.
MAP DEPT.
DATE 10-22-80
PAGE 400-030 A
BY
VOID AFTER
APR 10 1981

EC. 30