Dick Sly
282 9711

Nick Curci
244-4568

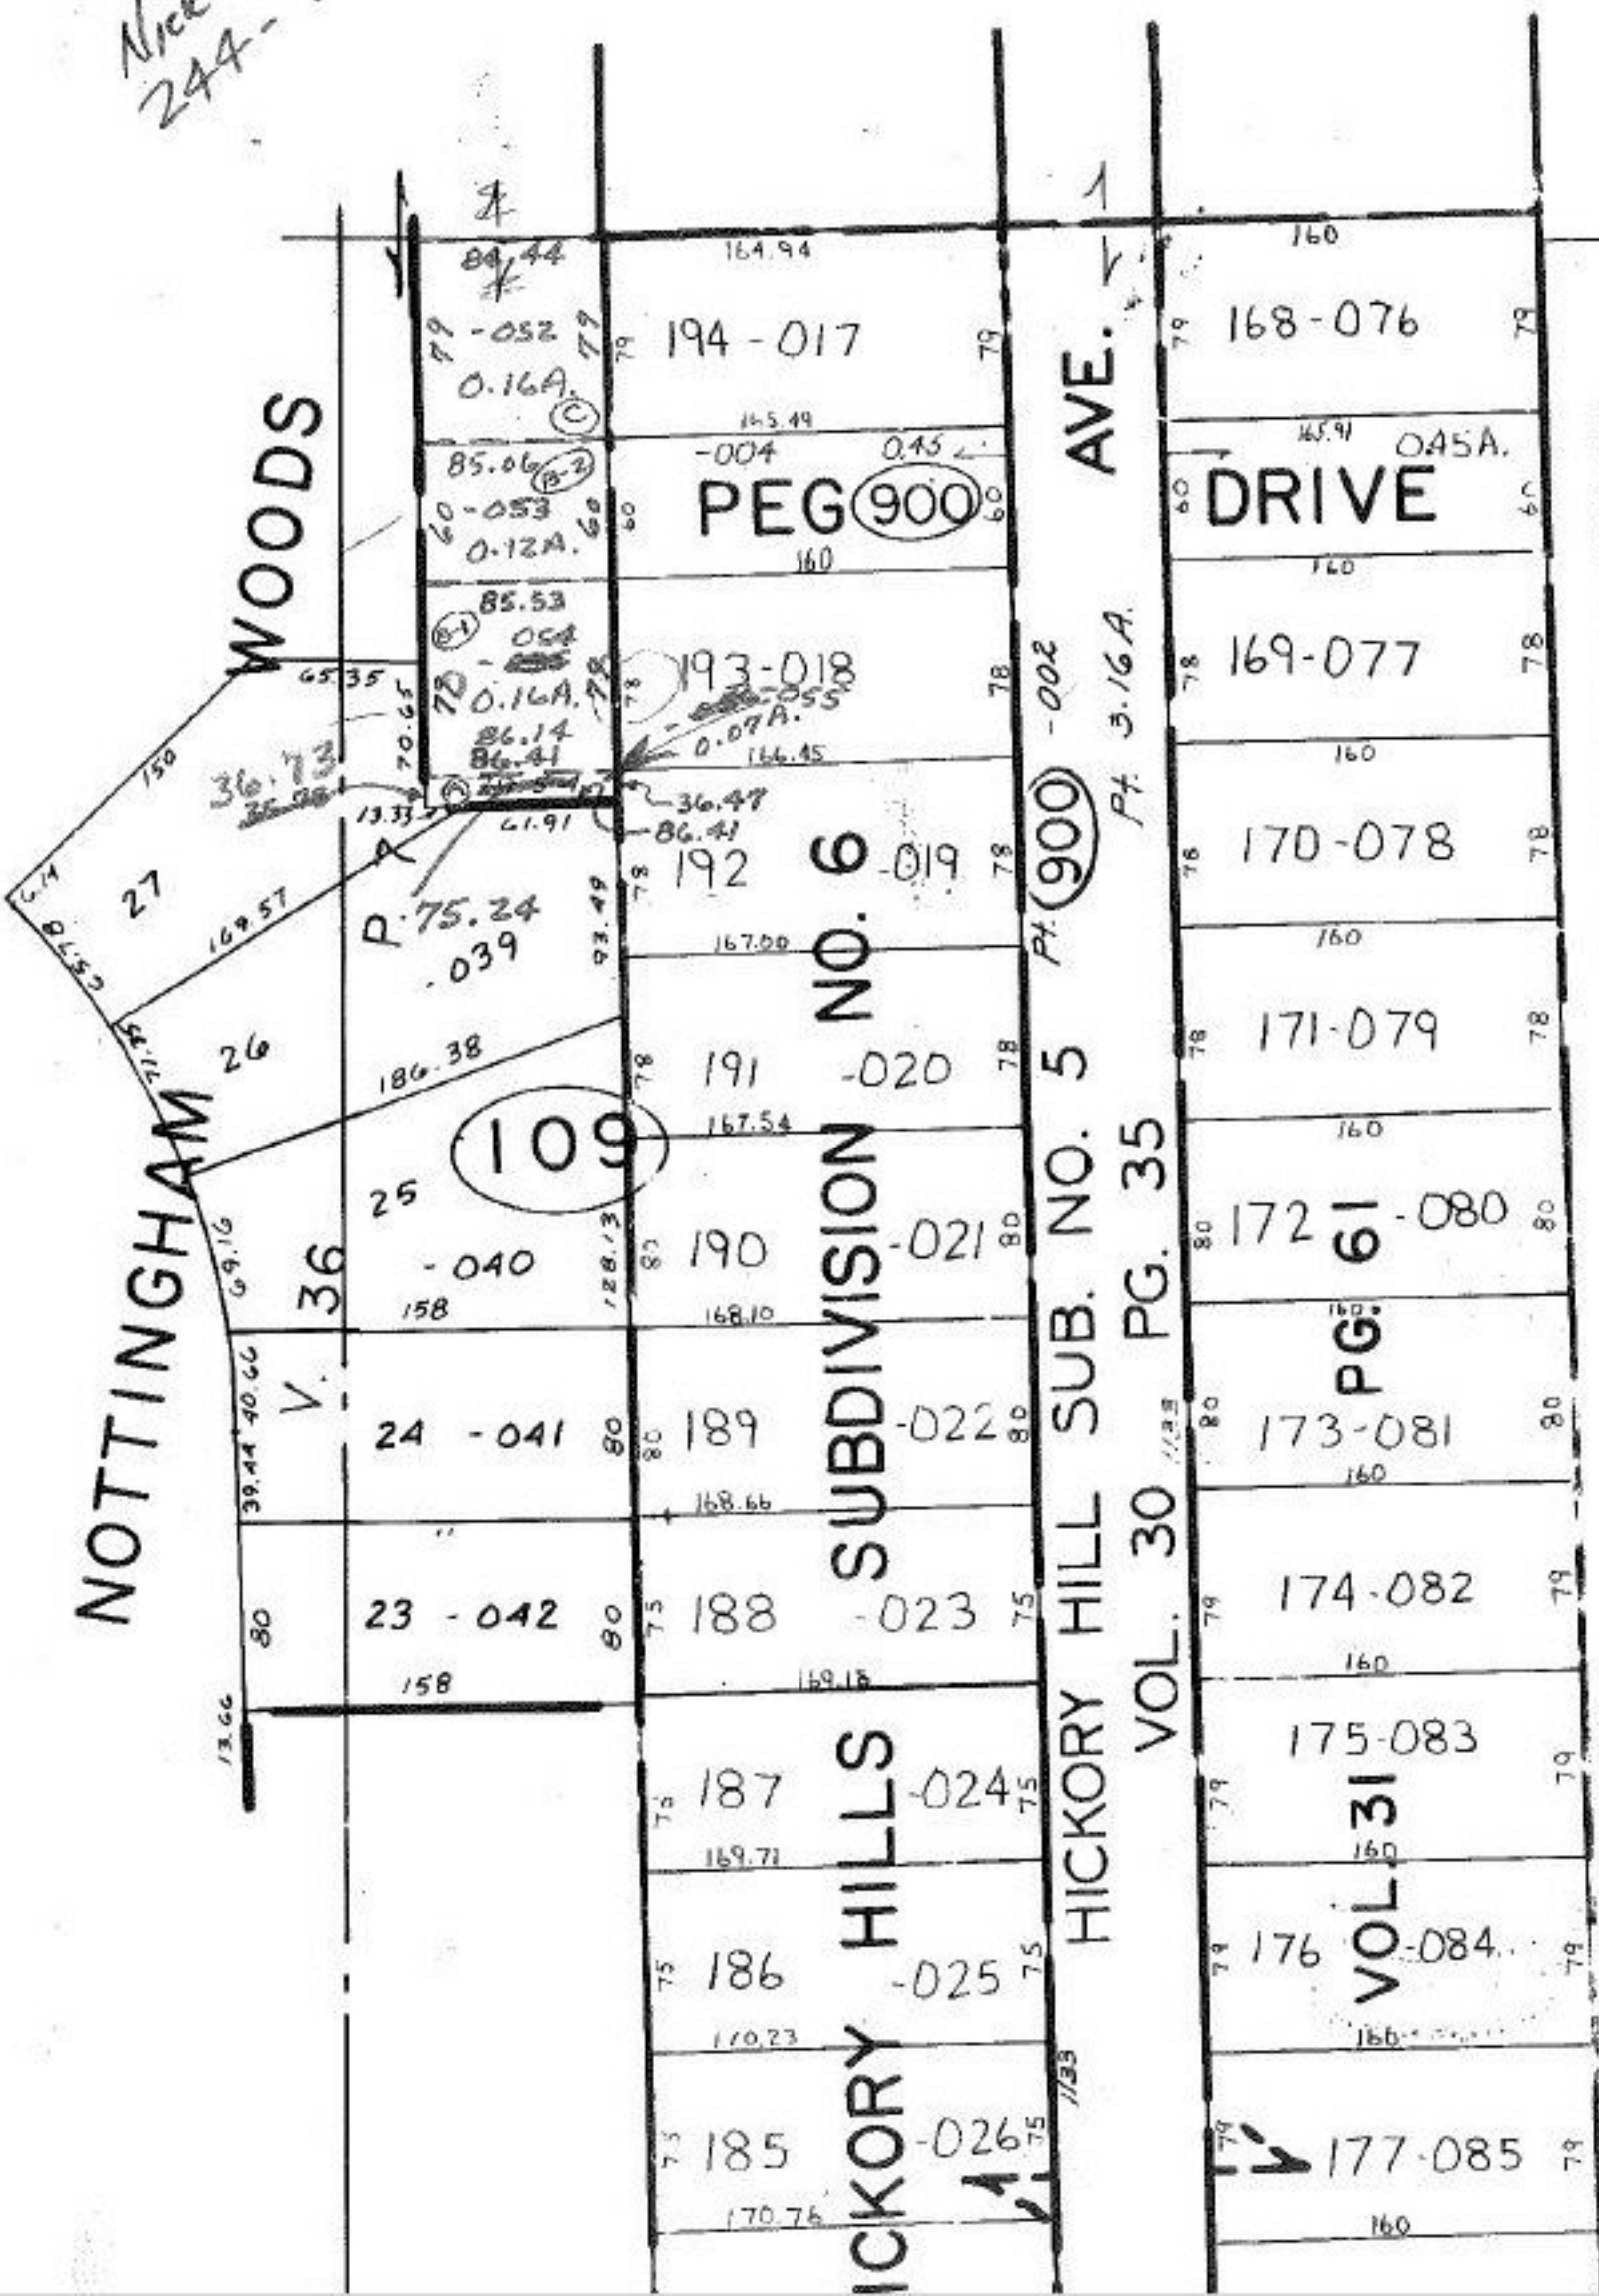


#13878

APPROVED
LORAIN CO.
MAP DEPT.
DATE 10-21-80
PAGE 2-01-007-B
BY [signature]
VOID AFTER

T.M.
3.18.81