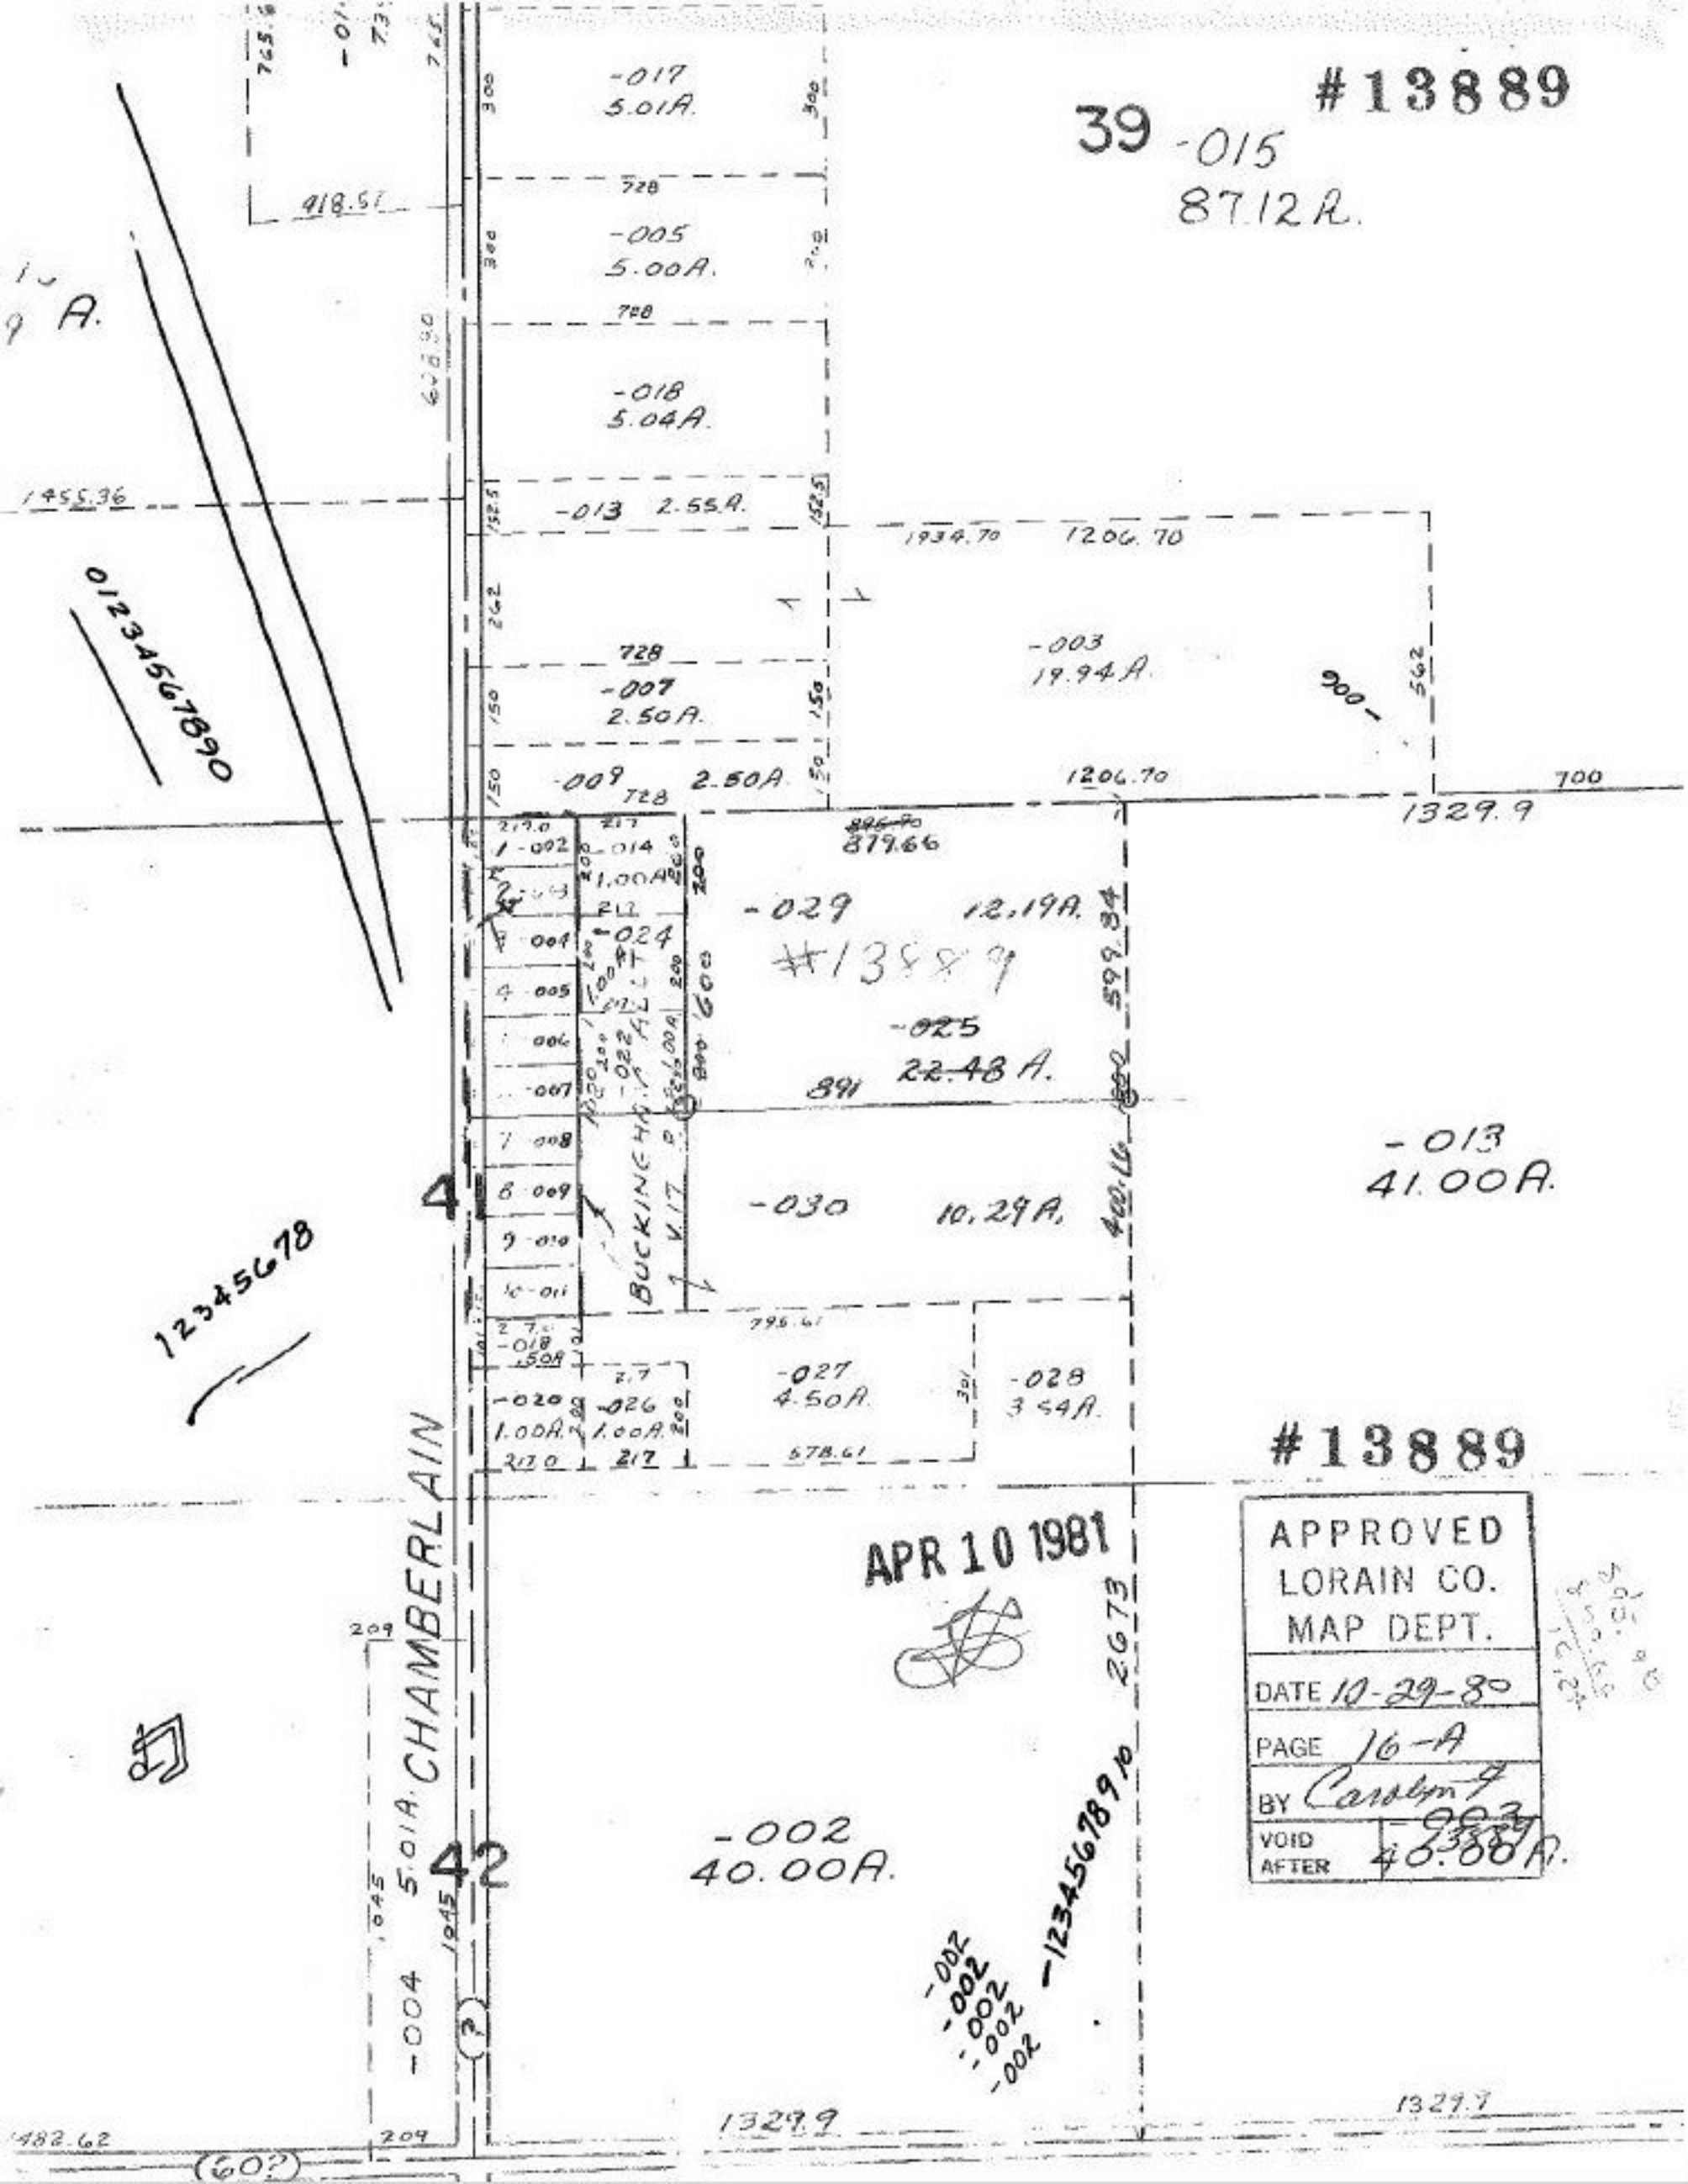

#13889
39 -015
87.12 A.
-017
5.01A.
-005
5.00A.
-018
5.04A.
-013 2.55A.
-003
19.94A.
-007
2.50A.
-009 2.50A.
-029 12.19A.
#13889
-025
22.48 A.
-030 10.29A.
-013
41.00A.
-027
4.50A.
-028
3.54A.
-020
1.00A.
-026
1.00A.
-002
40.00A.
-004 5.01A.
CHAMBERLAIN
BUCKINGHAM
12345678
01234567890
12345678910
1455.36
1934.70
1206.70
1329.9
879.66
599.84
400.16
2673
1329.9
1329.9
482.62
(60?)
#13889
APR 10 1981
APPROVED
LORAIN CO.
MAP DEPT.
DATE 10-29-80
PAGE 16-A
BY Carolyn
VOID AFTER