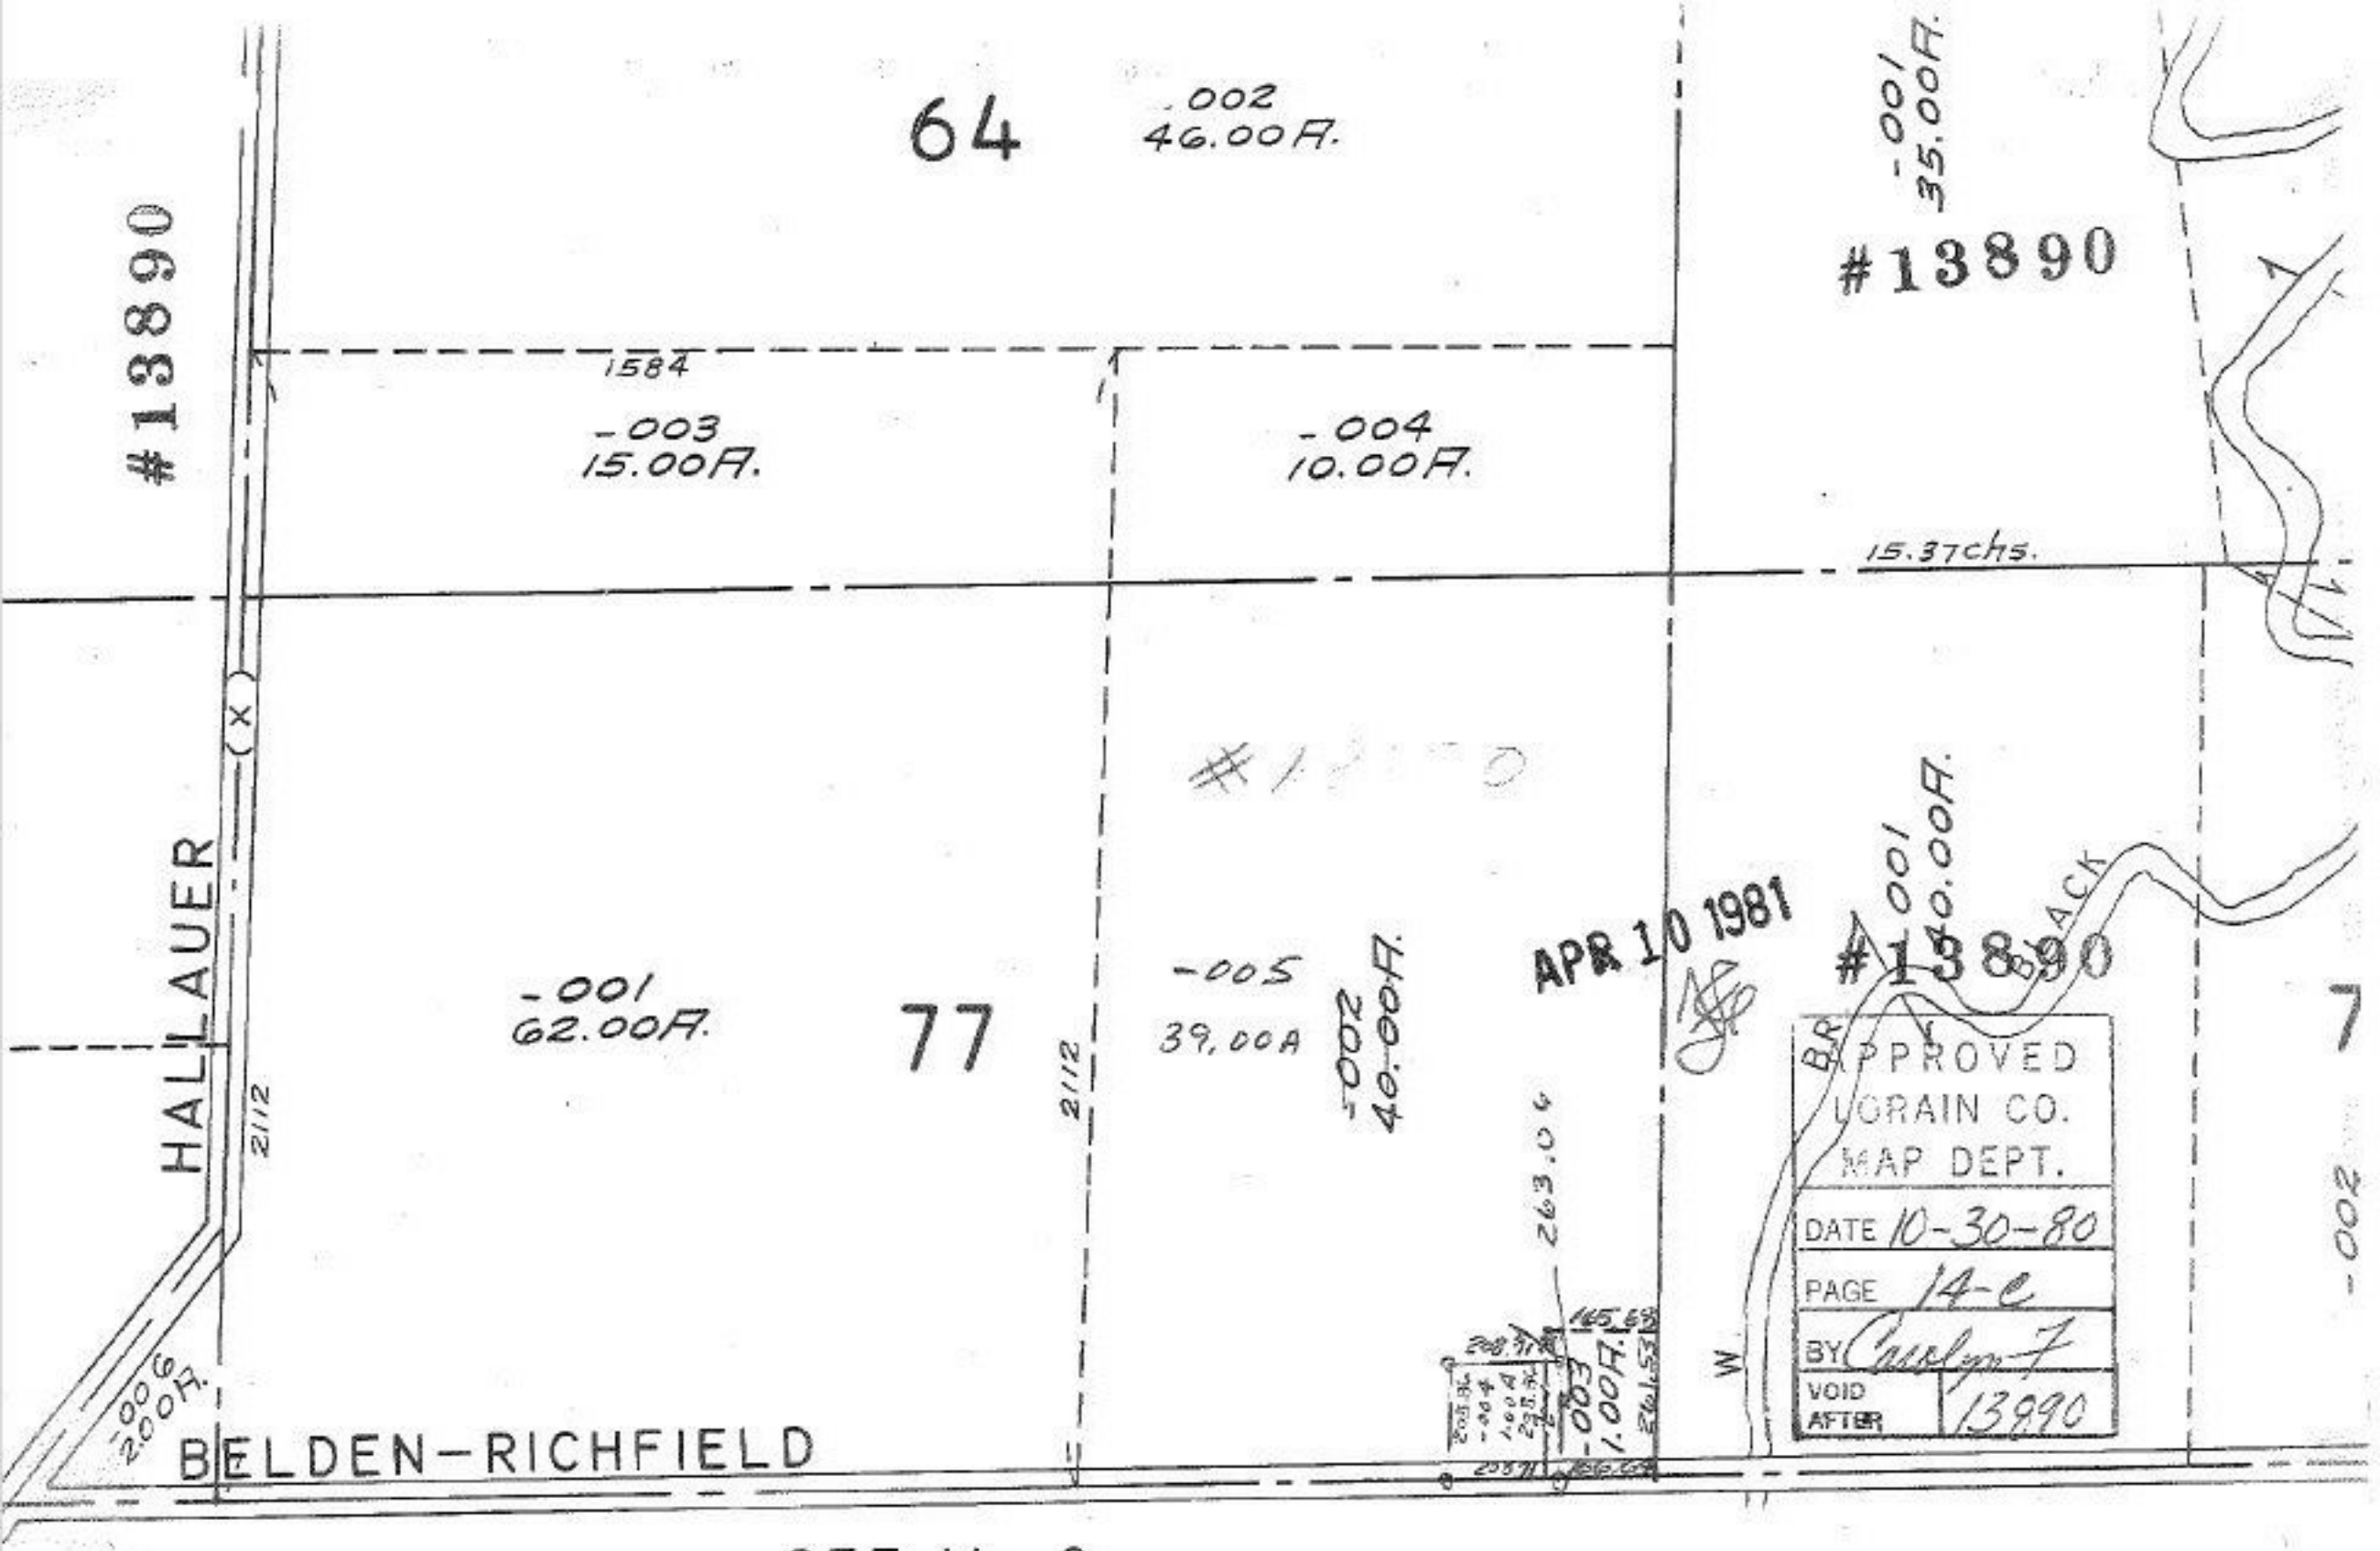


# TWP.

LOTS 3,4,5,16,17,18,23,24,25
43,44,45,56,57,58,63,64,6