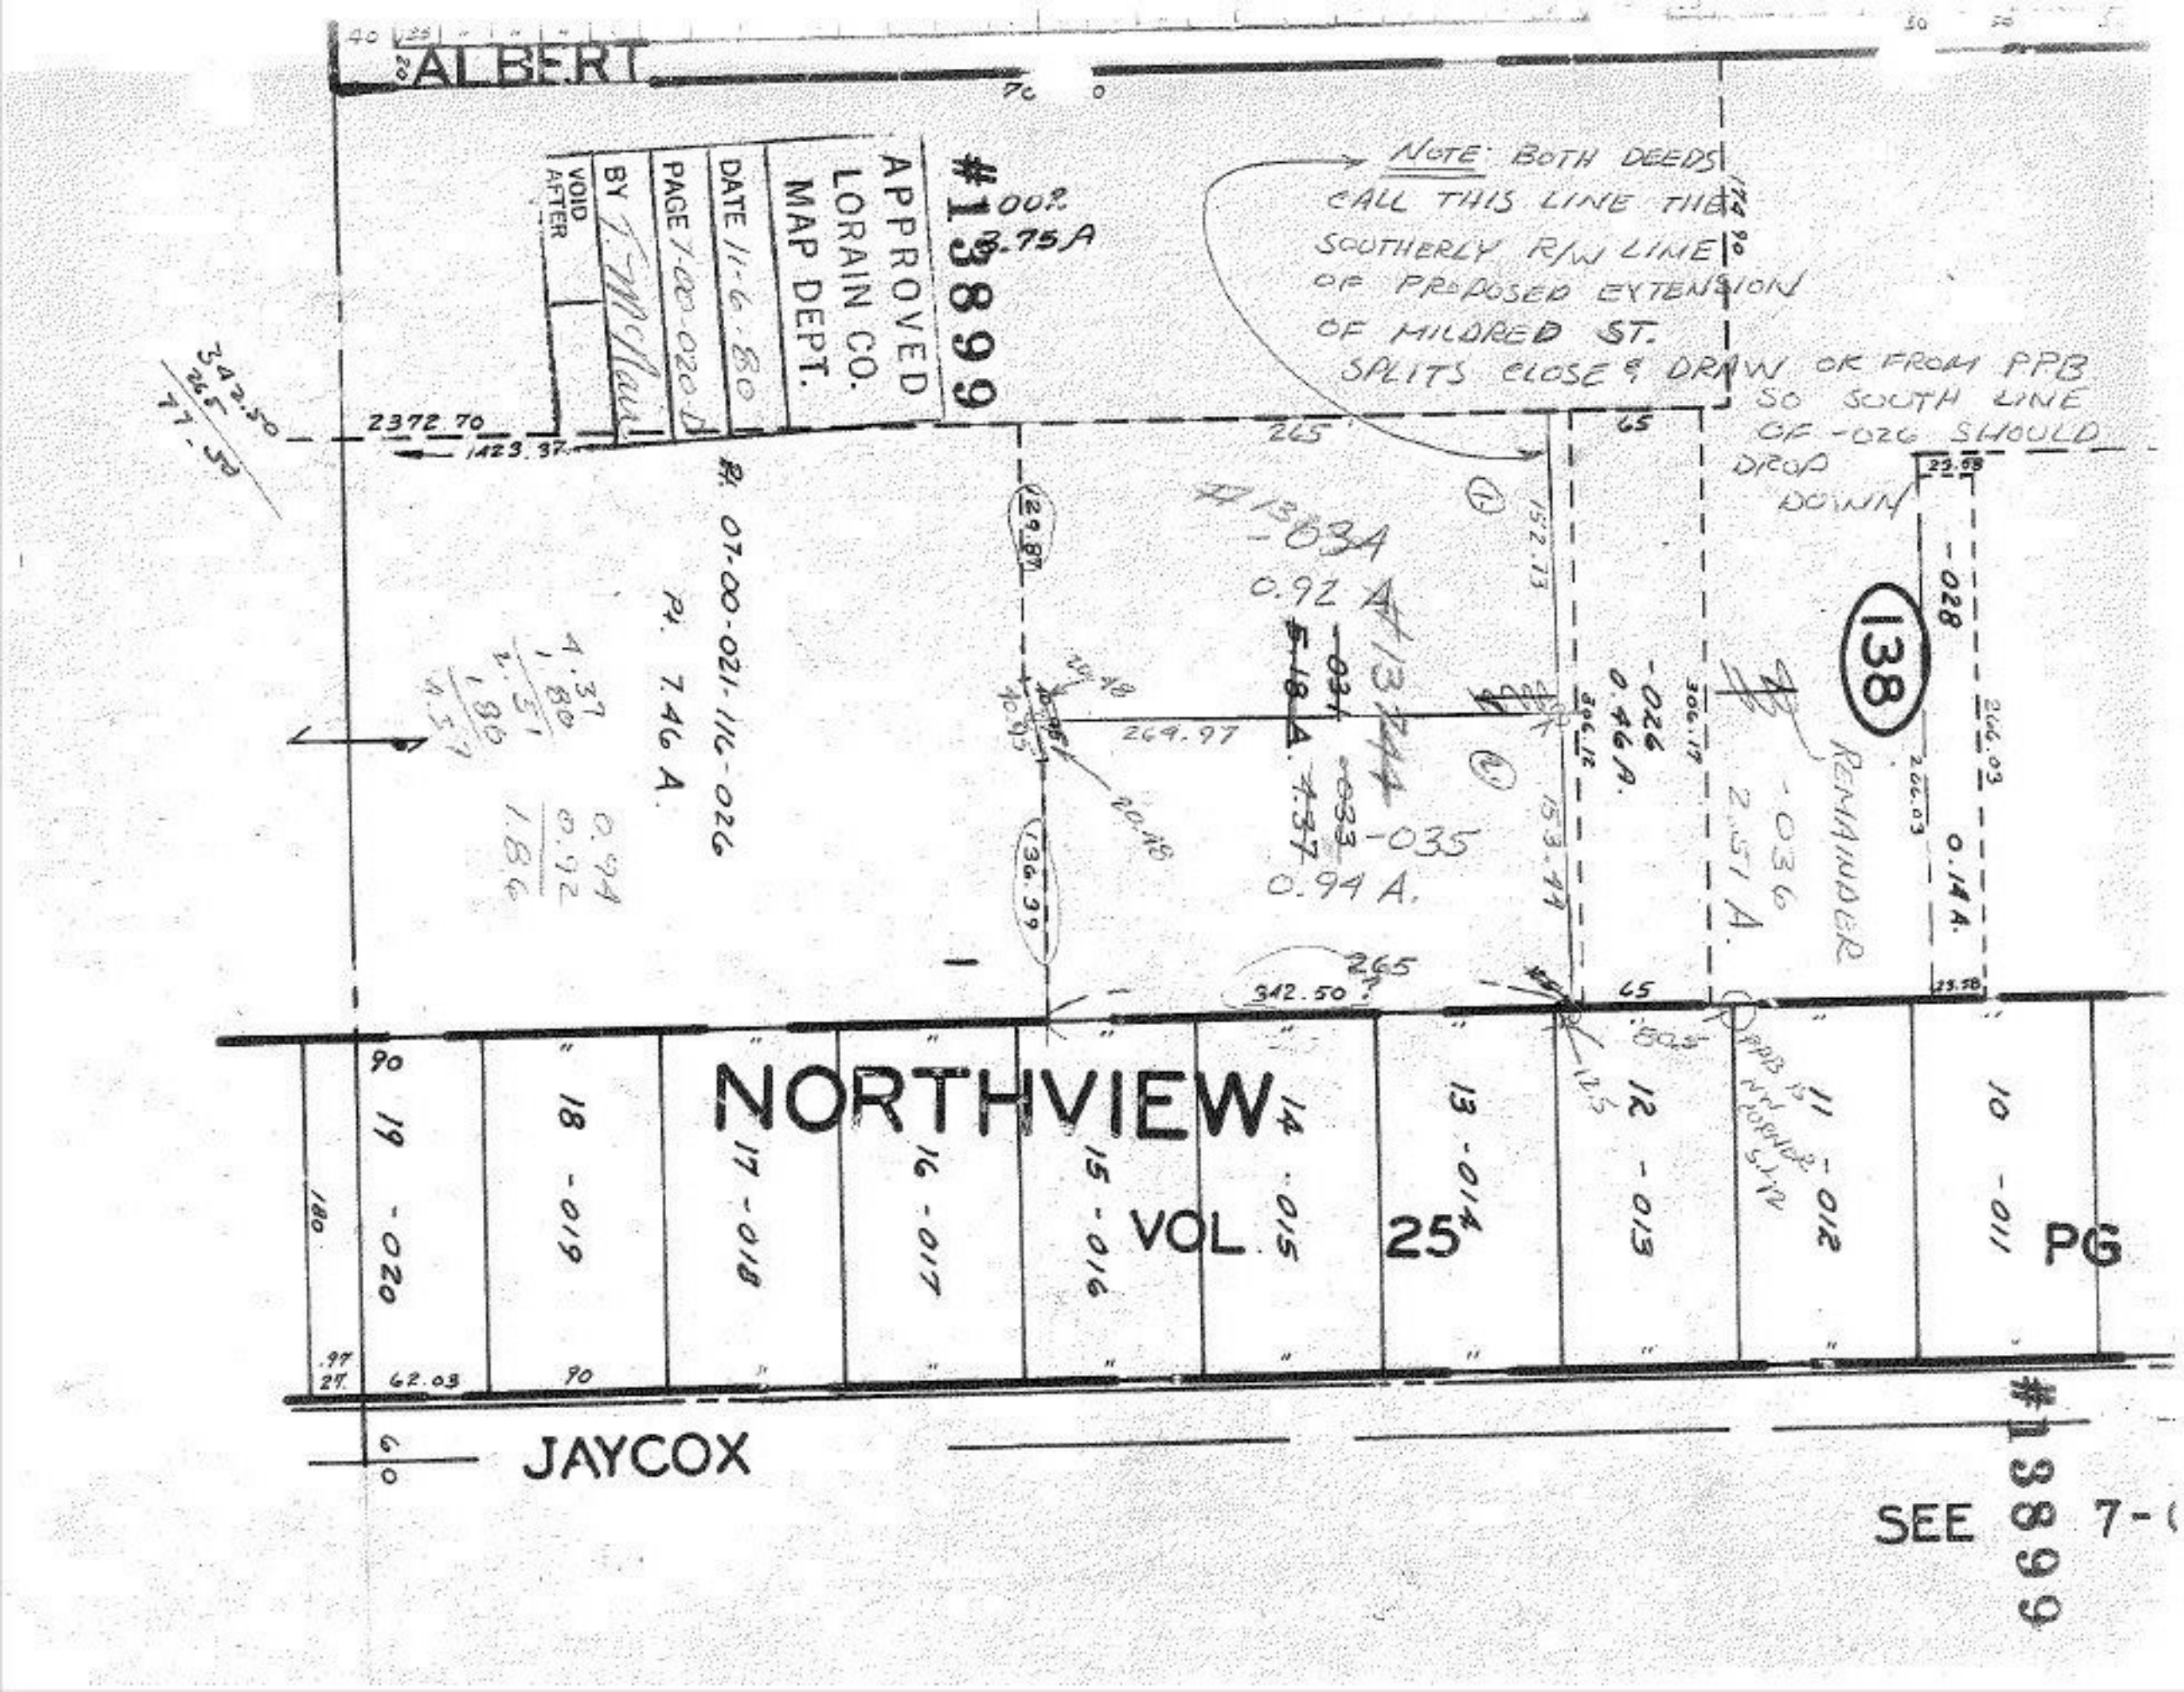
ALBERT
#13899
APPROVED
LORAIN CO.
MAP DEPT.
DATE 11-6-80
PAGE 7-00-020-D
BY
VOID AFTER
NOTE: BOTH DEEDS CALL THIS LINE THE SOUTHERLY R/W LINE OF PROPOSED EXTENSION OF MILDRED ST. SPLITS CLOSE & DRAW OK FROM PPB SO SOUTH LINE OF -026 SHOULD DROP DOWN
2372.70
1423.37
342.50
265
77.50
Pt. 07-00-021-116-026
Pt. 7.46 A.
-034
0.92 A
-035
0.94 A.
-026
0.46 A.
-036
2.51 A.
-028
0.14 A.
REMAINDER
138
NORTHVIEW
VOL. 25
PG
19 -020
18 -019
17 -018
16 -017
15 -016
14 -015
13 -014
12 -013
11 -012
10 -011
JAYCOX
SEE 7-
#13899