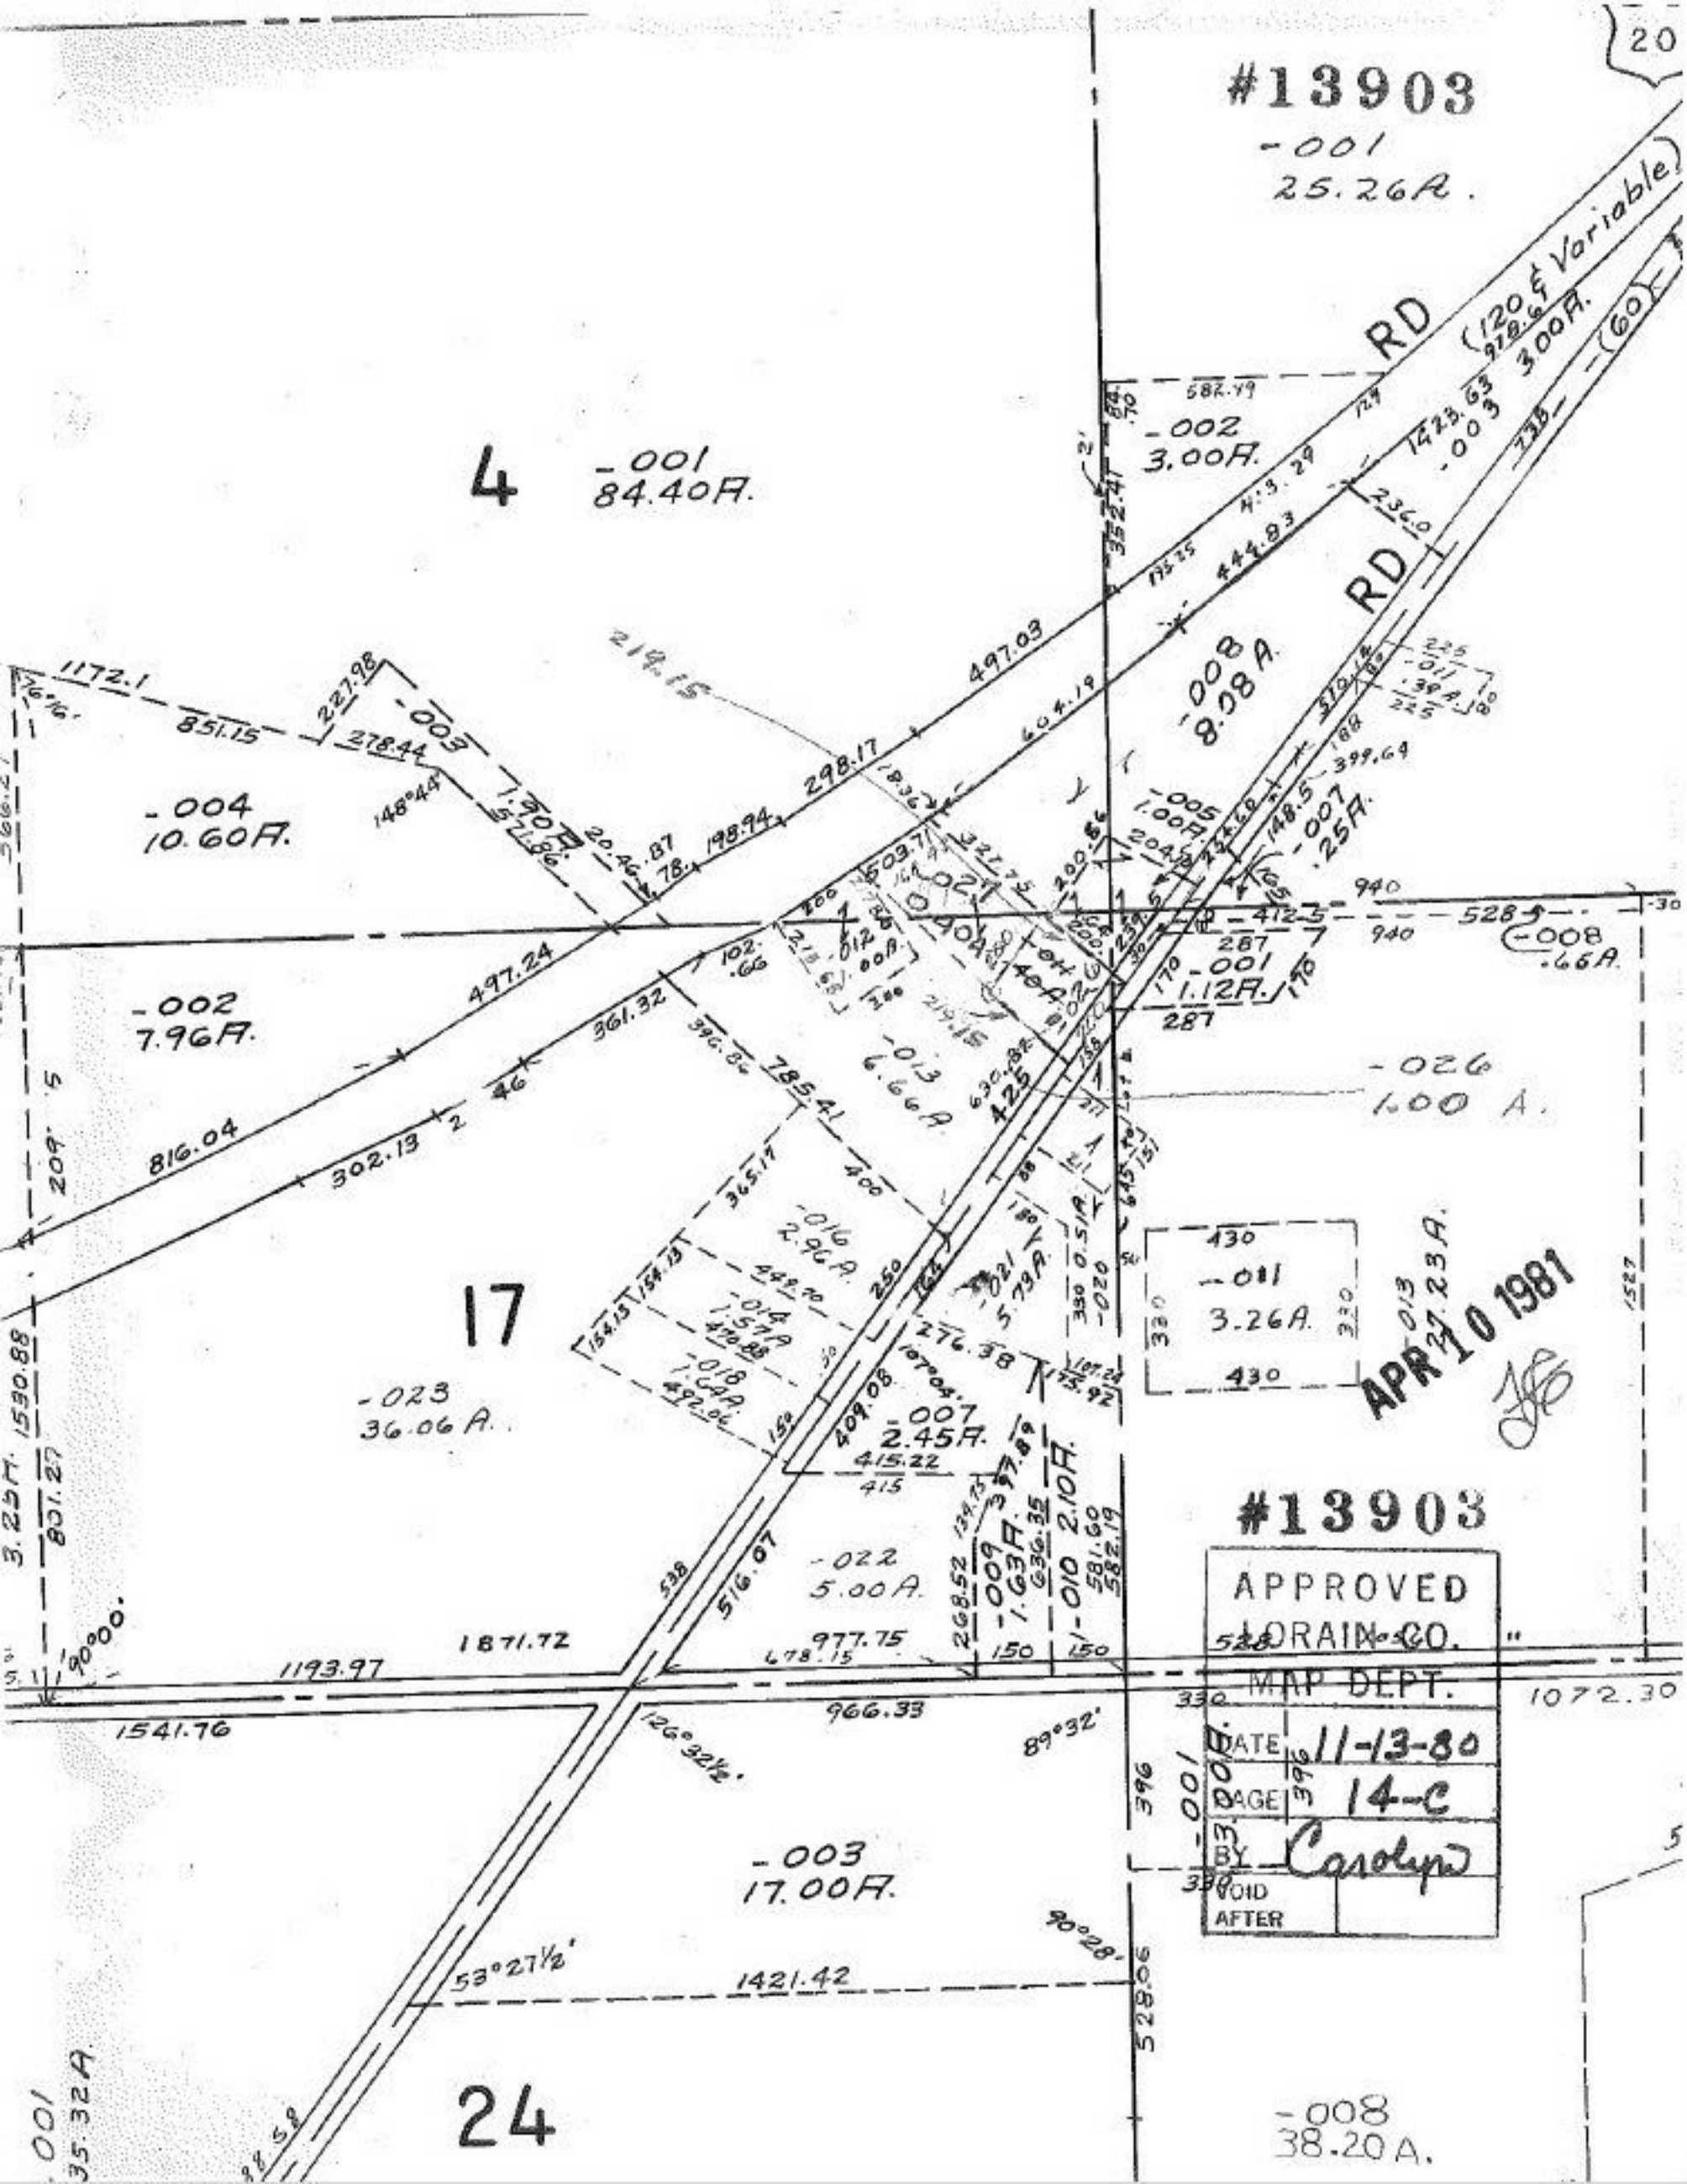

#13903
-001
25.26A.
4
-001
84.40A.
-002
3.00A.
RD
(120 & Variable)
3.00A.
-003
RD
-008
8.08A.
-004
10.60A.
-002
7.96A.
-005
1.00A.
-007
.25A.
-001
1.12A.
-008
.66A.
-026
1.00 A.
-013
6.66A.
-016
2.96A.
-014
1.57A.
-018
1.64A.
-021
5.73A.
-011
3.26A.
17
-023
36.06 A.
-007
2.45A.
-022
5.00A.
-009
1.63A.
-010
2.10A.
-003
17.00A.
24
-008
38.20 A.
APR 10 1981
#13903
APPROVED
LORAIN CO.
MAP DEPT.
DATE 11-13-80
PAGE 14-C
BY Carolyn
VOID
AFTER