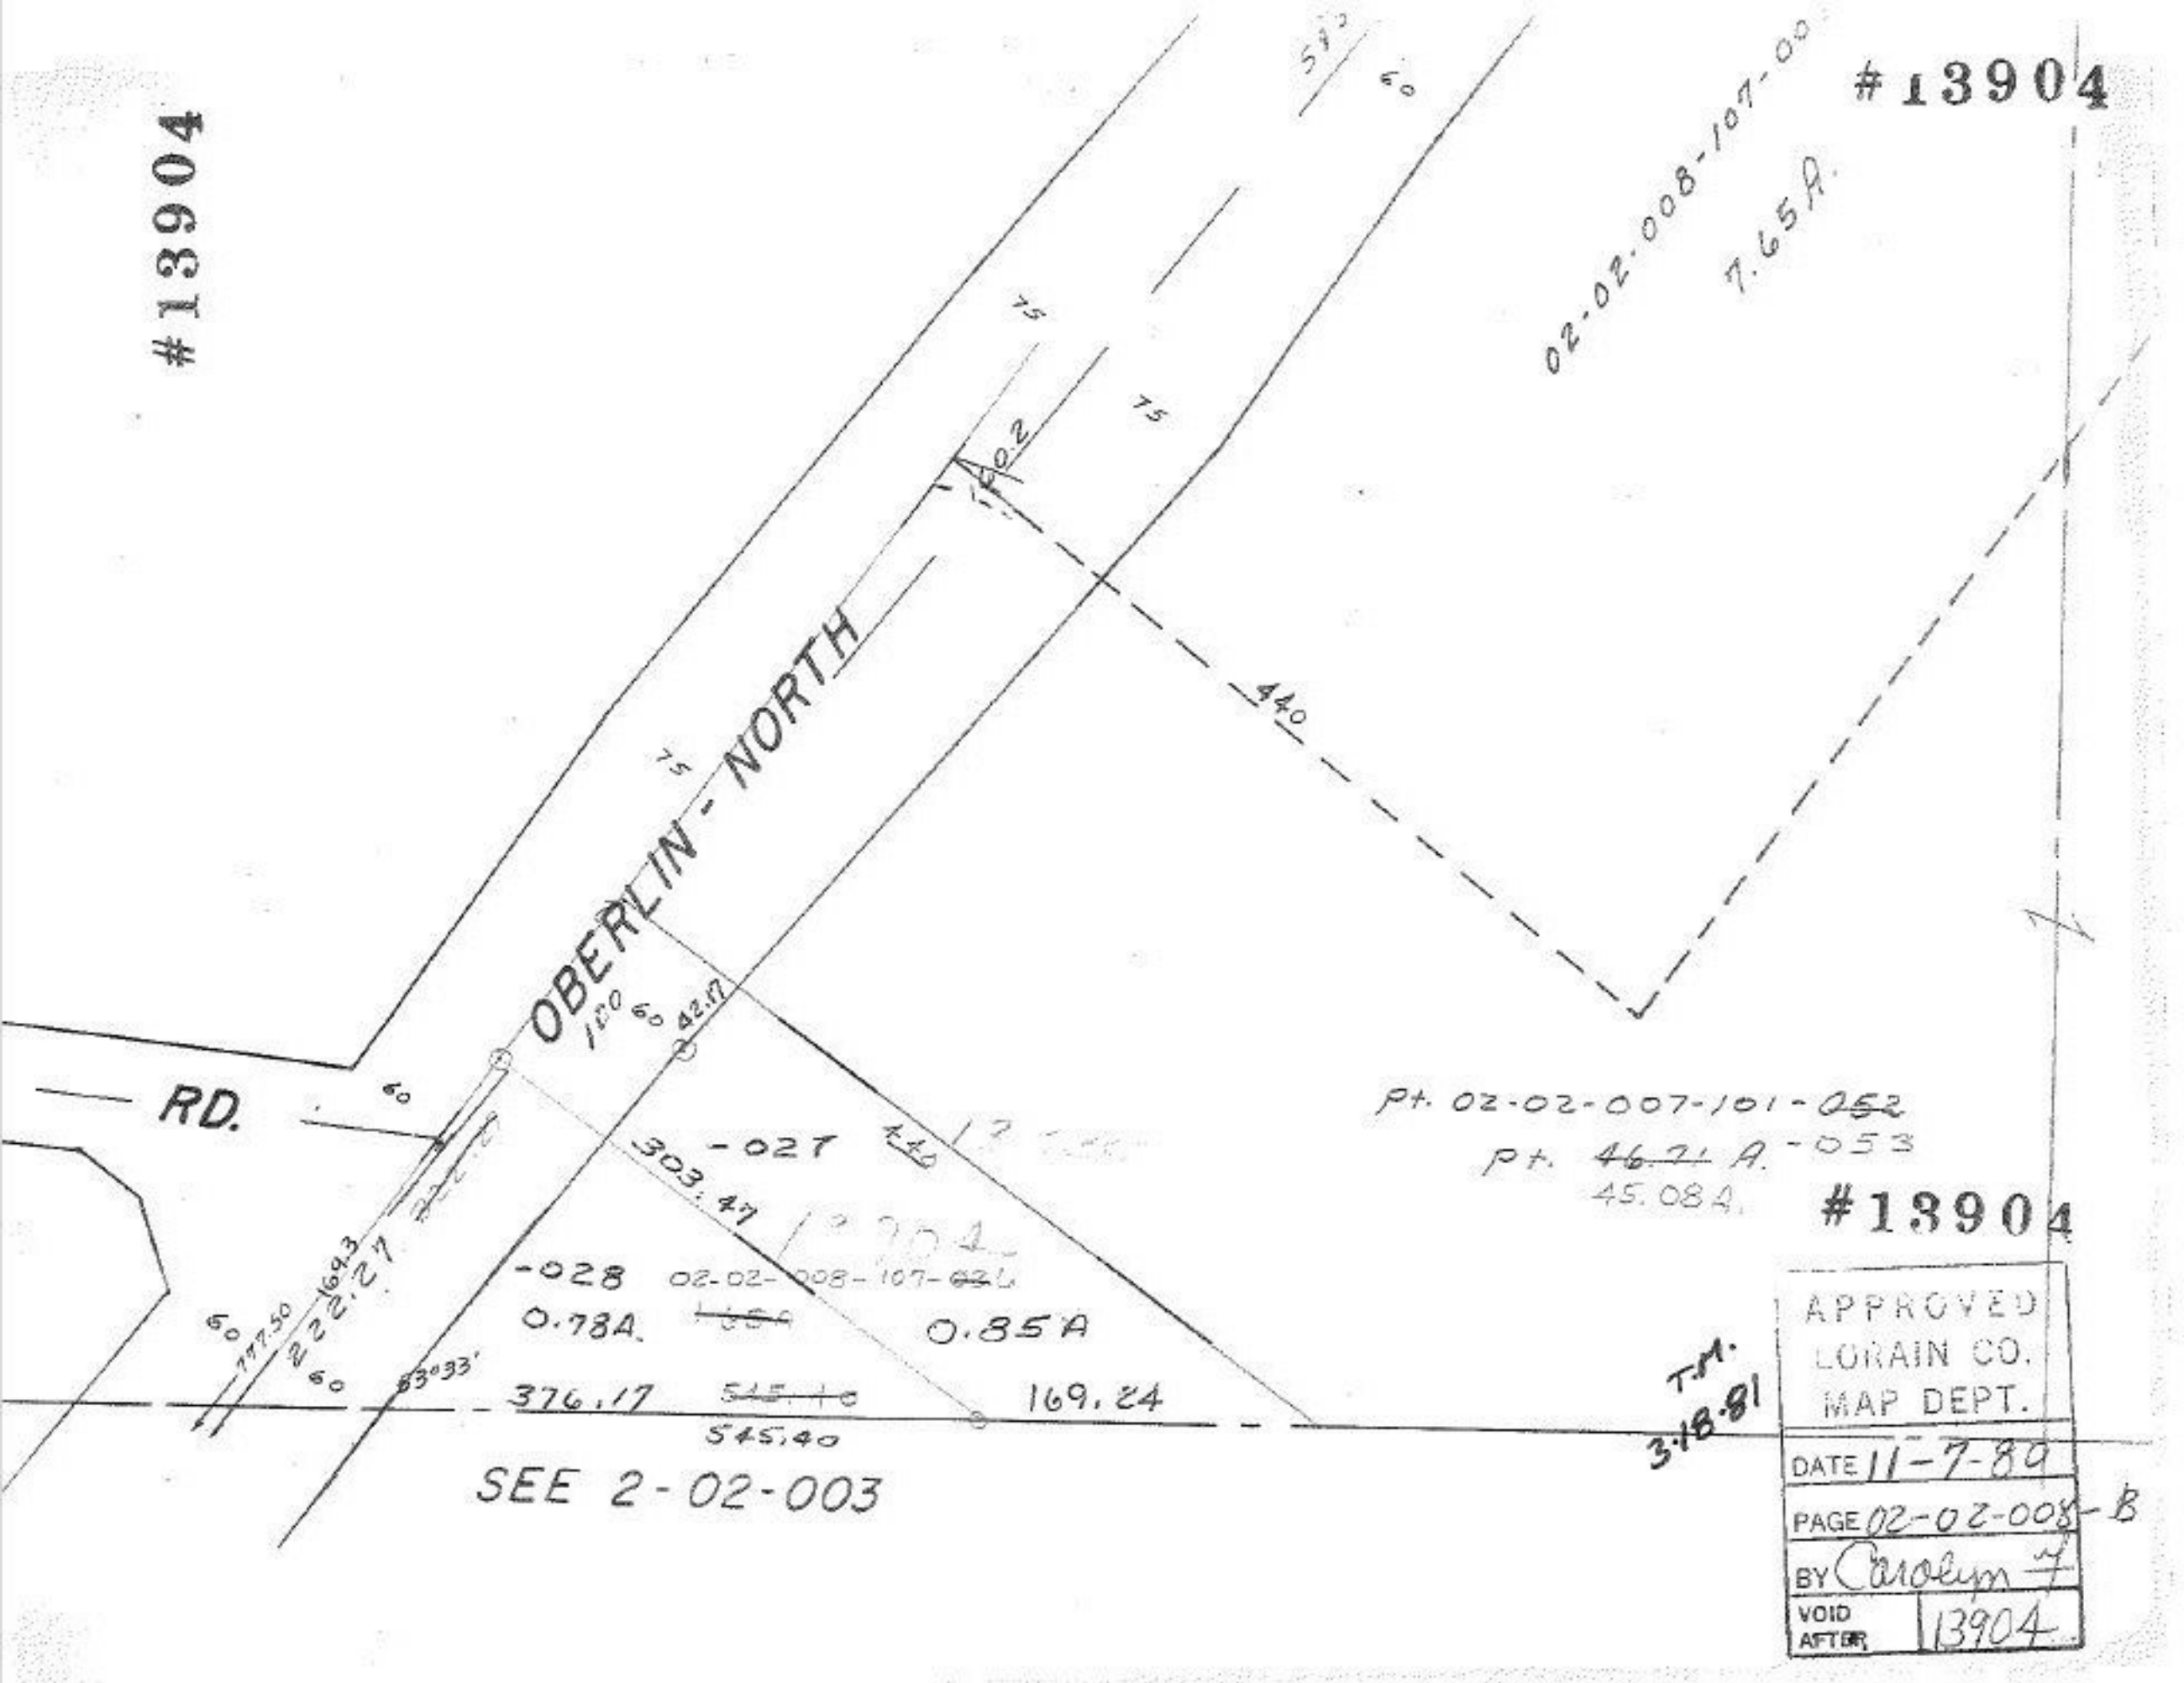
#13904
#13904
#13904
02-02-008-107-00
7.65A.
OBERLIN - NORTH
RD.
440
75
60
42.17
-027
303.47
-028
02-02-008-107-
0.78A.
0.85A
376.17
545.40
169.24
222.27
169.3
777.50
83°33'
SEE 2-02-003
Pt. 02-02-007-101-052
Pt. 46.71 A. -053
45.08A.
T.M.
3-18-81
APPROVED
LORAIN CO.
MAP DEPT.
DATE 11-7-89
PAGE 02-02-008-B
BY Carolyn F
VOID AFTER 13904