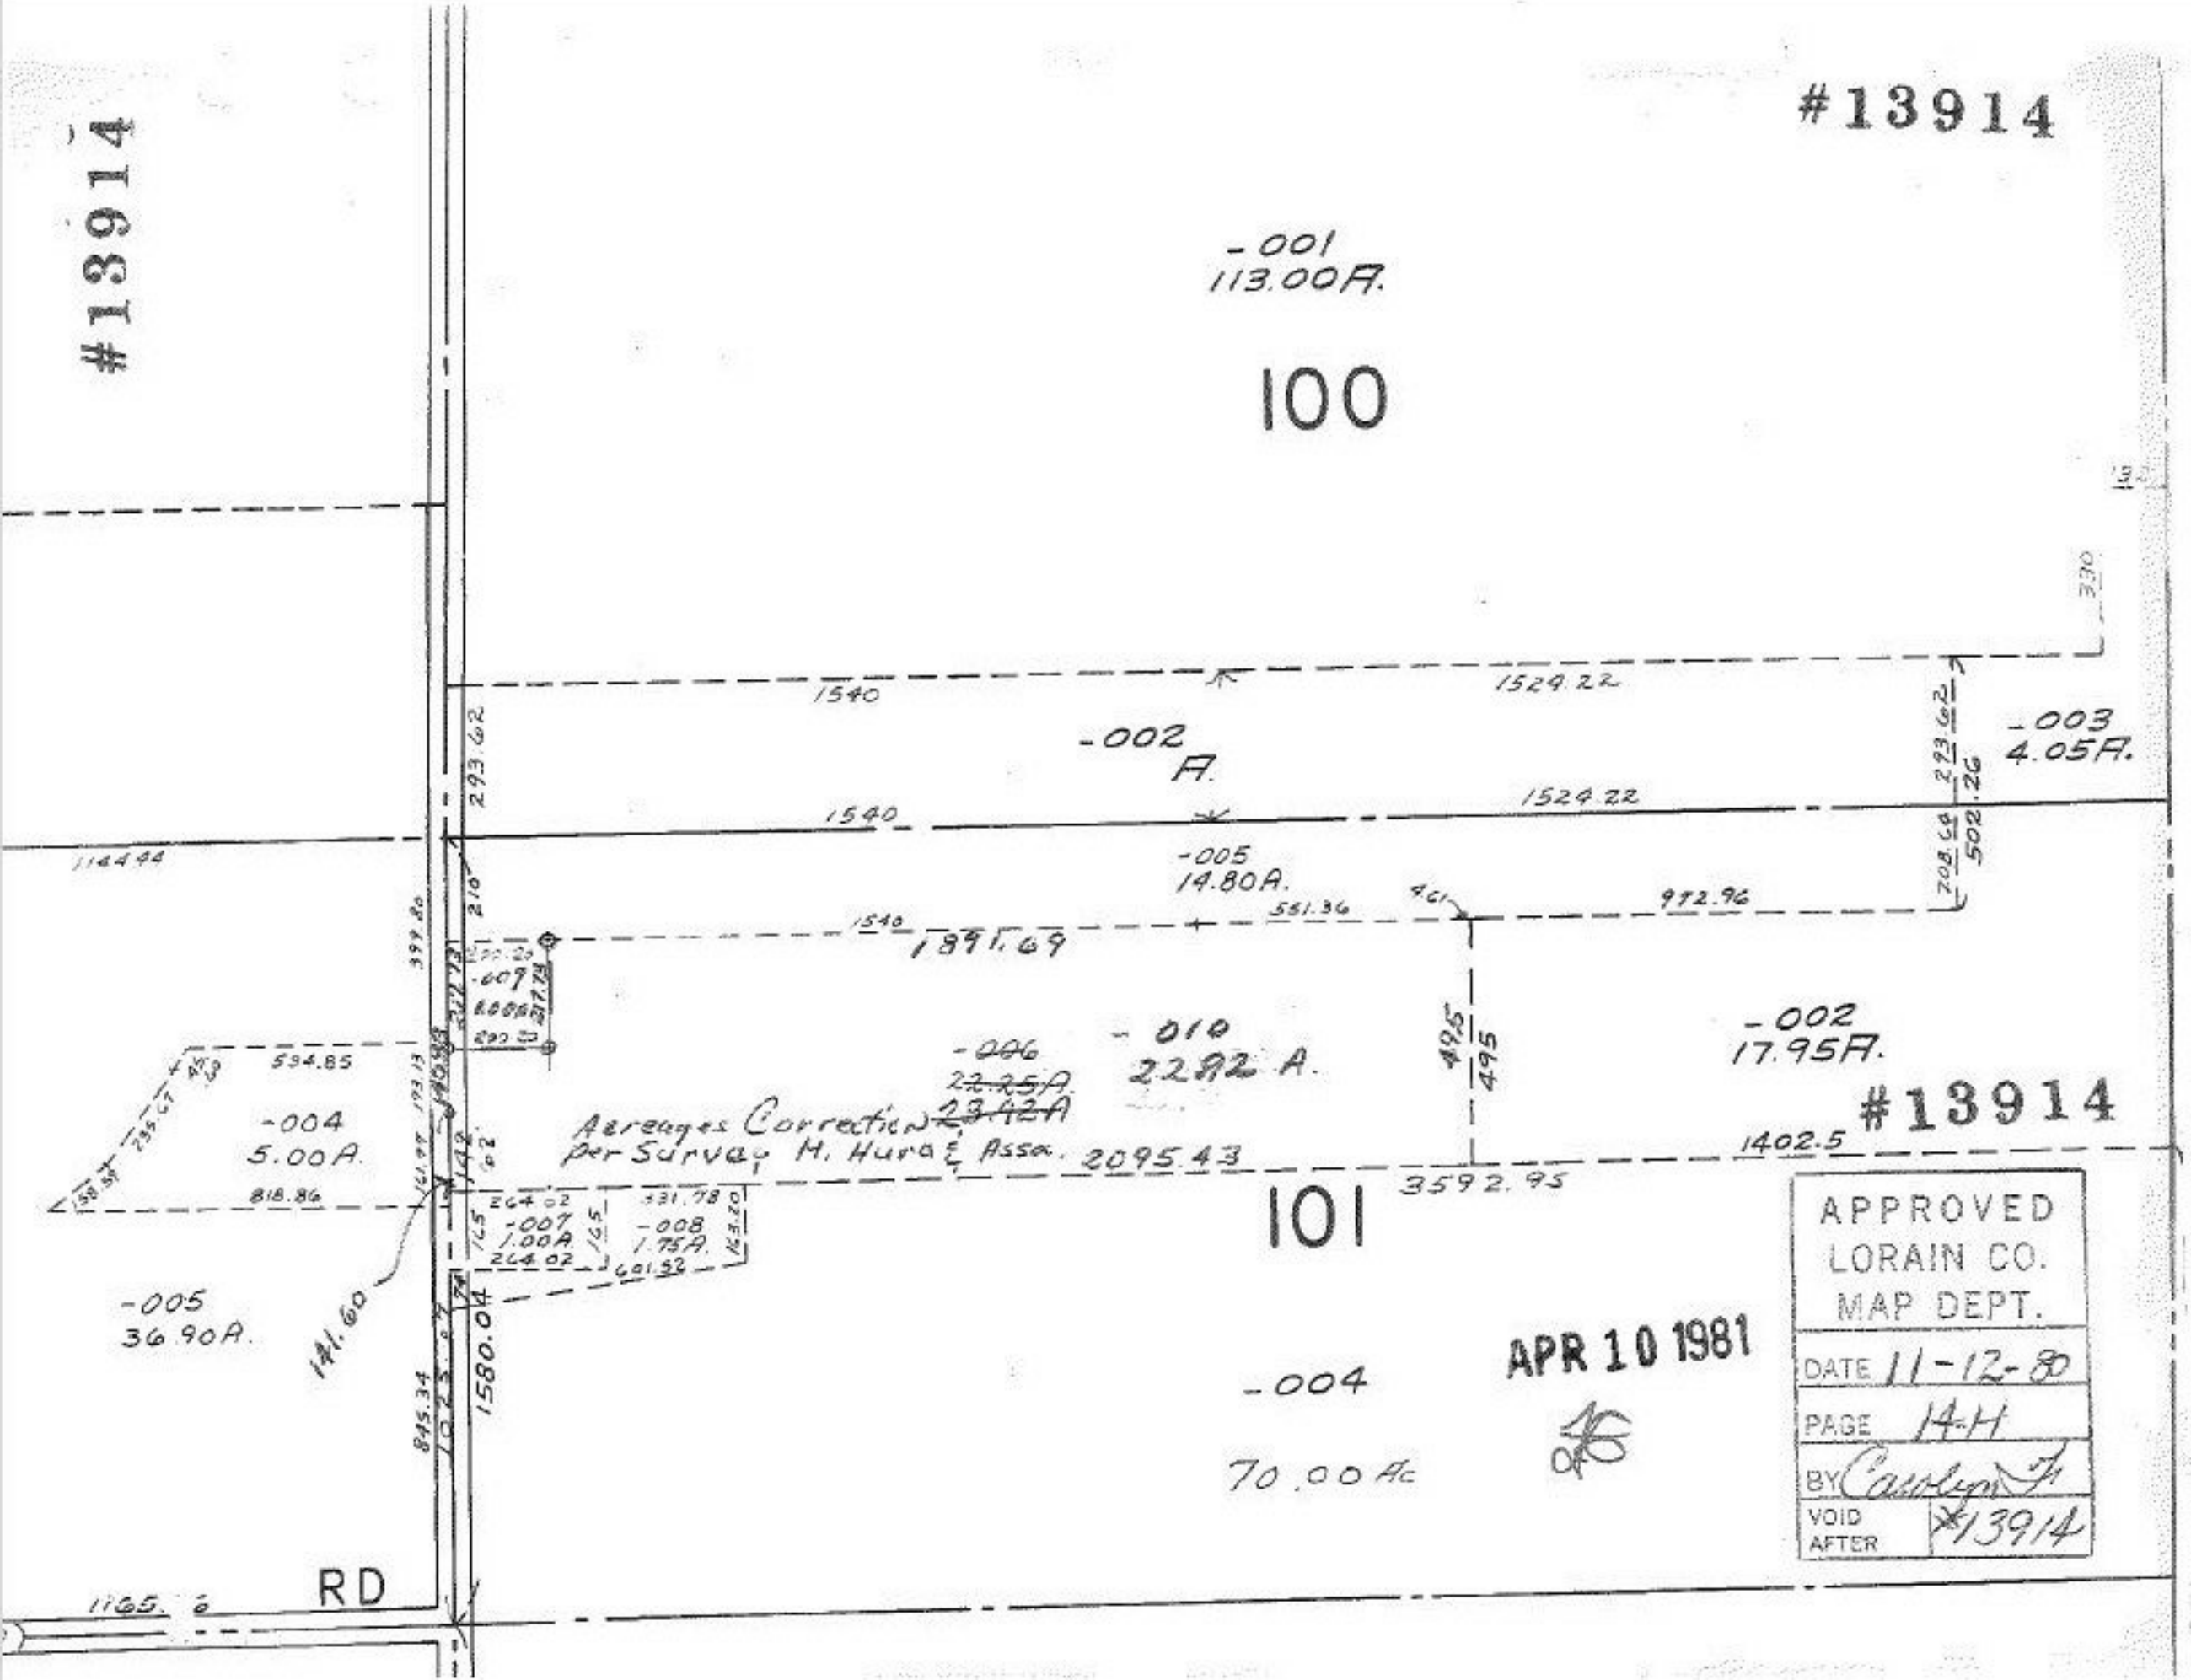
#13914
#13914
-001
113.00A.
100
1540
1524.22
-002
A.
-003
4.05A.
293.62
502.26
1540
1524.22
1144.44
-005
14.80A.
551.36
972.96
1540
1891.69
-007
-010
22.92 A.
495
495
-002
17.95A.
594.85
-004
5.00A.
Acreages Correction
per Survey M. Hura & Assoc.
2095.43
1402.5
#13914
818.86
3592.95
101
264.02
-007
1.00A.
264.02
331.78
-008
1.75A.
601.52
-005
36.90A.
141.60
1580.04
845.34
-004
70.00 Ac
APR 10 1981
RD
1165.6
APPROVED
LORAIN CO.
MAP DEPT.
DATE 11-12-80
PAGE 14-H
BY Carolyn F.
VOID AFTER #13914