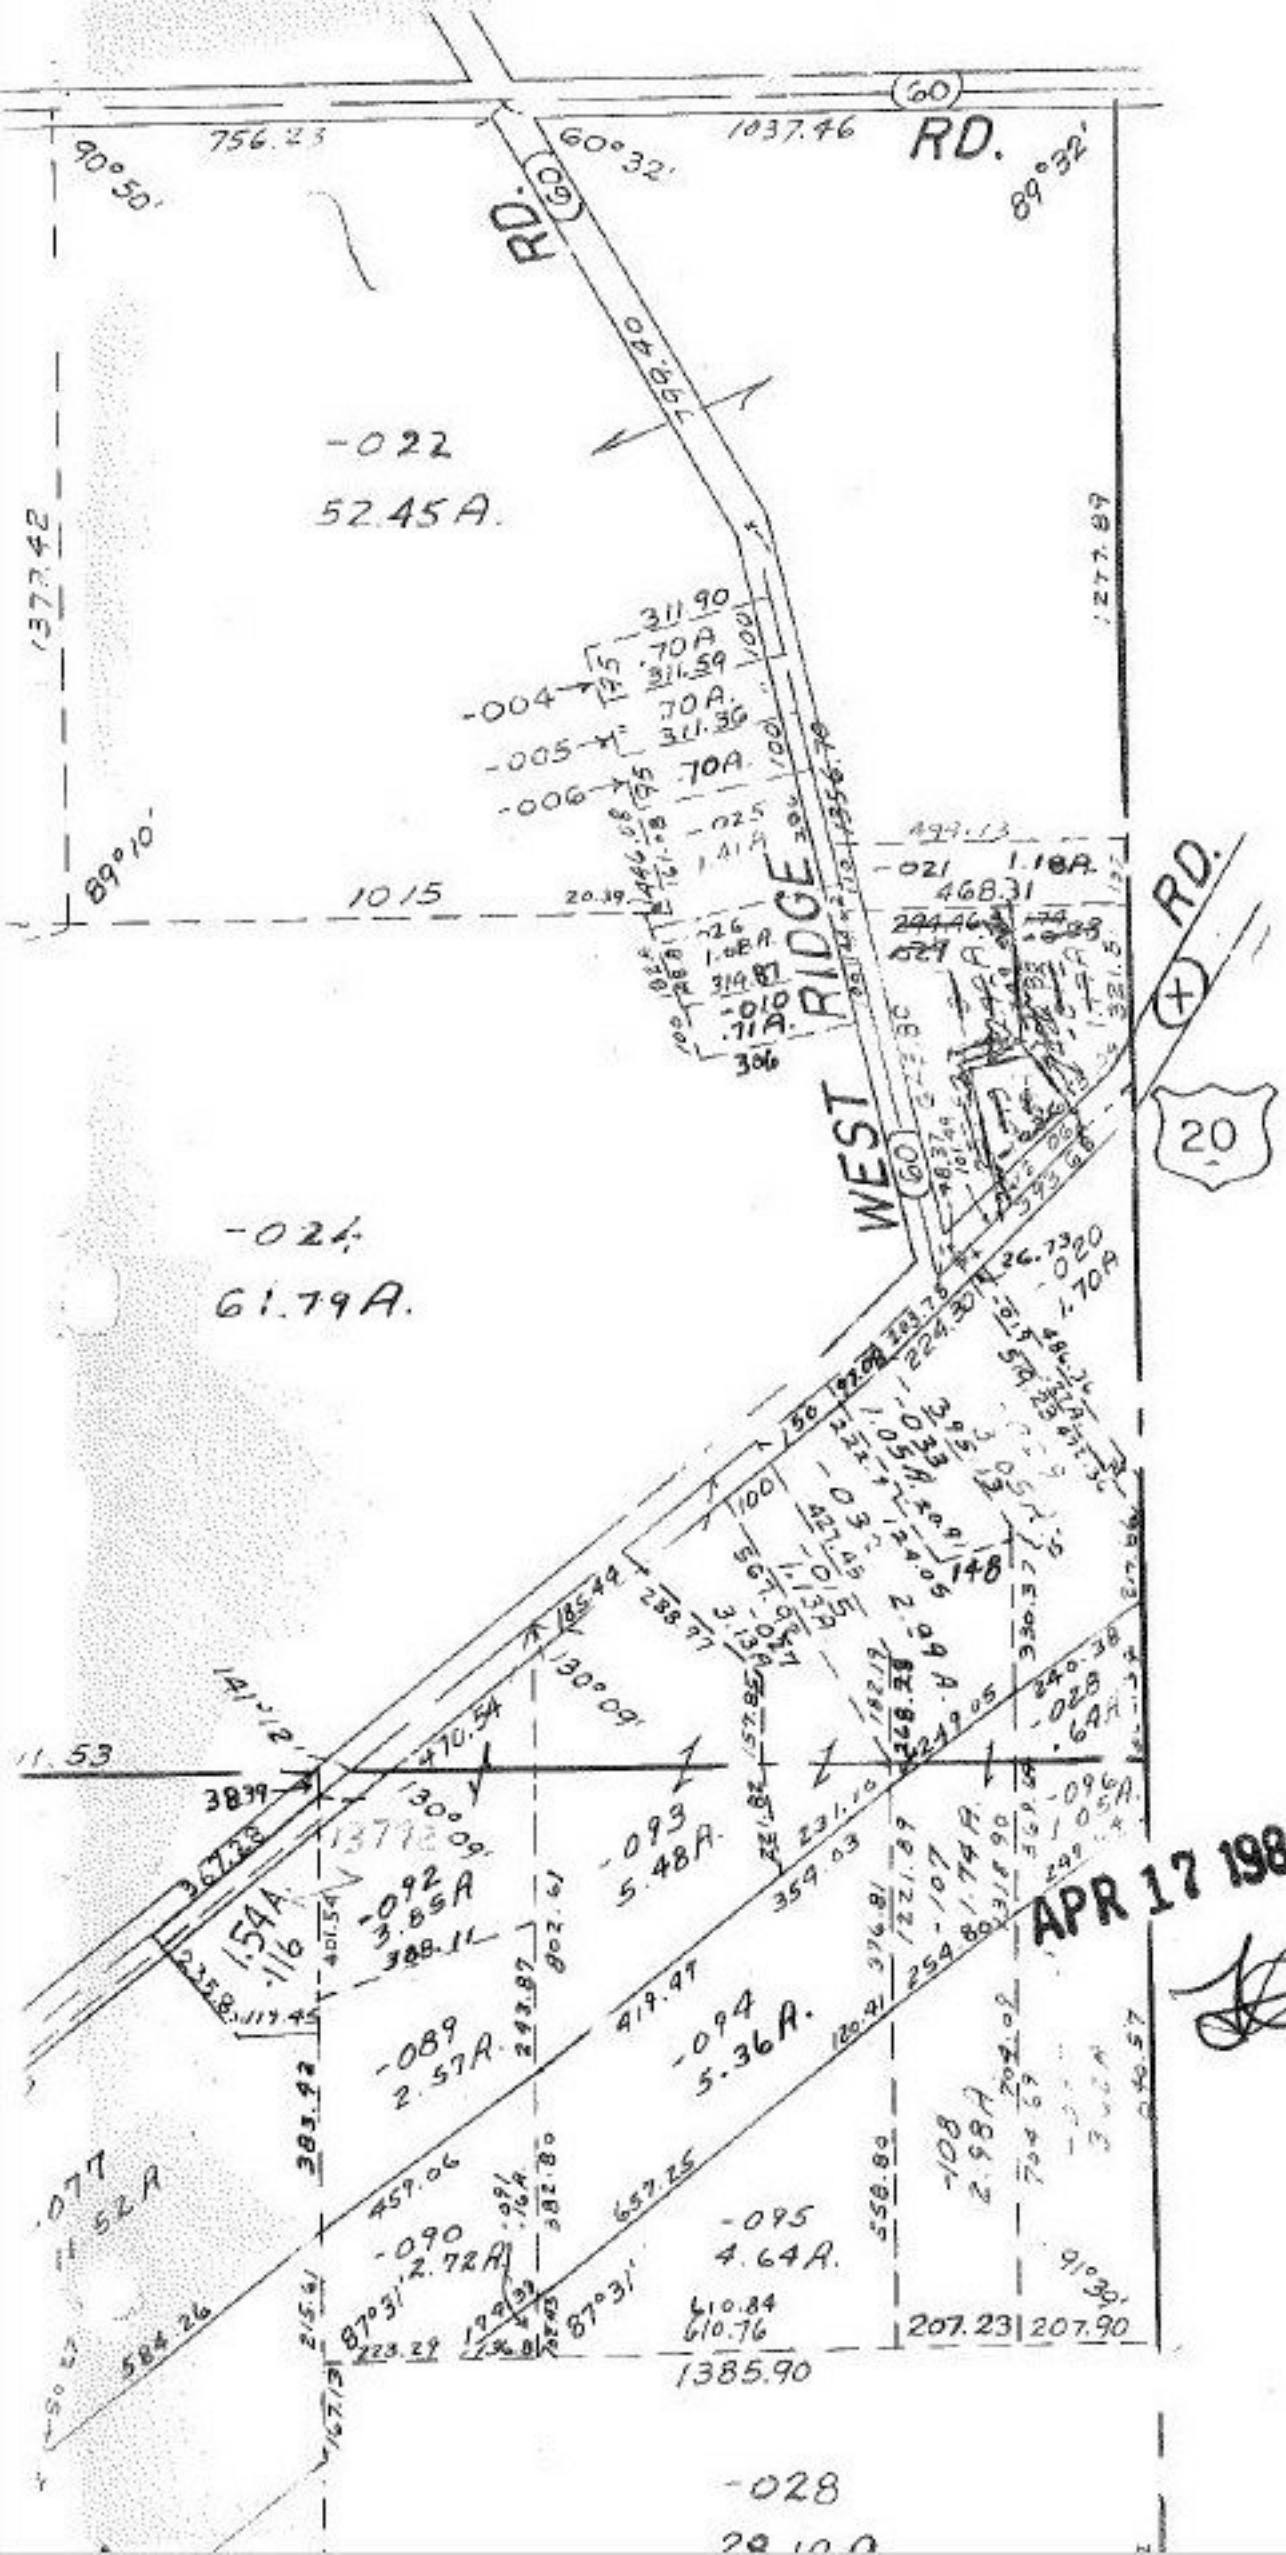

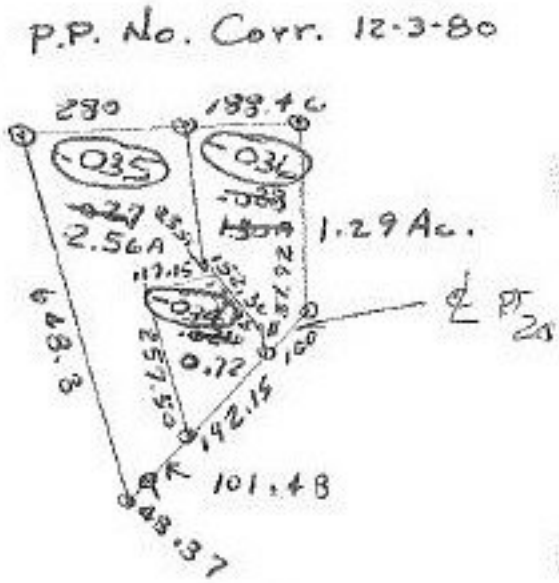

#13919

#13919

APR 17 1981

APPROVED
LORAIN CO.
MAP DEPT.

DATE	11-17-80
PAGE	10-E
BY	Carolyn
VOID AFTER	13919

2.72	0.22
1.71	2.56
0.69	1.30
5.12	4.58