#13921

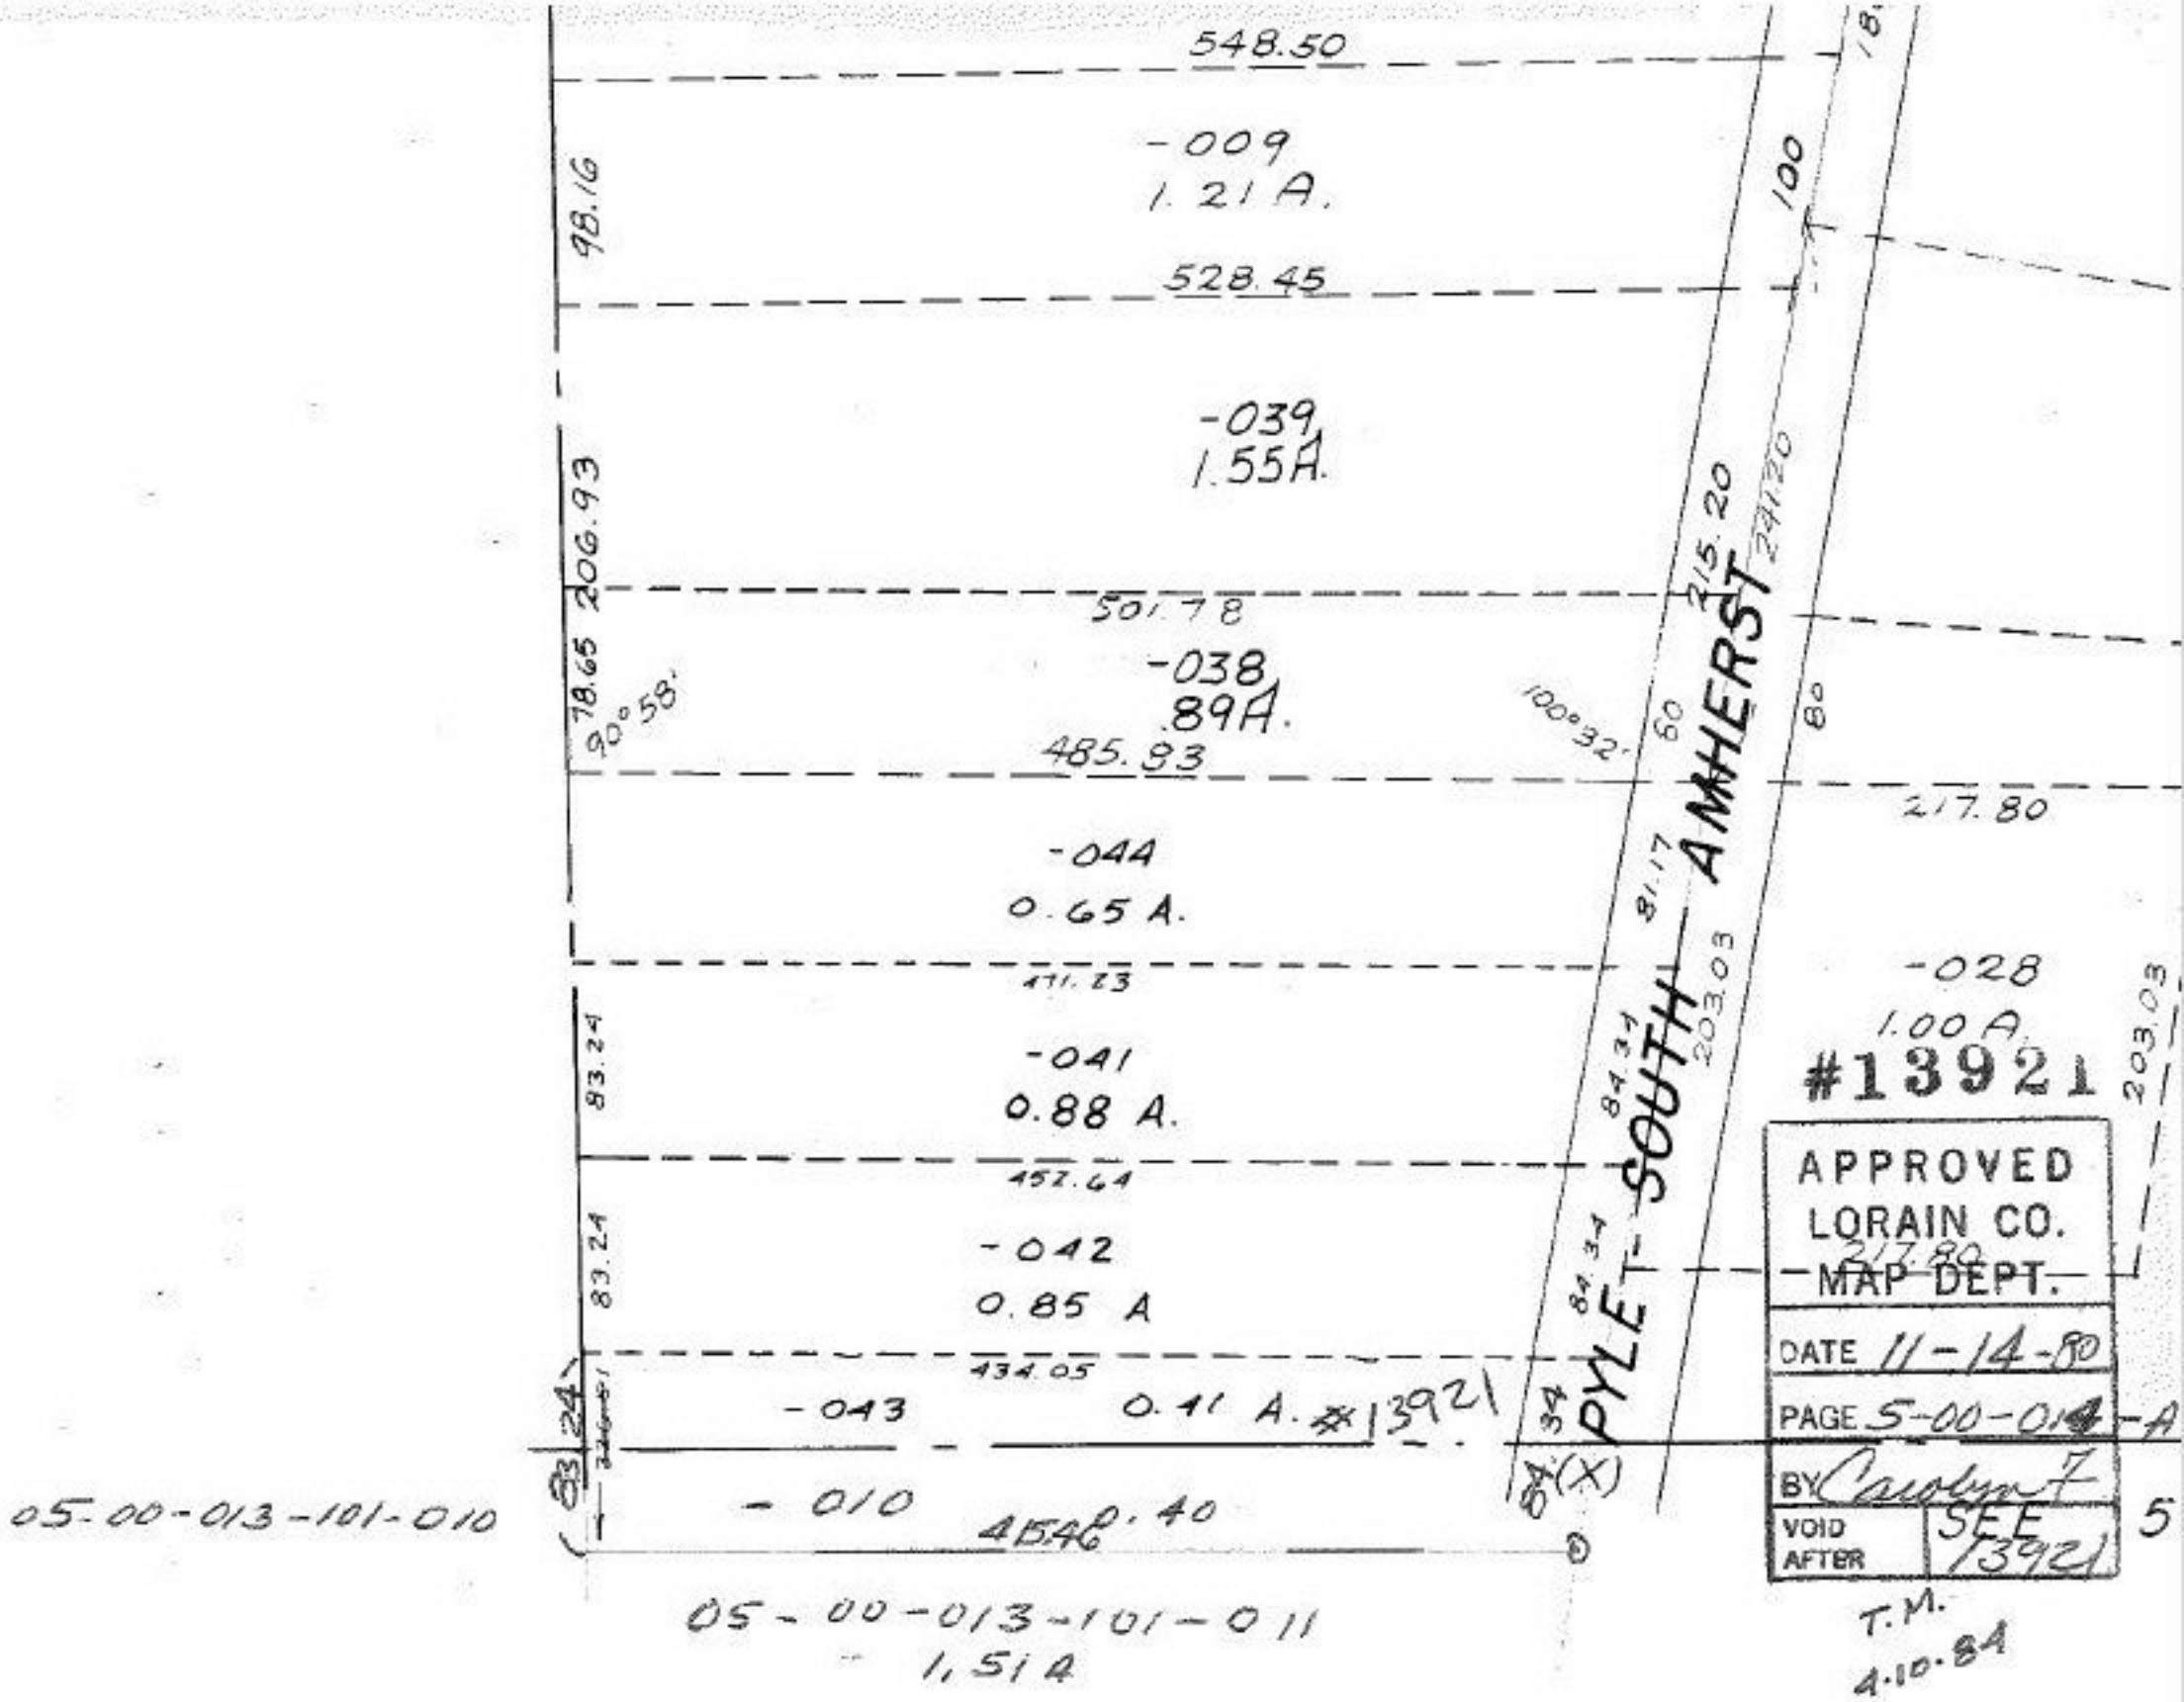

#13921

APPROVED
LORAIN CO.
MAP DEPT.
DATE 11-14-80
PAGE 5-00-014-A
BY Carolyn F
VOID AFTER SEE 13921

5

right 1963
.25.80

-00-014-A

AMHERST TWP.

SCALE: 1" = 100'