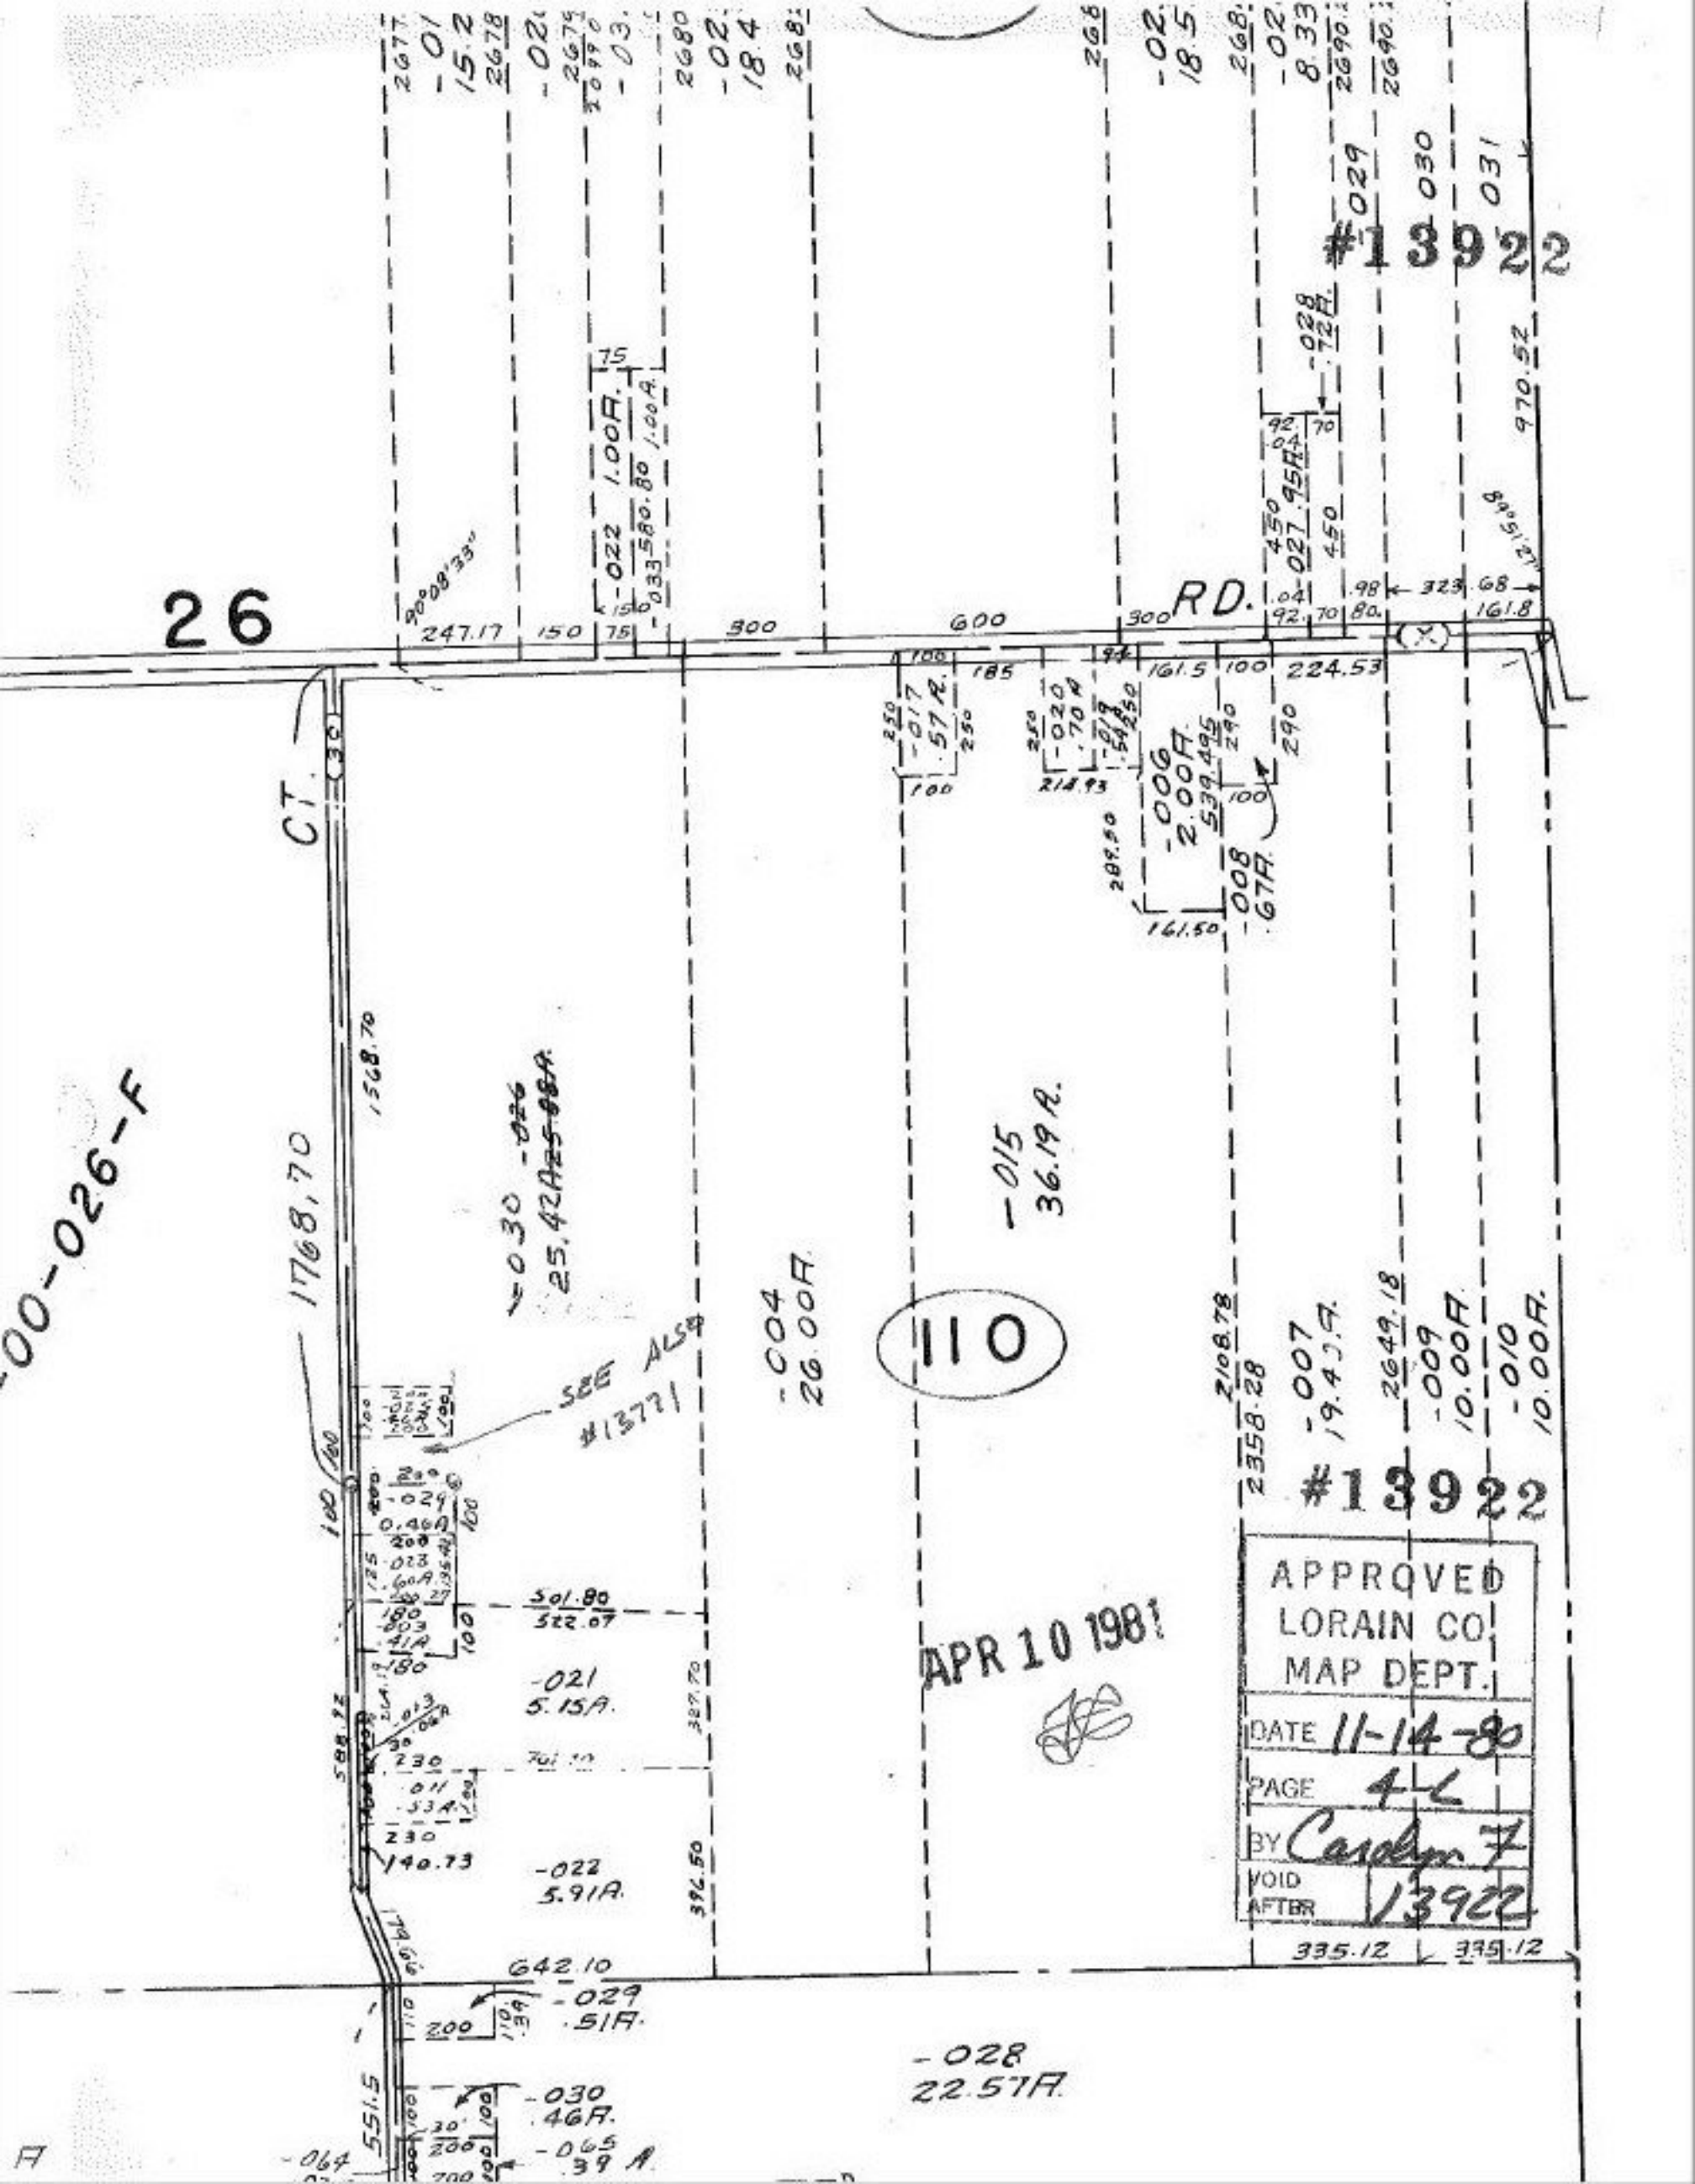

26
RD.
CT.
110
#13922
#13922
APPROVED
LORAIN CO.
MAP DEPT.
DATE 11-14-80
PAGE 4-L
BY Carolyn F
VOID AFTER 13922
APR 10 1981
SEE ALSO #13771
-00-026-F
1768.70
-015 36.19A.
-004 26.00A.
-028 22.57A.
-021 5.15A.
-022 5.91A.
-029 .51A.
-030 .46A.
-065 .39 A.
-006 2.00A.
-008 .67A.
-007 19.43A.
-009 10.00A.
-010 10.00A.
-022 1.00A.
-027 .95A.
-028 .72A.
-030 25.42A.
-017 .57A.
-020 .70A.
-029 0.46A.
-023 .60A.
-011 .53A.
-064