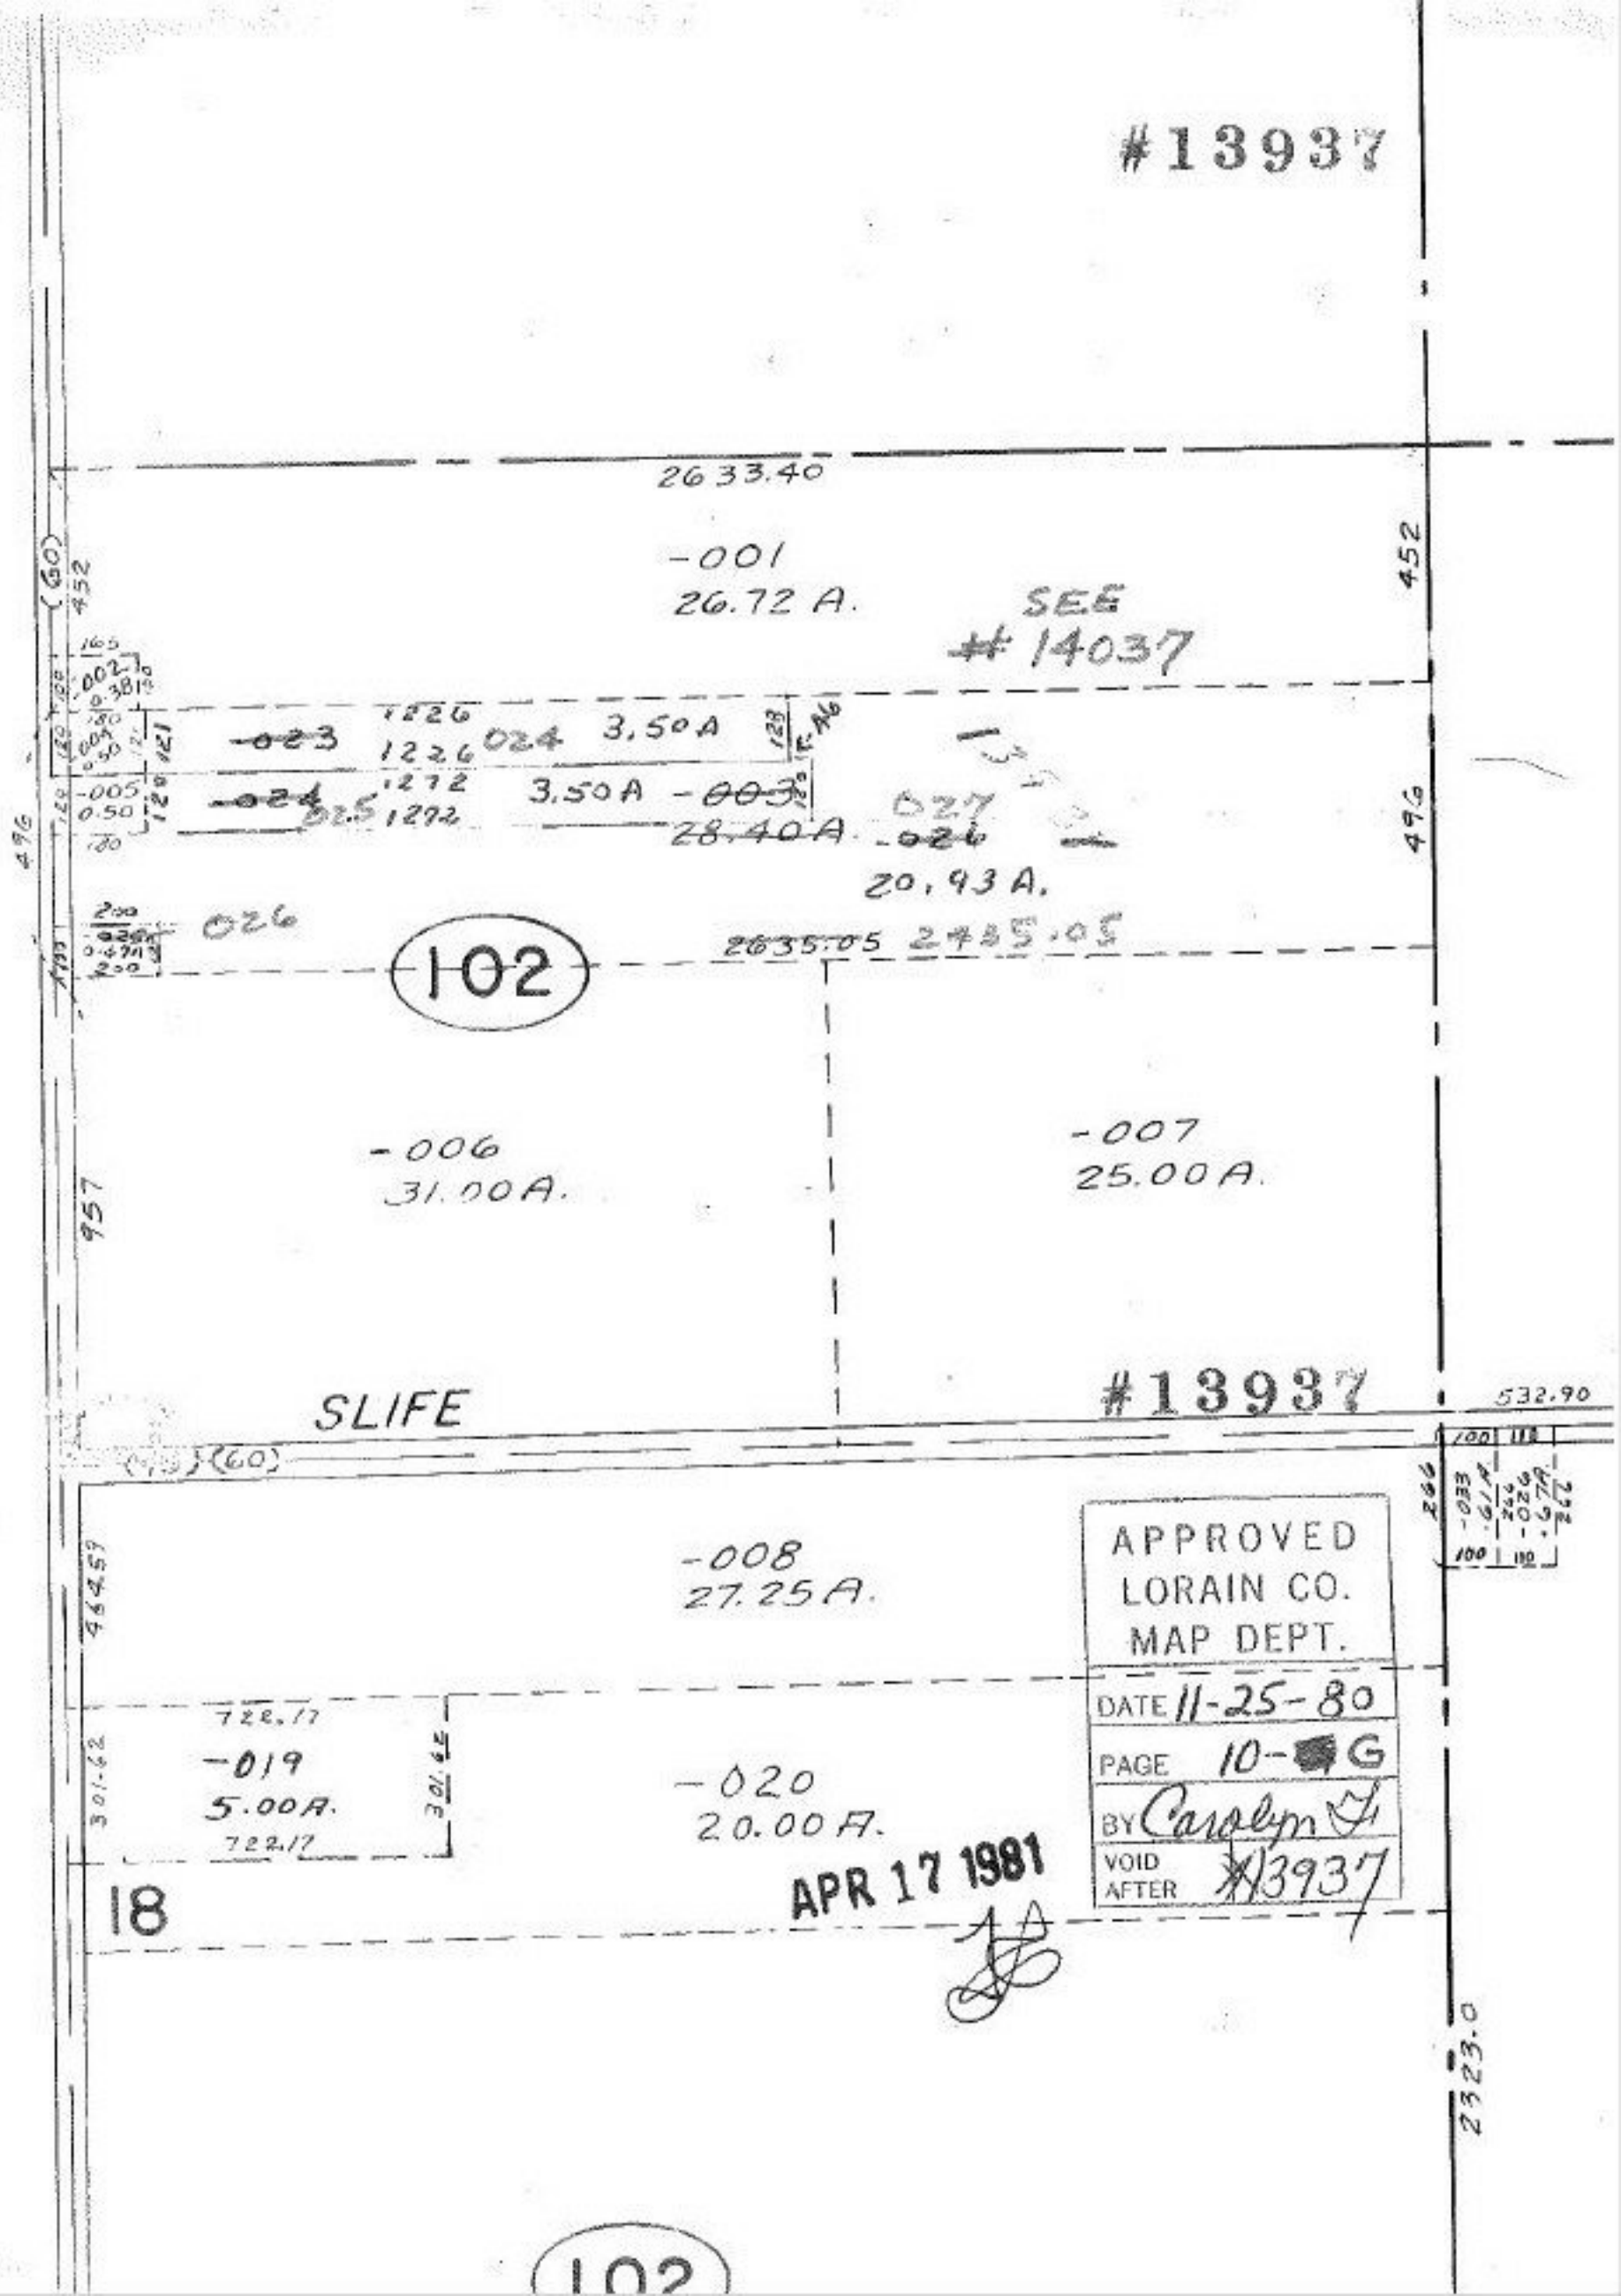
#13937
2633.40
-001
26.72 A.
SEE
#14037
452
496
-023
1226
1226
024
3.50A
-024
1272
1272
3.50A
-003
28.40A
027
-026
20.93 A.
026
2635.05
2435.05
102
-006
31.00A.
-007
25.00A.
957
SLIFE
#13937
532.90
(60)
-008
27.25A.
APPROVED
LORAIN CO.
MAP DEPT.
DATE 11-25-80
PAGE 10-G
BY Carolyn
VOID AFTER #13937
722.17
-019
5.00A.
722.17
301.62
-020
20.00A.
APR 17 1981
18
2323.0
102