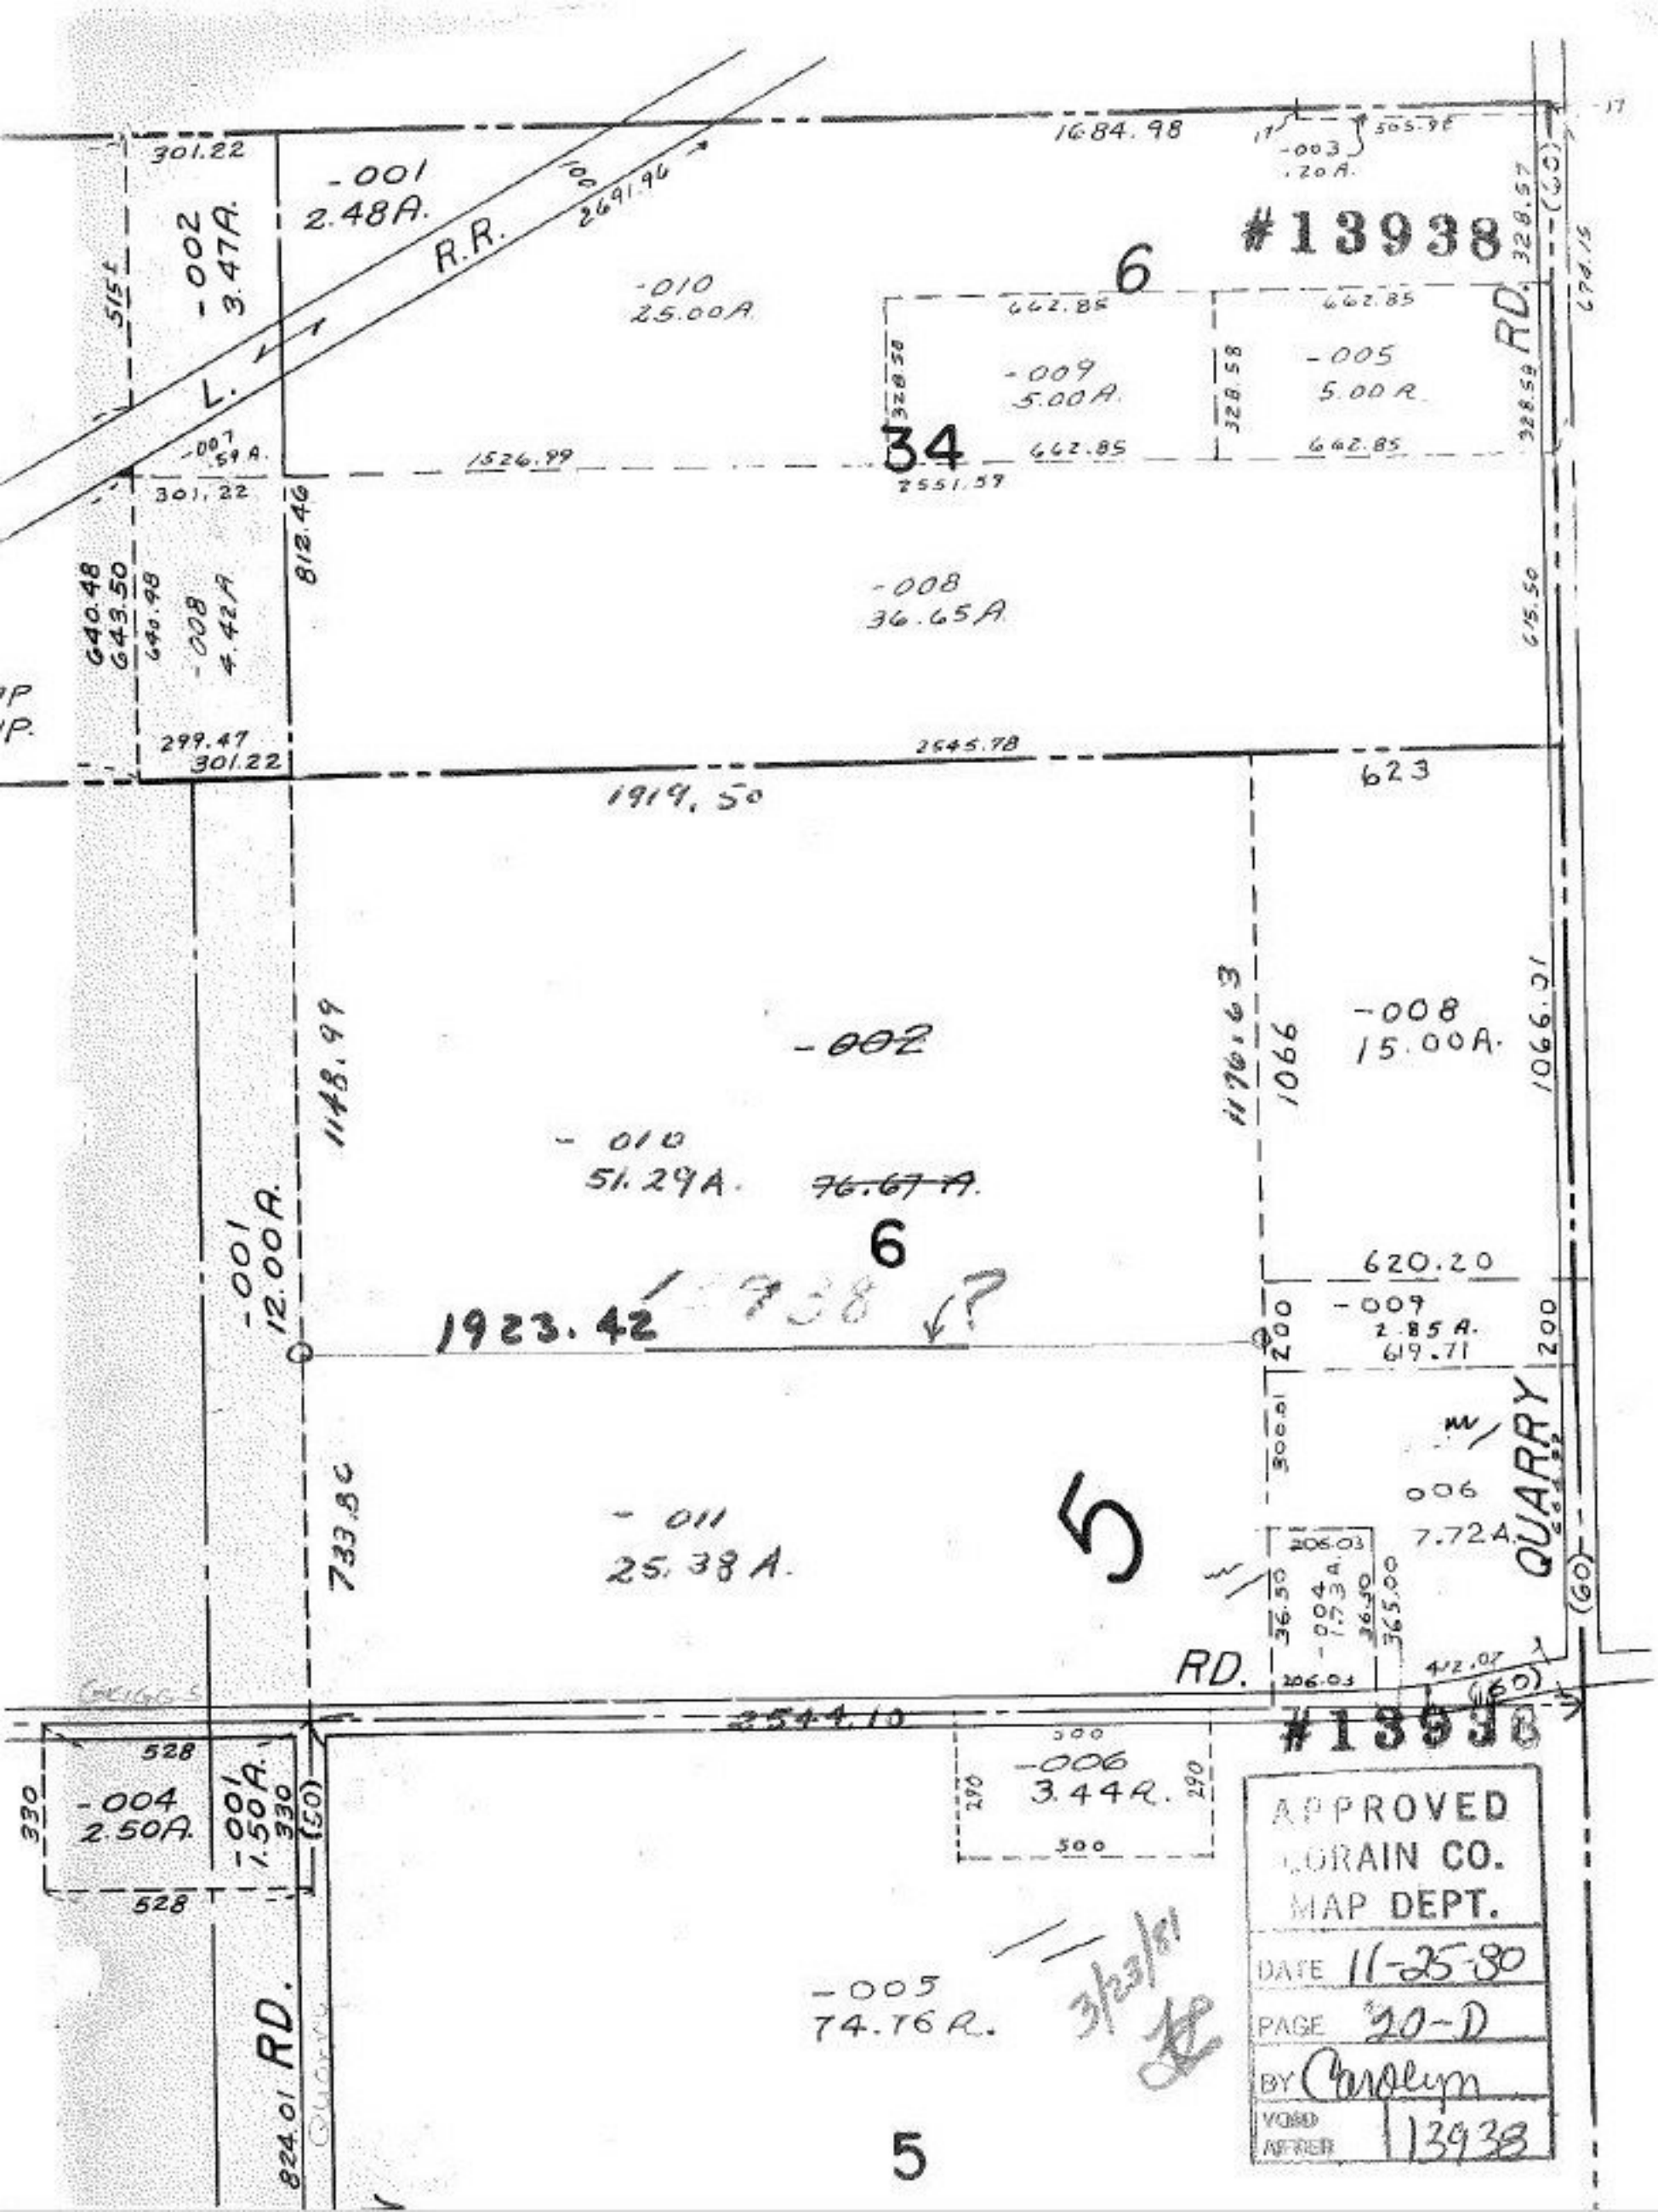

#13938
6
34
5
L. R.R.
RD.
QUARRY
-001 2.48A.
-002 3.47A.
-010 25.00A.
-009 5.00A.
-005 5.00A.
-008 36.65A.
-008 4.42A.
-007 .59A.
-003 .20A.
-002
-010 51.29A.
-001 12.00A.
-011 25.38A.
-008 15.00A.
-009 2.85A.
-006 7.72A.
-004 2.50A.
-001 1.50A.
-006 3.44A.
-005 74.76A.
1684.98
2691.96
1526.99
2551.59
2545.78
1919.50
1148.99
1176.63
1066
1066.01
620.20
619.71
1923.42
733.80
2544.10
824.01
APPROVED
LORAIN CO.
MAP DEPT.
DATE 11-25-80
PAGE 20-D
BY Carolyn
VOID AFTER 13938
3/23/81