ACREAGE CORRECTION

#13949

SEE 12-00-004-A

#13949

APPROVED
LORAIN CO.
MAP DEPT.
DATE 11-28-80
PAGE 12-00-004-B
BY T. McNair
VOID AFTER

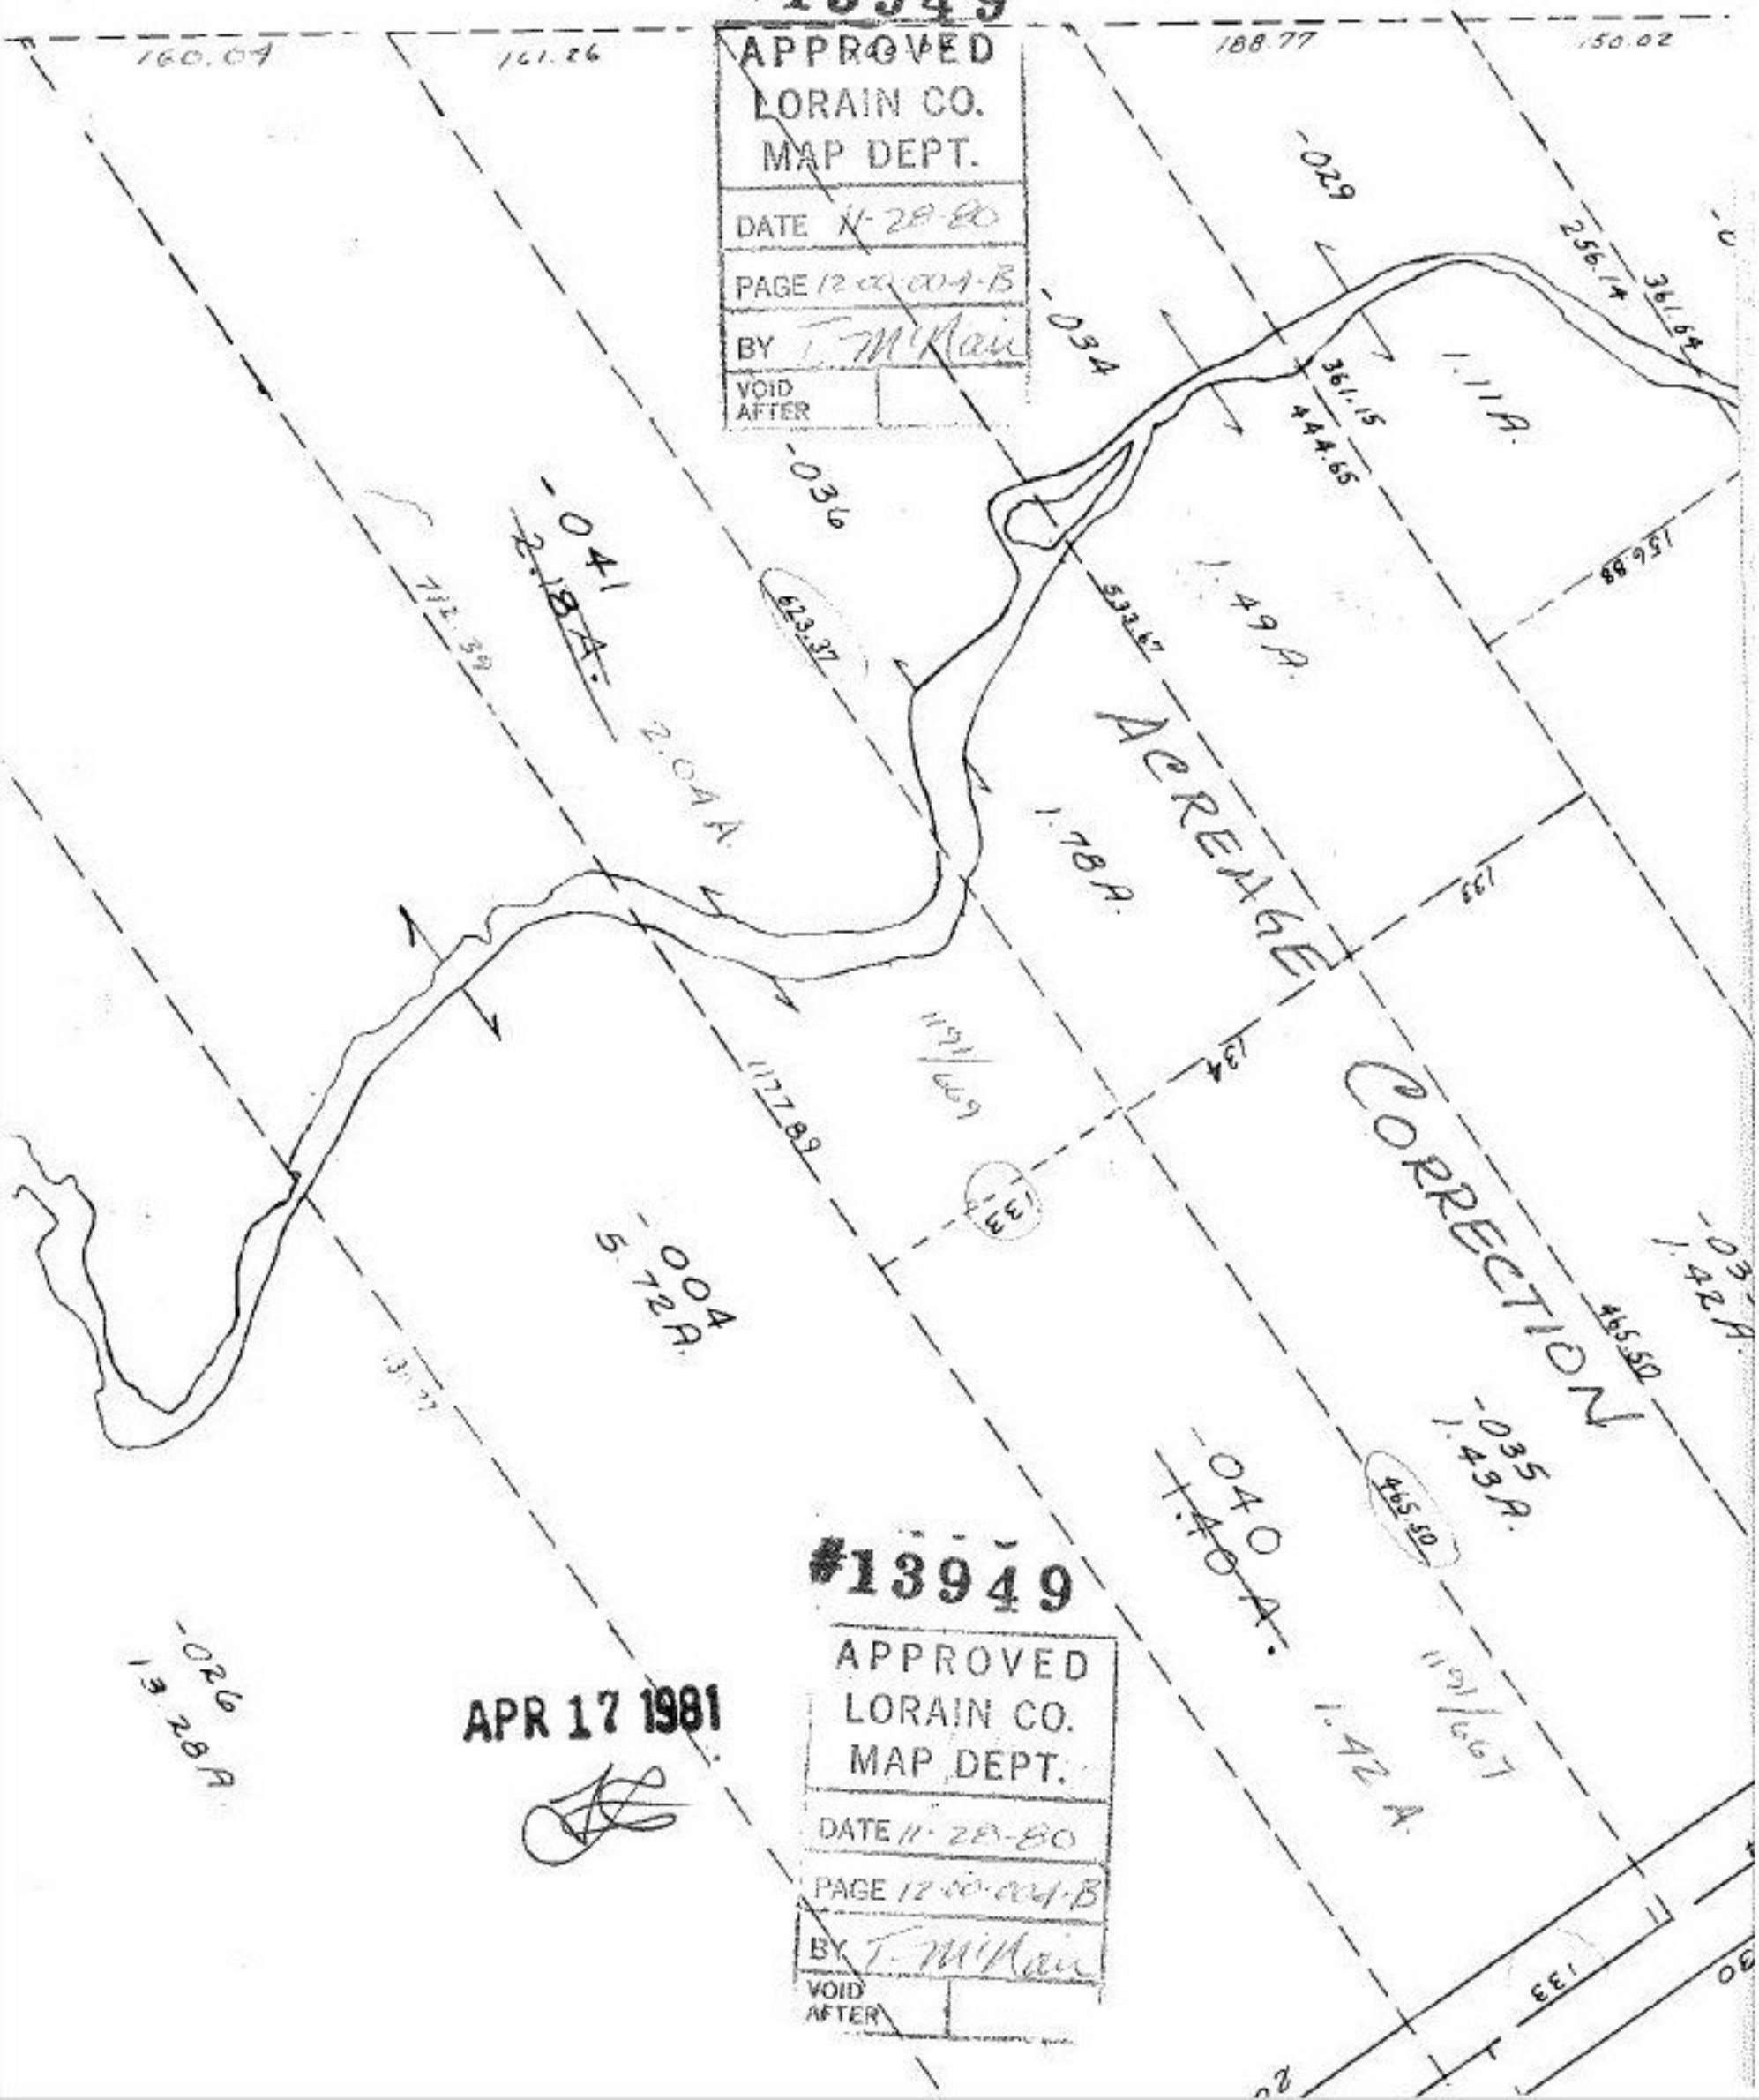

#13949

APPROVED
LORAIN CO.
MAP DEPT.
DATE 11-28-80
PAGE 12-00-004-B
BY T. McNair
VOID AFTER

APR 17 1981