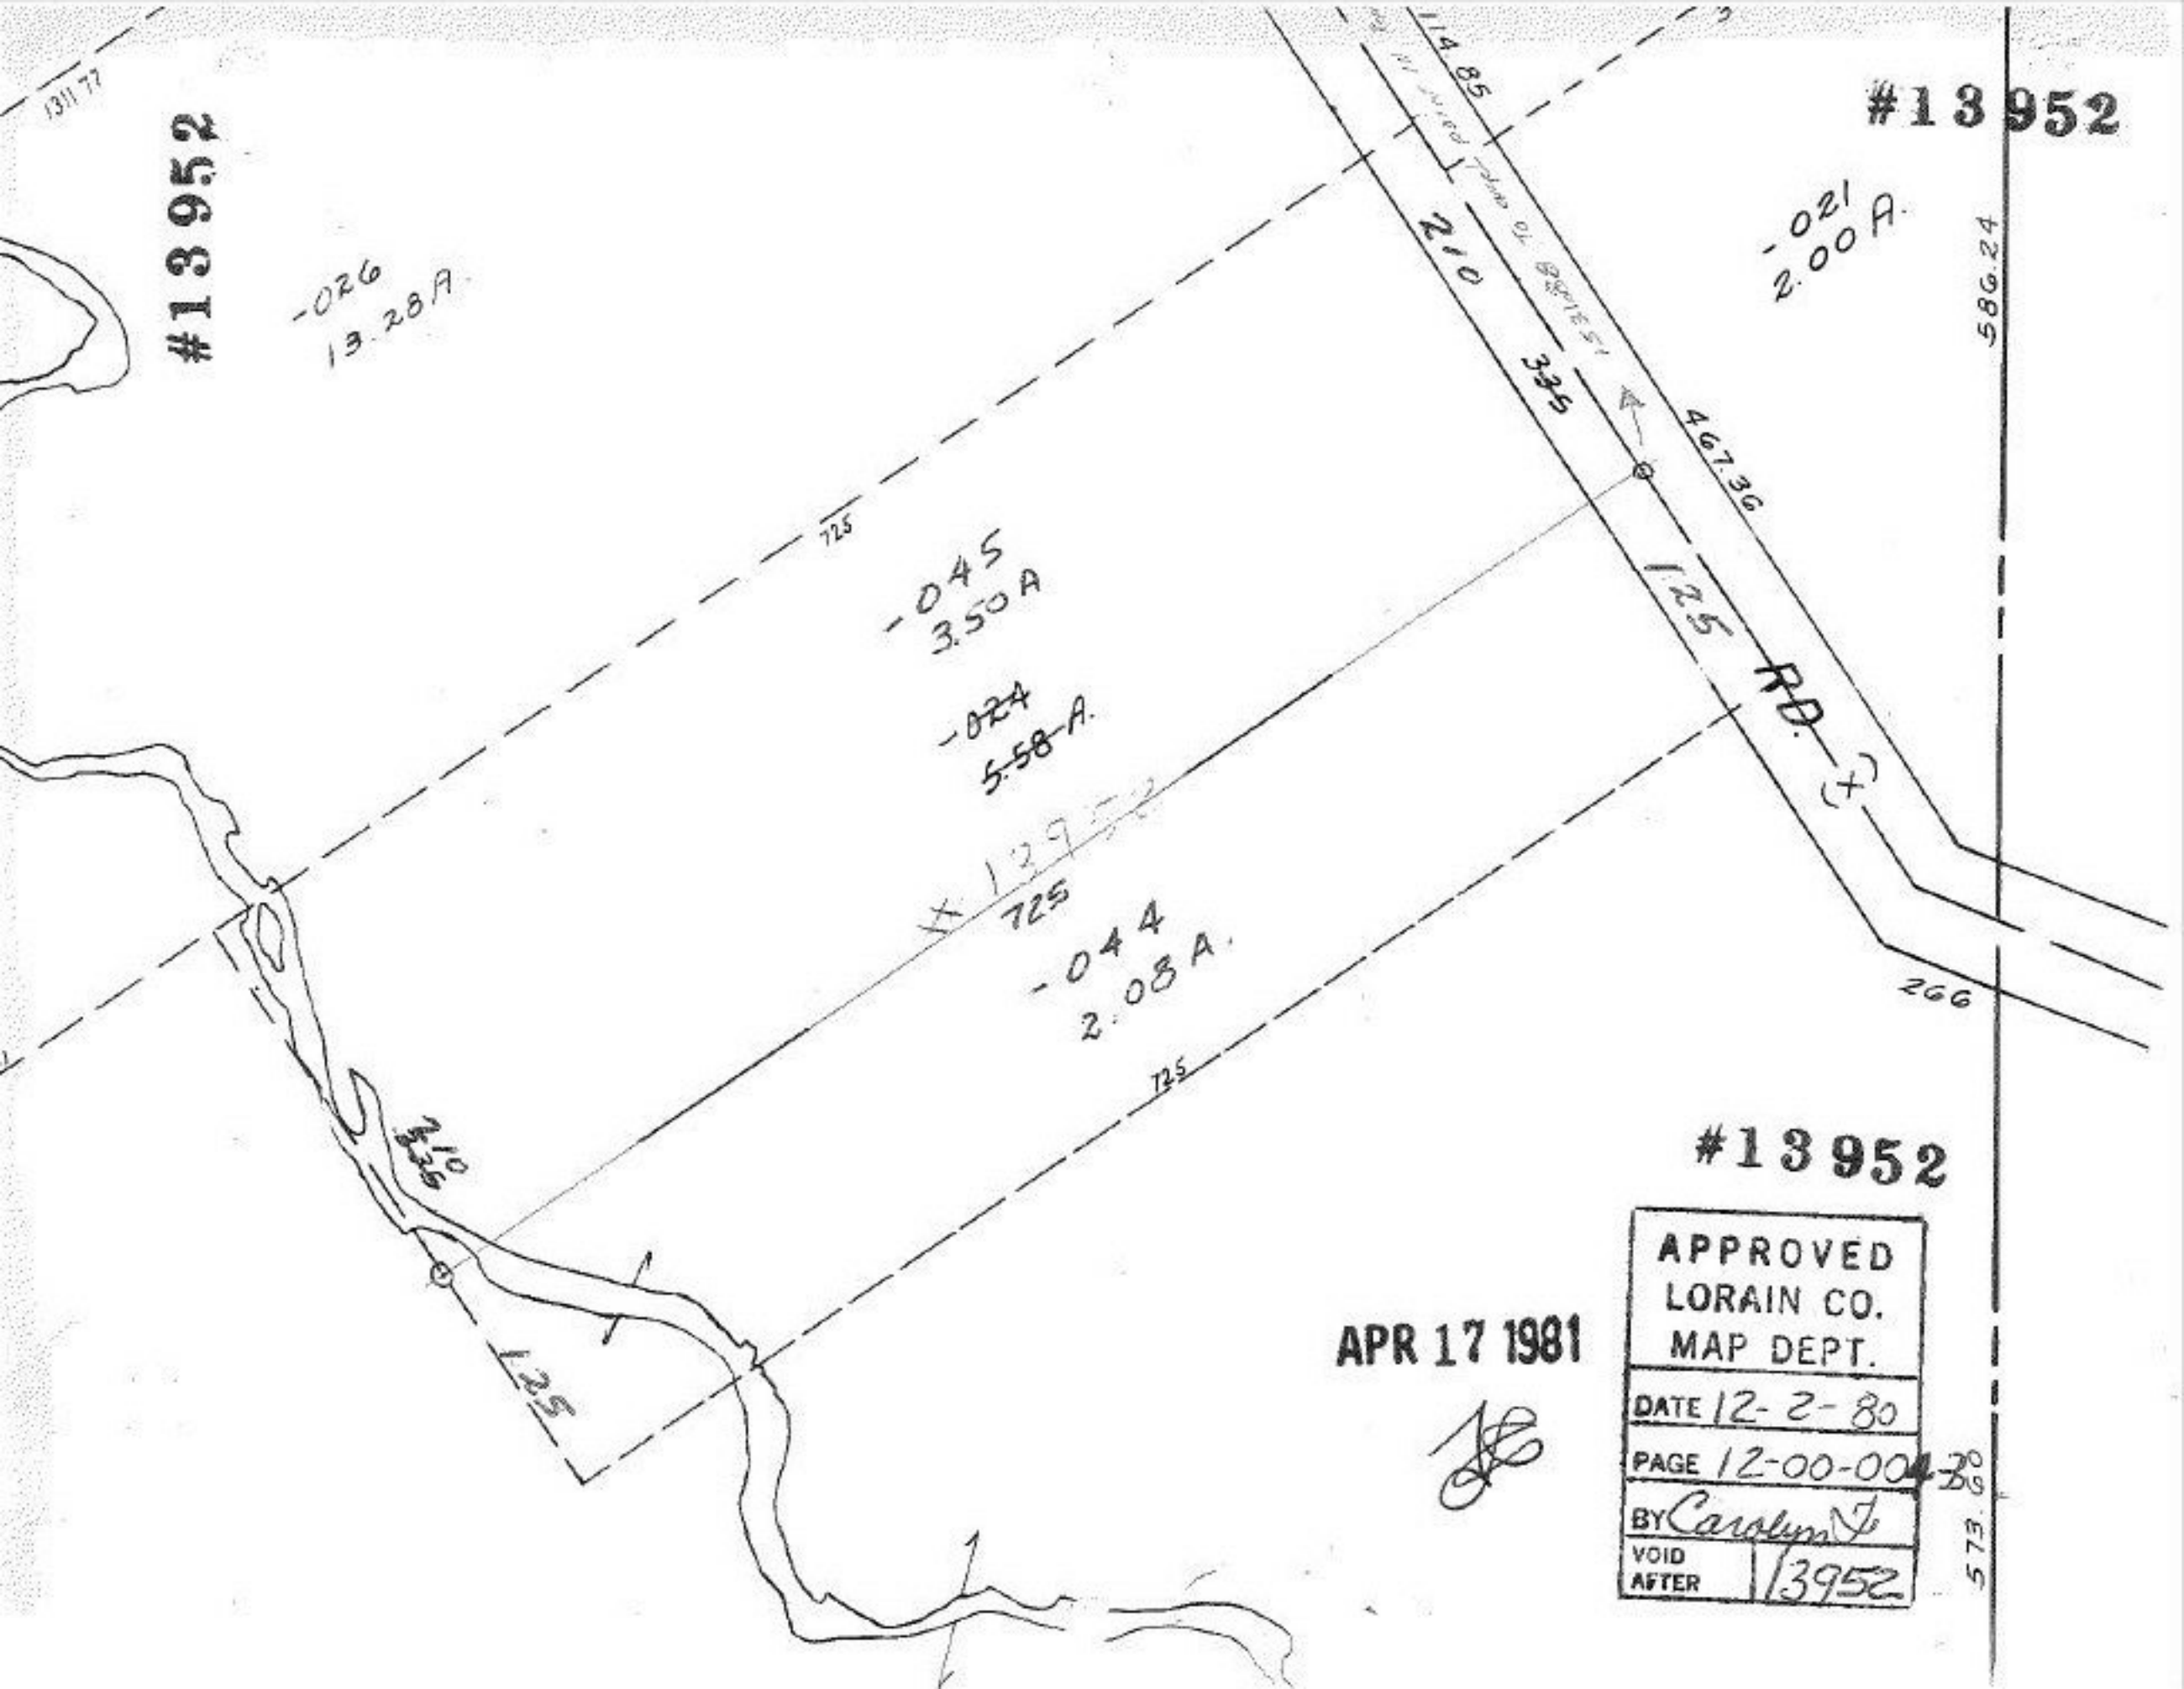
#13952
#13952
#13952
-026
13.28A
-021
2.00A.
586.24
114.85
210
335
467.36
125
RD.
-045
3.50A
-024
5.58A.
725
-044
2.08A.
266
125
APR 17 1981
APPROVED
LORAIN CO.
MAP DEPT.
DATE 12-2-80
PAGE 12-00-004-30
BY Carolyn
VOID AFTER 13952
573.60