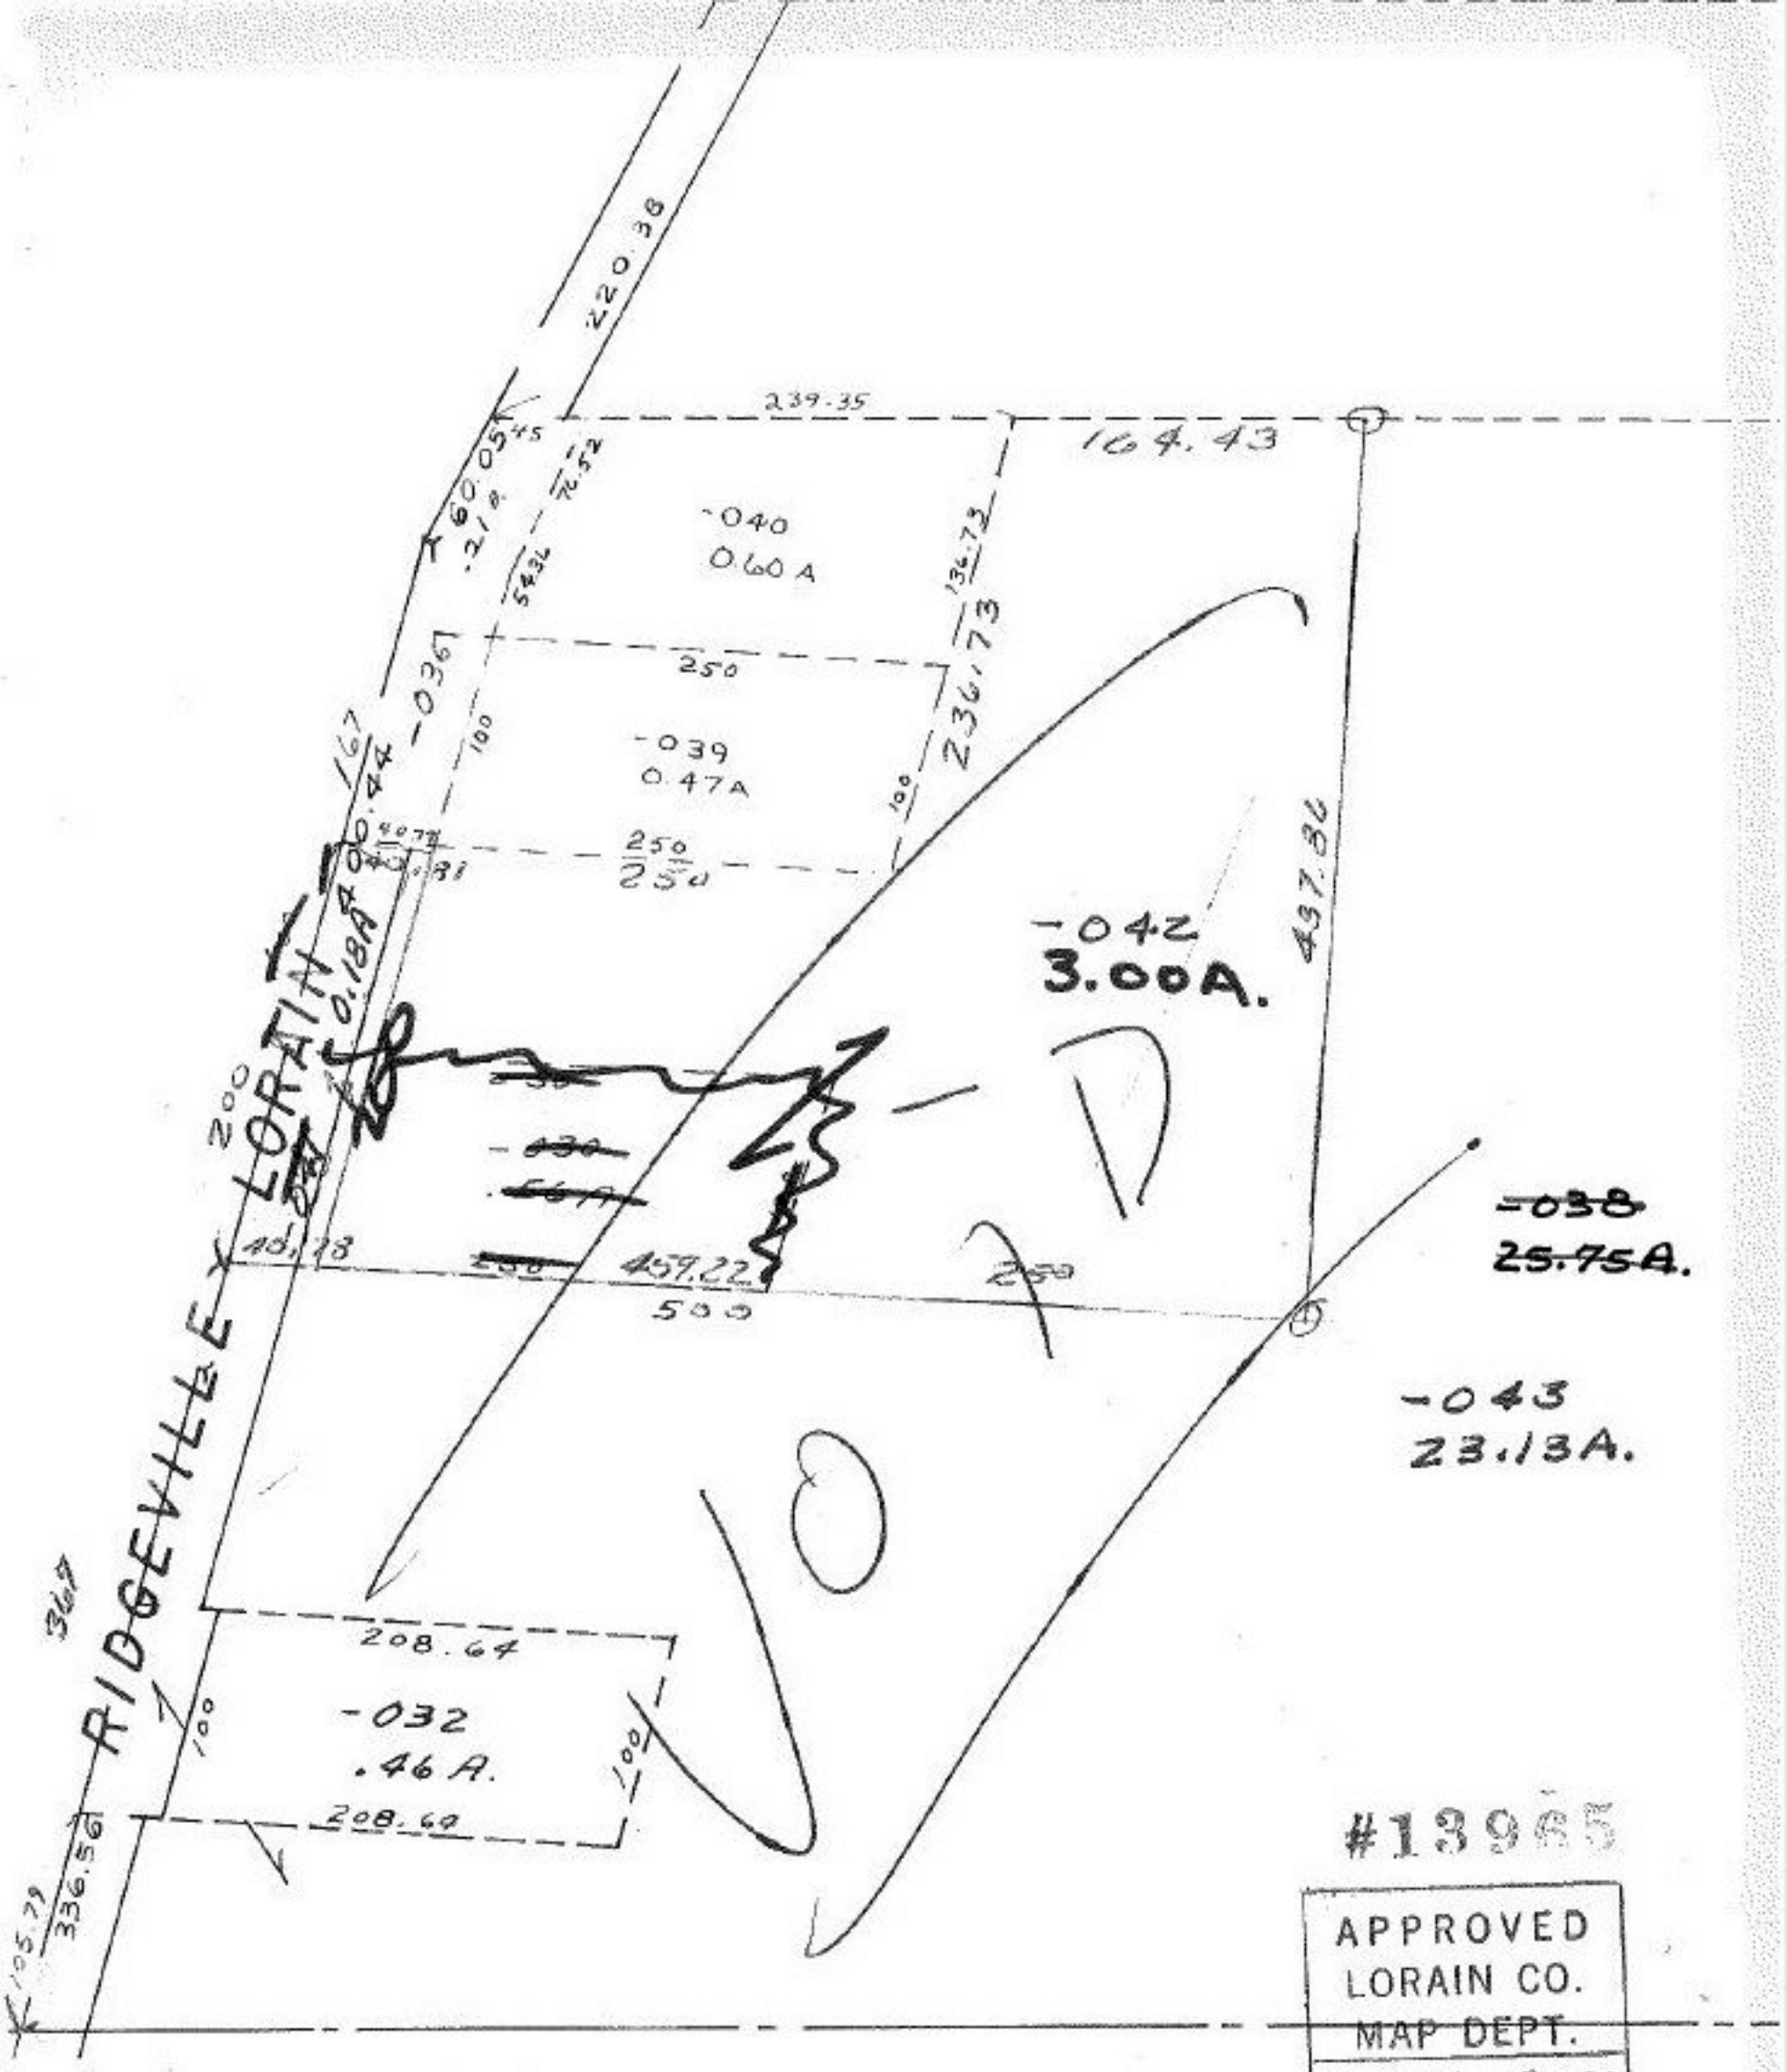

#13965

APPROVED
LORAIN CO.
MAP DEPT.
DATE 4-9-81
PAGE 4-00-011-H
BY Carolyn A
VOID AFTER