#13973

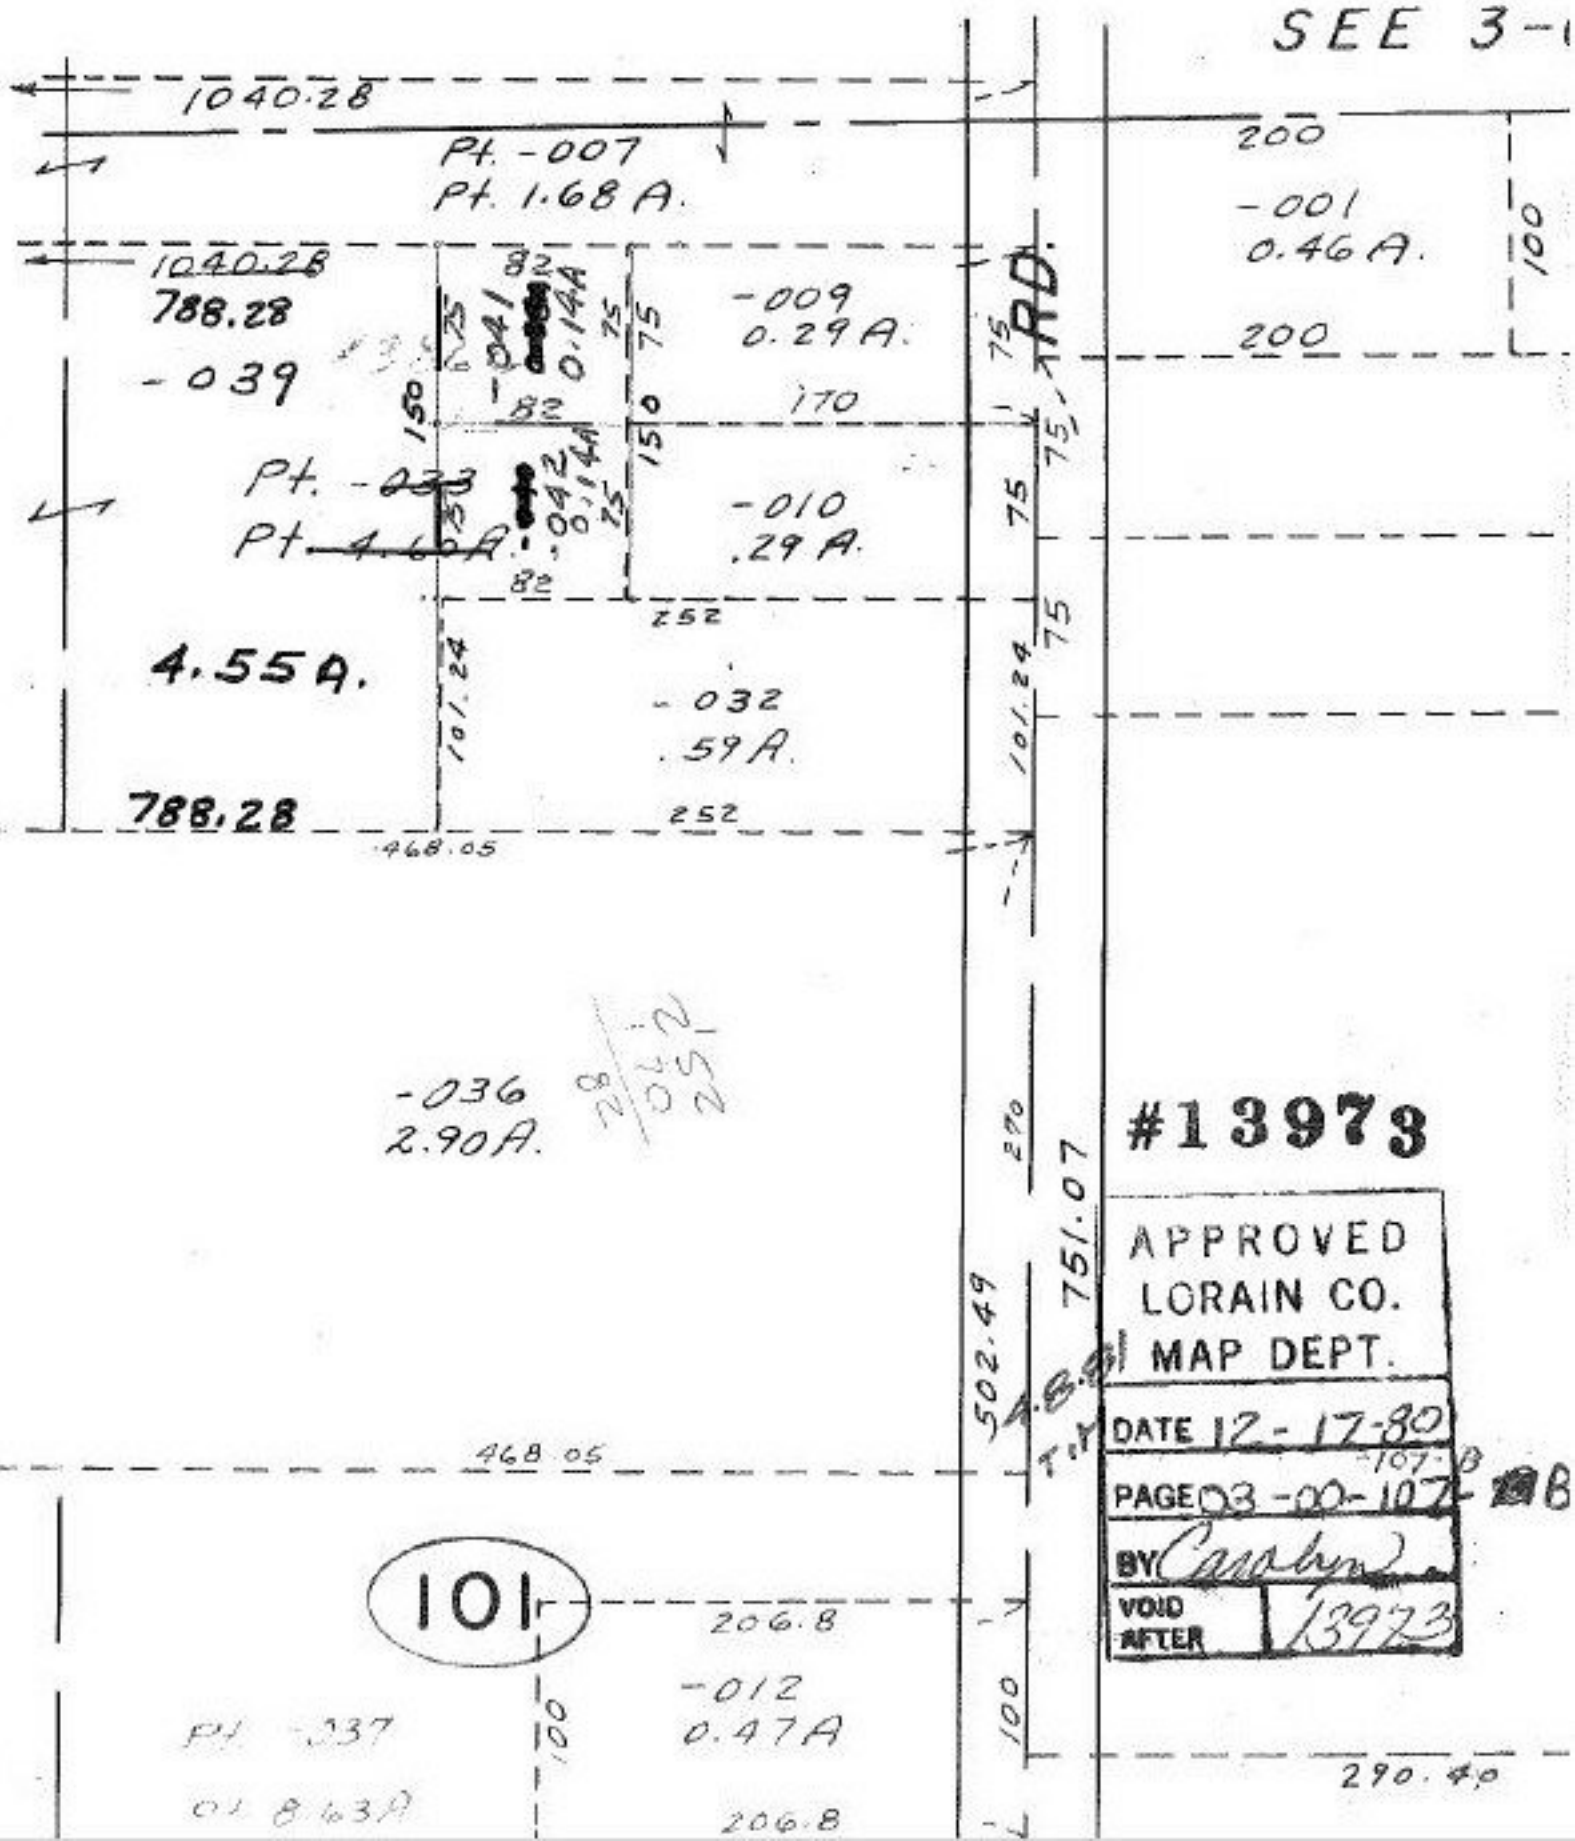
SEE 3-
1040.28
Pt. -007
Pt. 1.68 A.
200
-001
0.46 A.
100
1040.28
788.28
-039
-041
0.14A
-009
0.29 A.
200
170
Pt. -033
Pt. 4.60 A.
-042
0.14A
-010
.29 A.
252
4.55 A.
101.24
-032
.59 A.
101.24
788.28
252
468.05
-036
2.90 A.
270
270
751.07
502.49
468.05
101
206.8
-012
0.47 A
100
100
290.40
206.8
RD.
#13973
APPROVED
LORAIN CO.
MAP DEPT.
DATE 12-17-80
PAGE 03-00-107-B
BY Carolyn
VOID AFTER 13973